


Plat of Survey

Of Parcel "2", located in Block 23, Interlaken Subdivision, Maps 3 and 4, Section 11, Town 3 North, Range 16 East, Town of Sugar Creek, Walworth County, Wisconsin.

Description: Lots 9, 10, 26, and 27 of Block 23, Map 3 of Interlaken, a subdivision located in Section 11, Town 3 North, Range 16 East, Walworth County, Wisconsin.

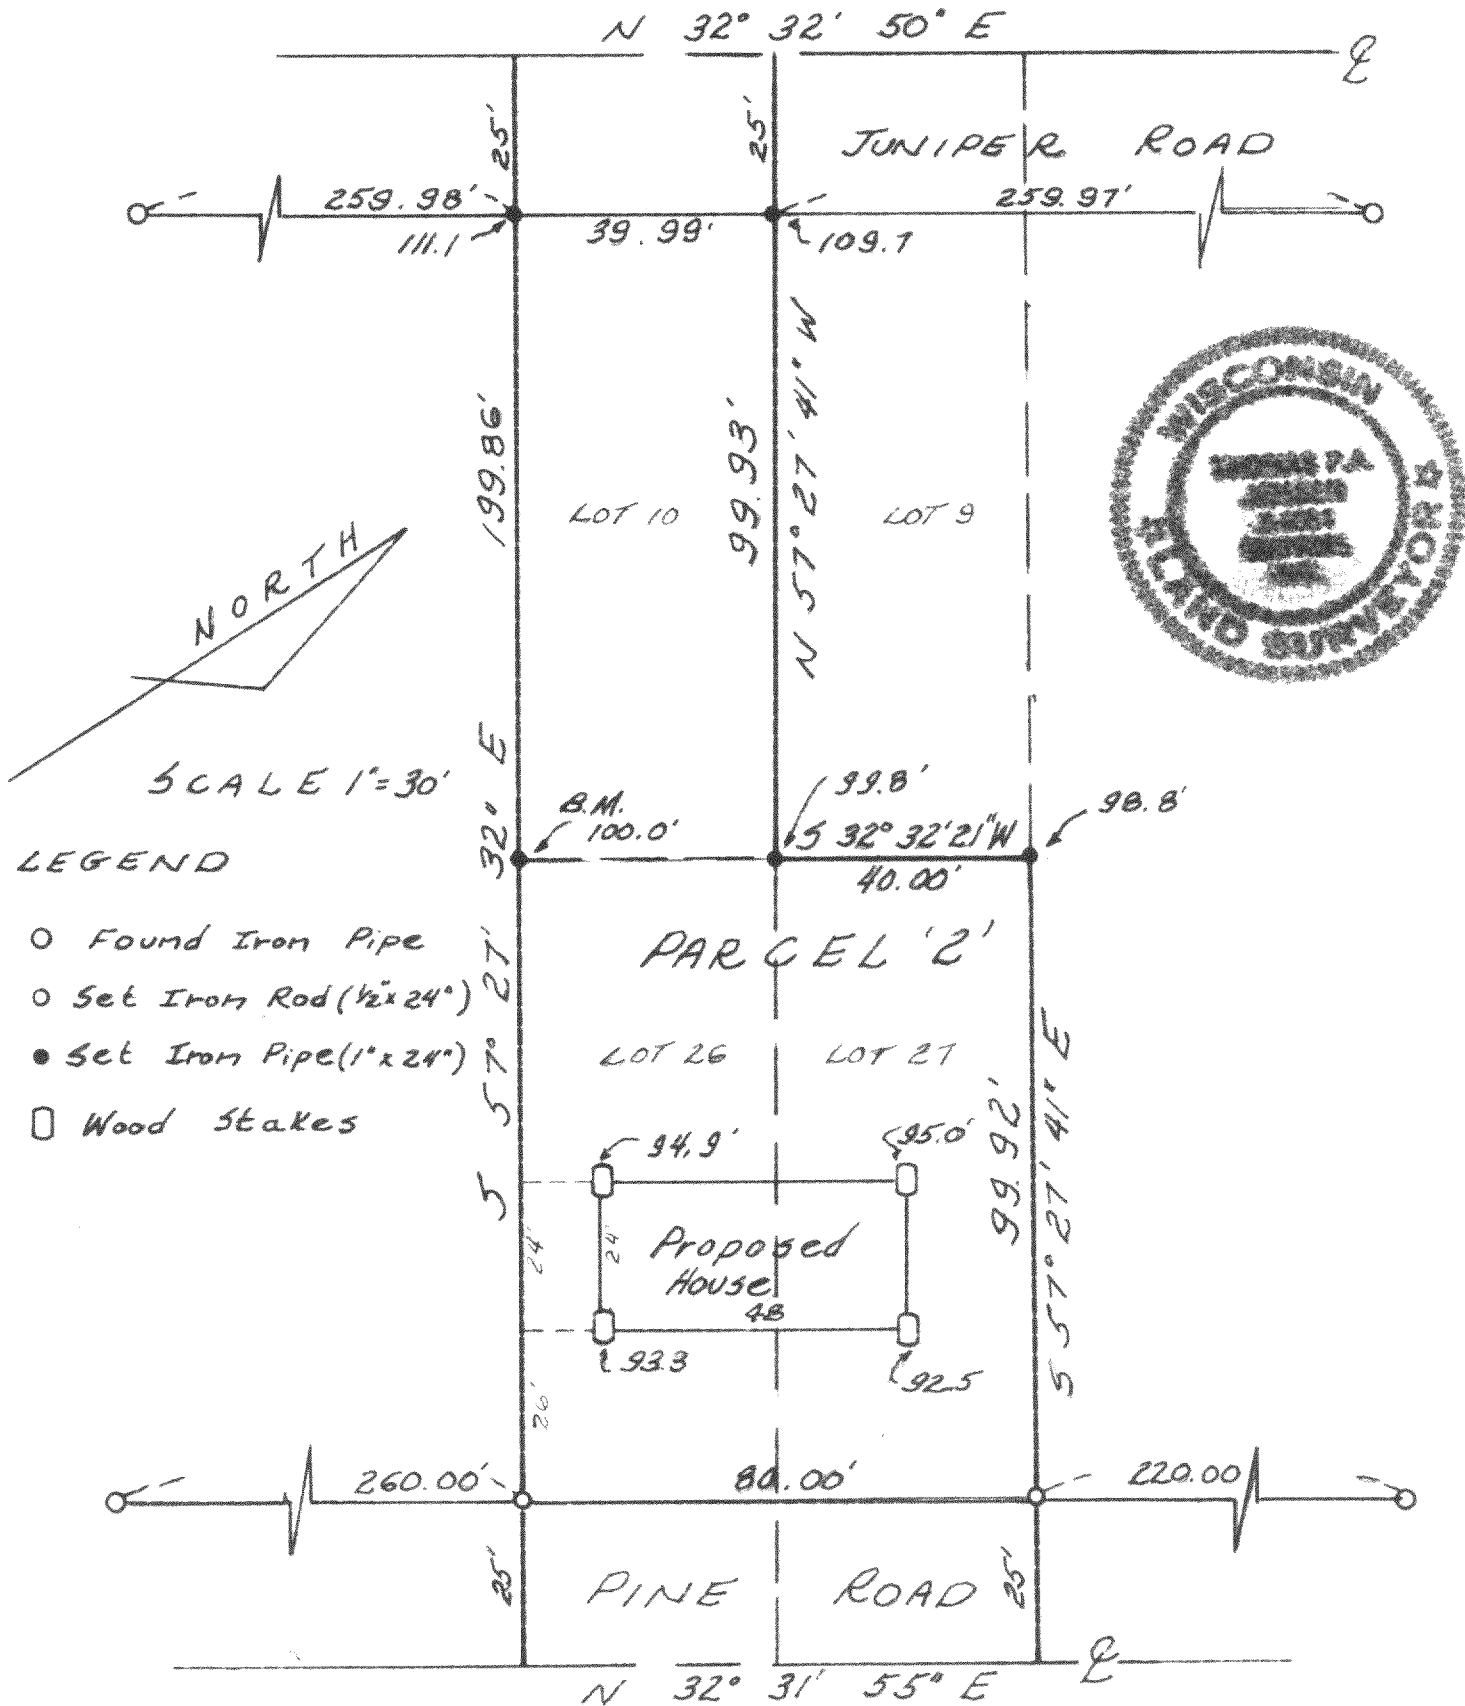

I hereby certify that I have surveyed the above described land and that the plat hereon shown is a correct representation of said survey.

Thomas P. J. Simonson
 Thomas P. J. Simonson
 Surveyor
 Elkhorn, Wisconsin 53121

Simonson Realty
 Simonson Realty
 July 1, 1991

GS-286A 286B, 292, 293
 GI-286E GI-291D
 LOT 10 26+27

316-279 J ✓