

FARRIS, HANSEN & COOPER, INC.


ENGINEERING, SURVEYING AND LAND PLANNING
715 W. WALWORTH ST. - P.O. Box 487 - ELKHORN, WI 53121

SELLER: HUGH BLAIR

BUYER: DUANE NOVAK

ORDERED BY: AL ROCKWELL

NOTE: THE NORTHERLY RIGHT-OF-WAY LINE OF PLANTATION ROAD IS ASSUMED TO BEAR S 76°28'E AS PLATTED.

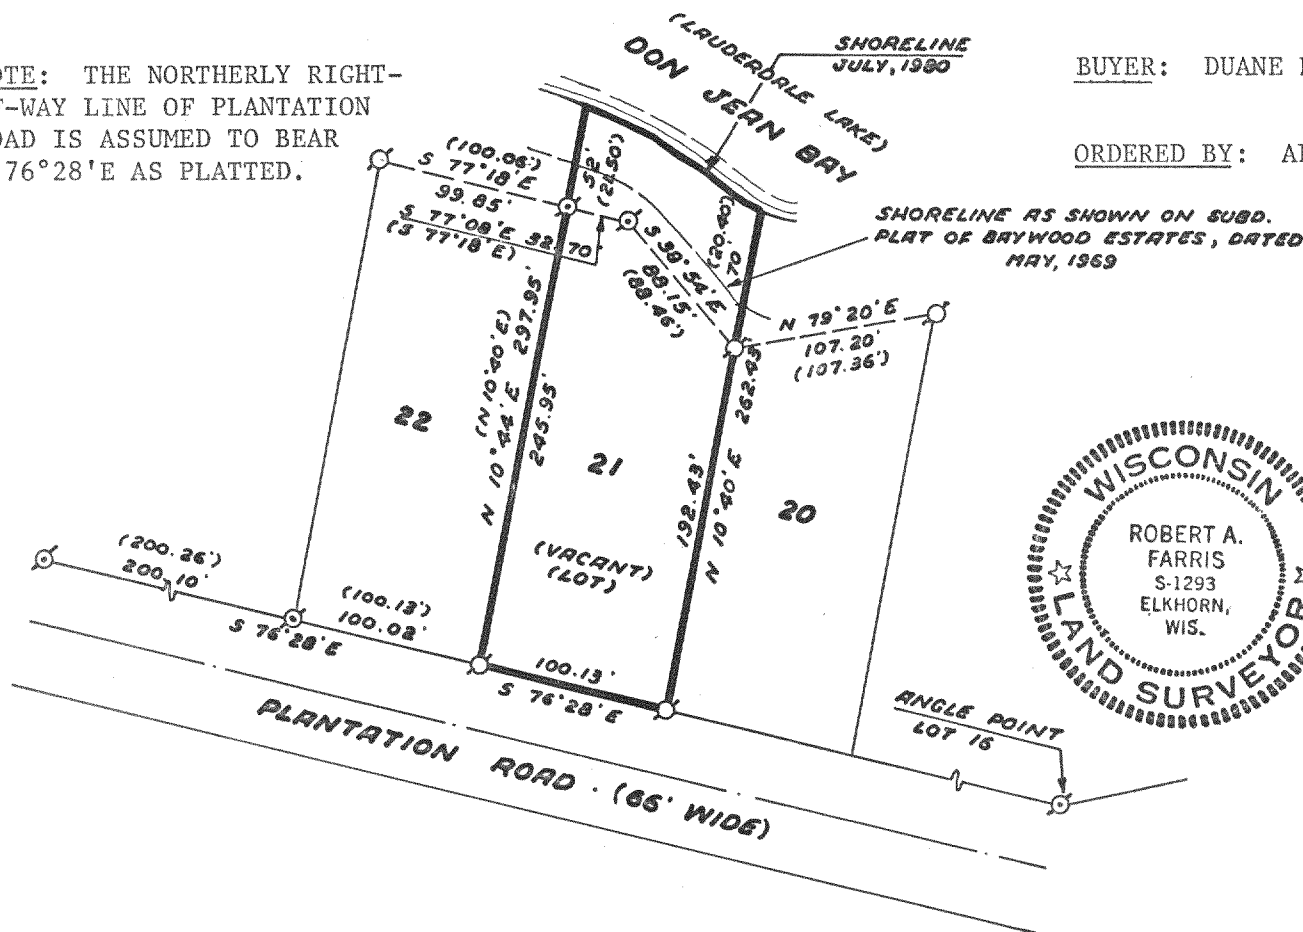

PLAT OF SURVEY OF

LOT 21, BAYWOOD ESTATES, SECTION 2, TOWN 3 NORTH, RANGE 16 EAST, WALWORTH COUNTY, WISCONSIN.

LEGEND

- ⊙- 1 1/2" DIA. IRON PIPE SURVEY STAKE FOUND
- ⊙- 1 1/4" DIA. IRON PIPE SURVEY STAKE FOUND
- () - RECORD DIMENSION

I HEREBY CERTIFY that I have surveyed the property described hereon and that this Plat of Survey is a true and accurate representation of the lot lines to the best of my professional knowledge and belief.

Robert A. Farris

Robert A. Farris, RLS No. 1293

Dated this 1st day of July, 1980.

0 50 100
SCALE IN FEET
1"=100'

PROJECT NO. 1718

GBE-21

316-300F