
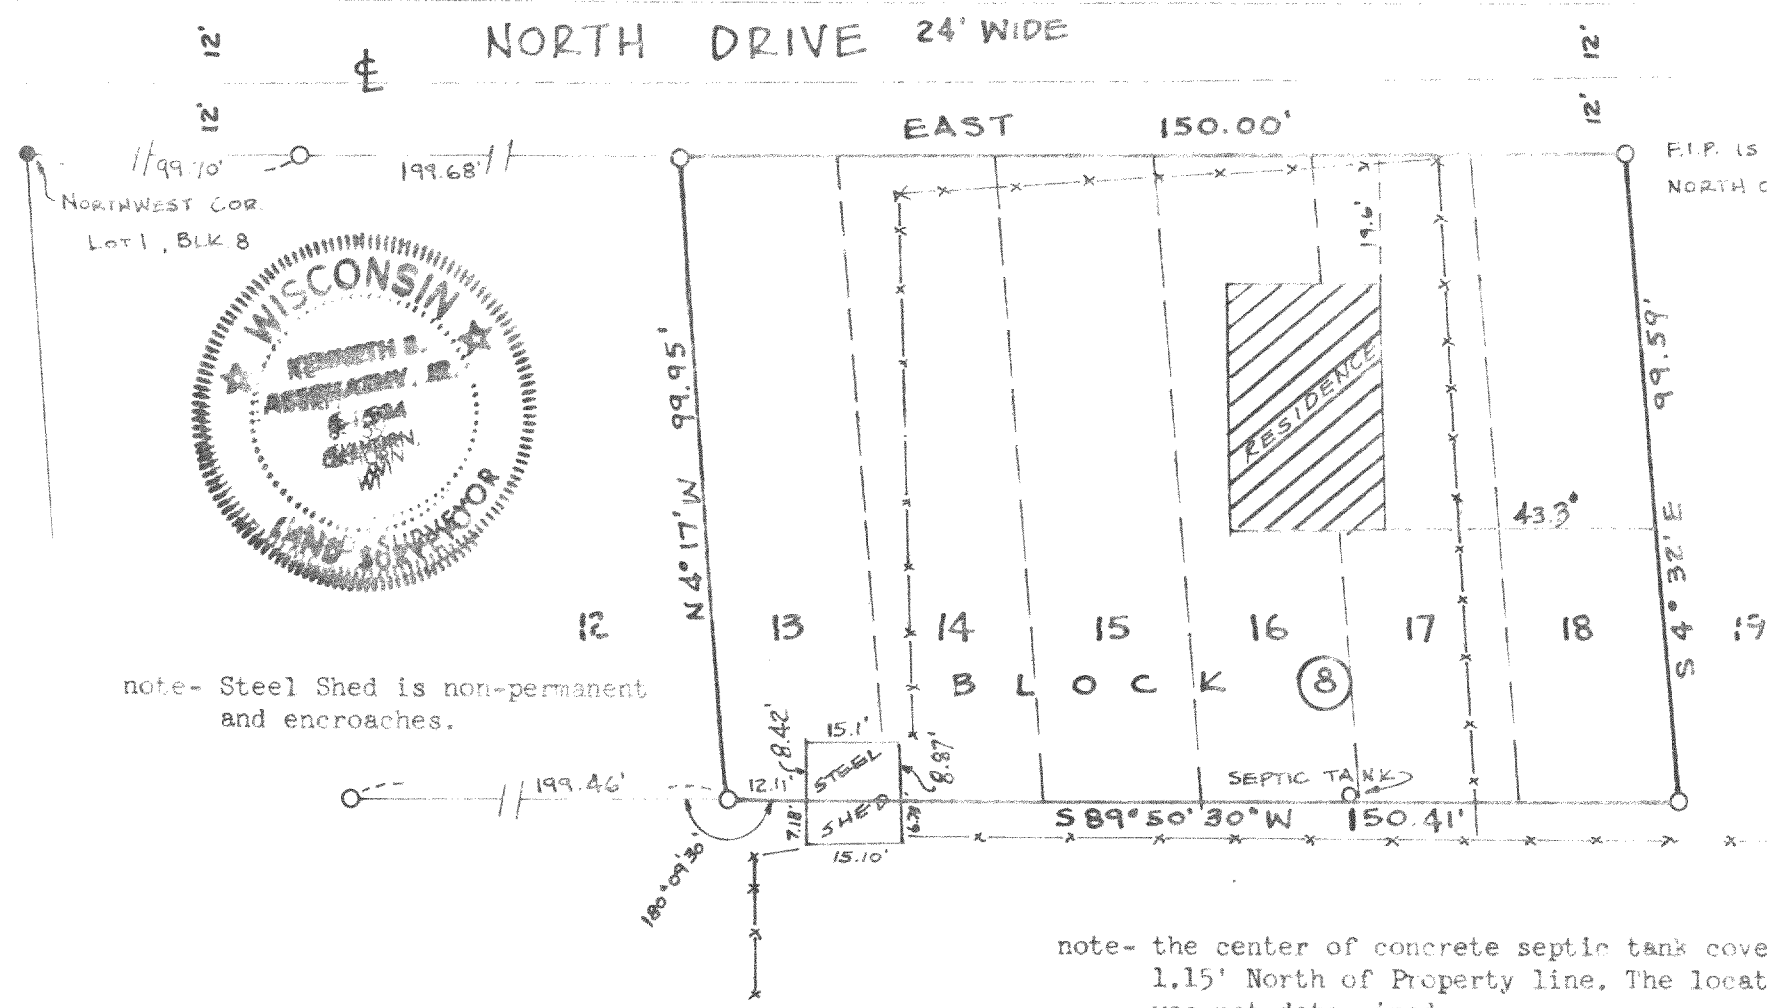


OWNERS- Robert H. and Christine E.
 Miller
 P.O. Box 608
 Lake Geneva, Wis. 53147

PLAT OF SURVEY
 LOTS 13-18 INCLUSIVE OF BLOCK 8 OF LAKE WANDAWEGA SUBDIVISION
 LOCATED IN SECTION 2, TOWN 3 NORTH, RANGE 16 EAST, TOWN OF
 SUGAR CREEK, WALWORTH COUNTY, WISCONSIN.

Note- Subdivision is recorded in Vol. 8 P. 25 of Plats
 Cab. 1 Slide 98, Register of Deeds, Walworth Cnty.

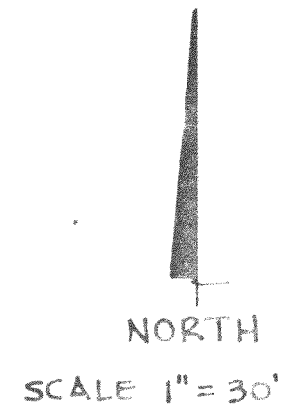

LEGEND

- - 3/4" dia. iron rod found
- - 1 1/2" dia. iron pipe found
- x---x---x--- Existing Fence

I hereby certify that, I have surveyed the above described property, that the plat shown hereon is an accurate survey, a true representation thereof, correctly shows the exterior boundaries and the correct measurements thereof, and correctly shows the improvements thereon, to the best of my professional knowledge and belief.

Kenneth B. Abernathy Jr.
 Kenneth B. Abernathy Jr.
 Wis. Reg. No. S-1594
 7/21/84