

Work ordered by: Hopkins Savings & Loan
for; William Engles


Farris, Hansen & Associates, Inc.

Engineering, Surveying & Land Planning

P.O. BOX 487

715 W. WALWORTH STREET

ELKHORN, WISCONSIN 53121

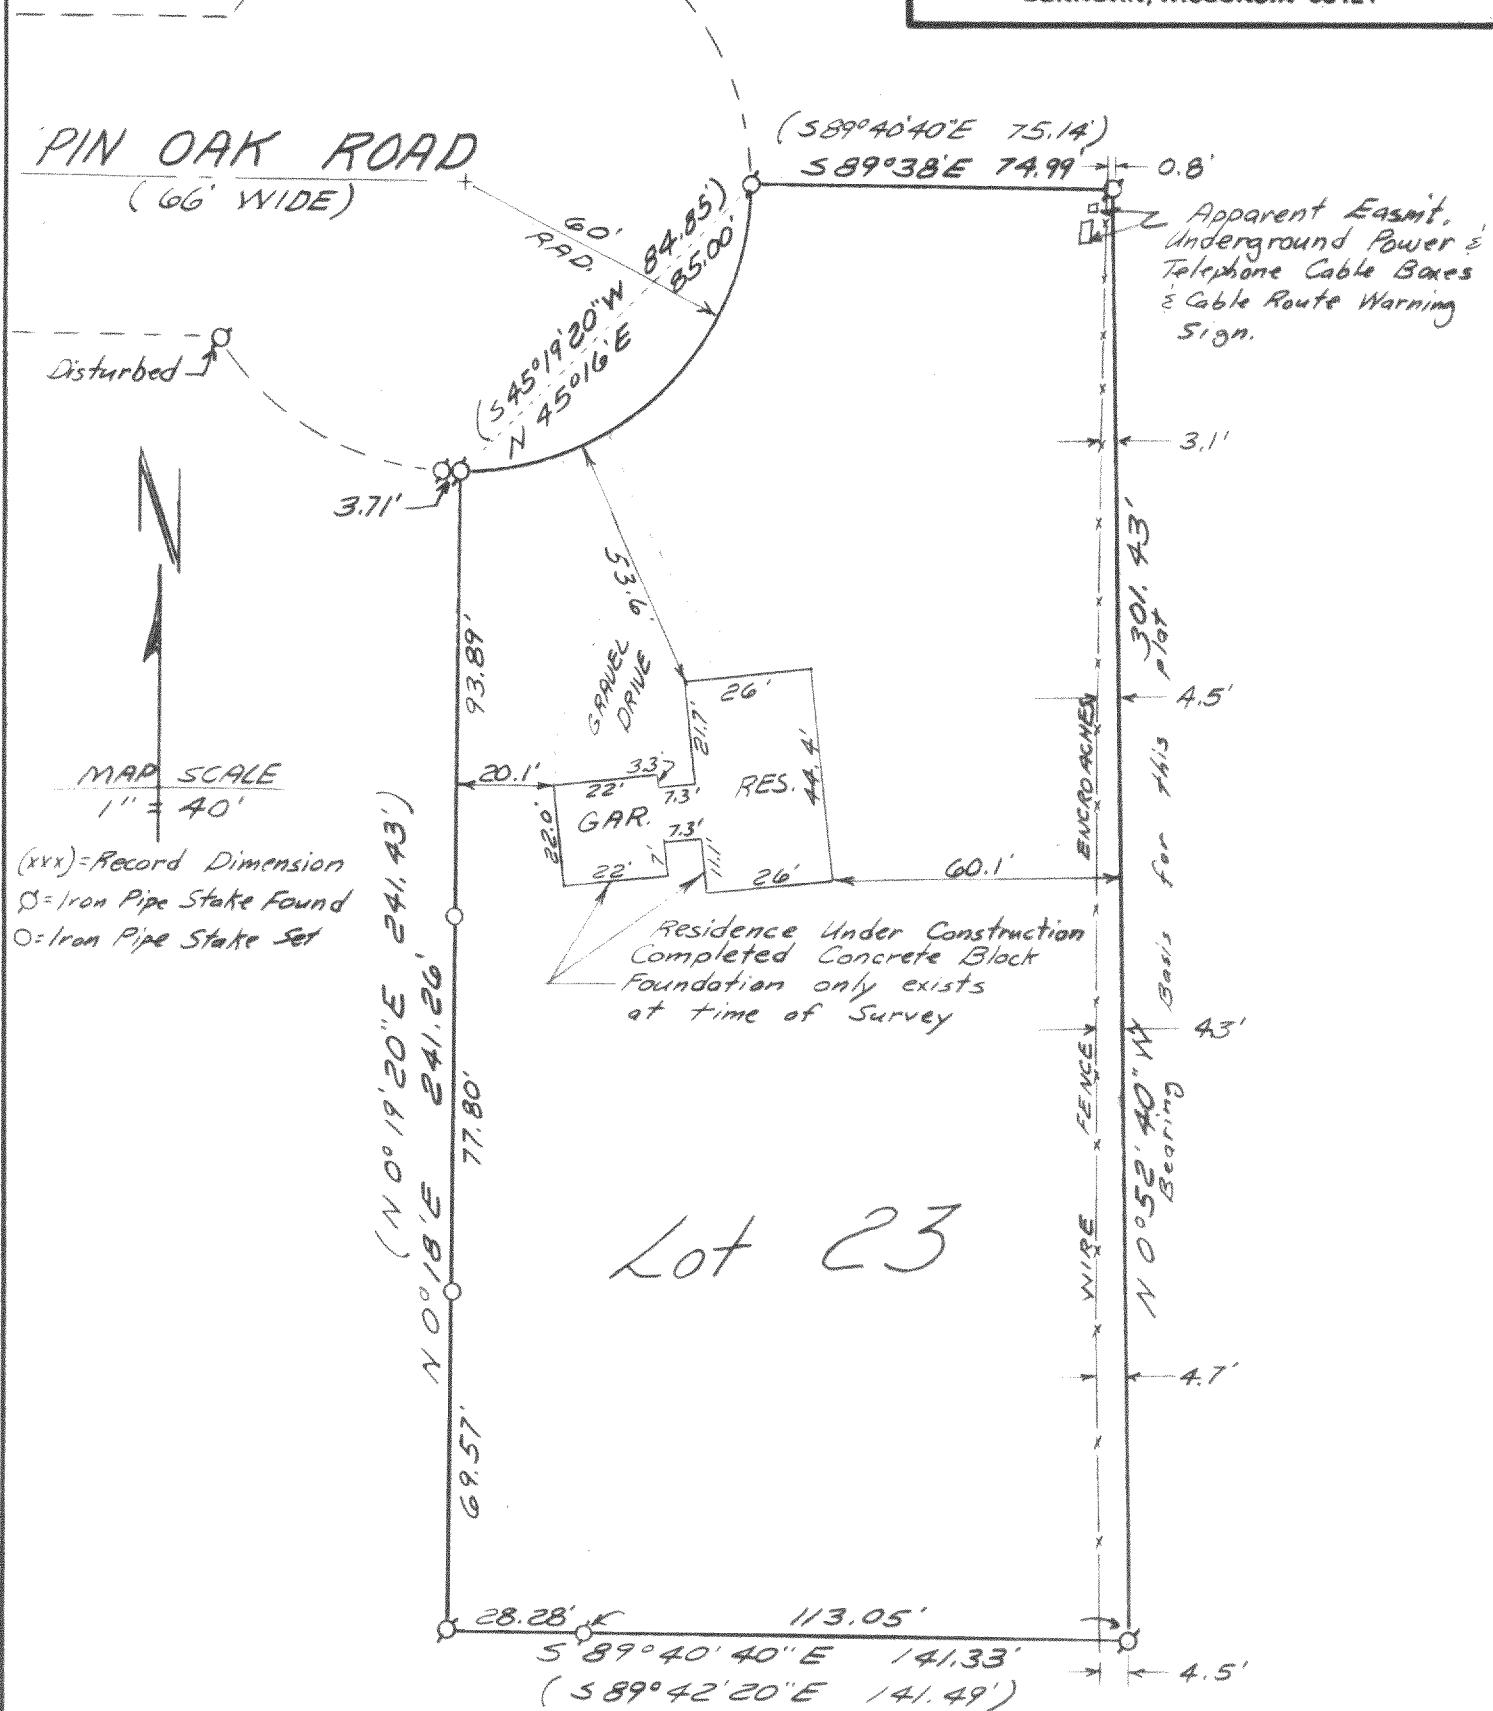


PLAT OF SURVEY - LOT 23 SYLVAN TERRACE SUBDIVISION
SEC. 2, T. 3 N., R. 16 EAST, WALWORTH CO., WIS.

I hereby certify that I have surveyed the above described property and that the above map is a true representation thereof and shows the size and location of the property, its exterior boundaries, the location of all visible structures and dimensions of all principal buildings thereon, boundary fences, apparent easements, roadways and visible encroachments, if any.

This survey is made for the use of the present owners of the property, and also those who purchase, mortgage, or guarantee the title thereto within one (1) year from date hereof.

Robert A. Farris

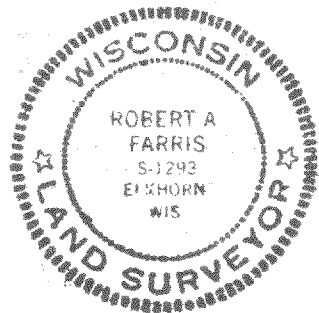

DATE 30 MAY 1983

PROJ. # 2262

65T-23

316-321