


NOTE: POINTS A-B-C-D-E
ARE ON A STRAIGHT LINE.

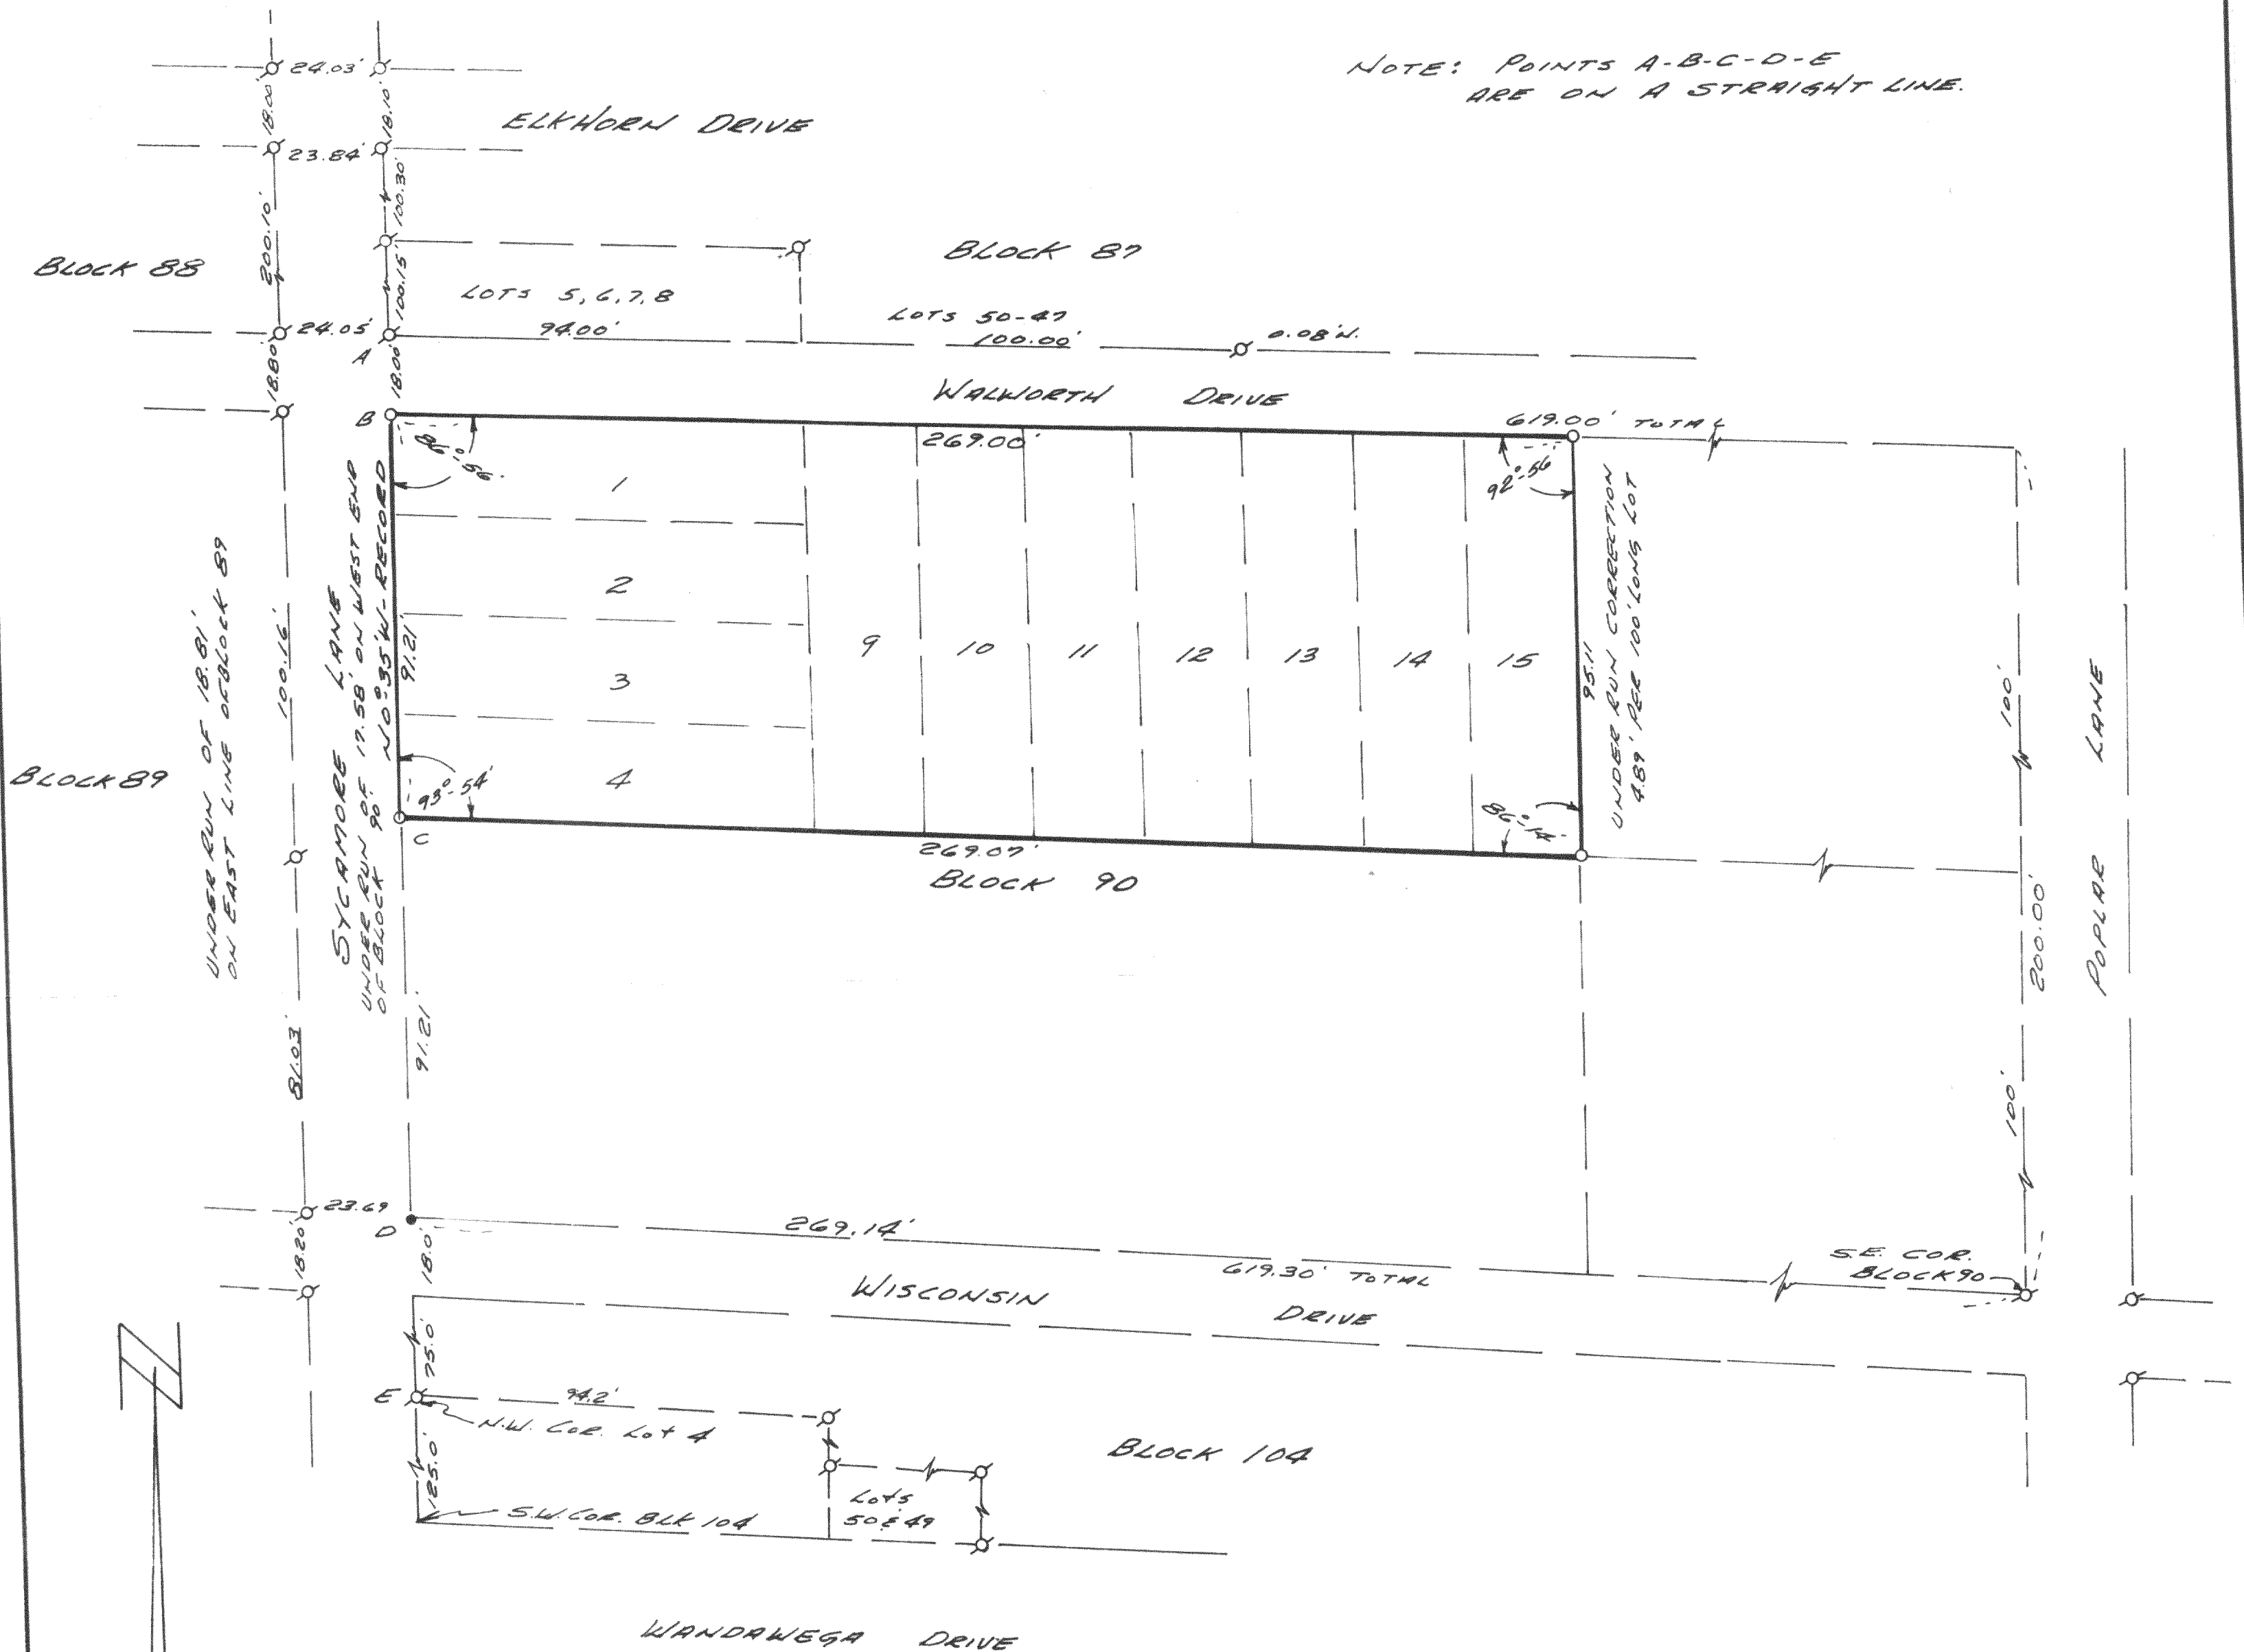

PLAT OF SURVEY OF


LOTS 1, 2, 3, 4, 9, 10, 11, 12, 13, 14, 15 BLOCK 90
OF LAKE WANDAWEGA SUBD. LOCATED
IN SECTION 2, T3N R1E, WAL. CO. WIS.

Lloyd L. Jensen
SURVEYOR

SCALE 1" = 30'

DATE JULY 1971

- ⊗ IRON PIPE FOUND
- IRON PIPE SET
- IRON ROD SET

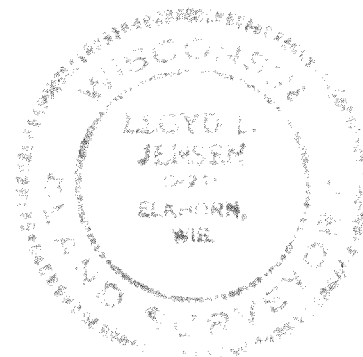

GLW-149, 150, 151, 152, 153

316-38.1