


WALWORTH COUNTY
SURVEYING & MAPPING
LAKE GENEVA, WISCONSIN

PLAT OF SURVEY OF

LOT 3, BLOCK 11 OF COOL HILL PARK
ADDITION NO. 2, LOCATED IN SECTION
3, T 3 N, R 16 E, WALWORTH COUNTY,
WISCONSIN.

NINE INDIANS TRAIL

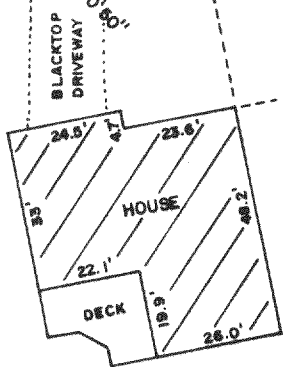

2


3

11

BLOCK

4

ORDERED BY: LAKESHORE REAL ESTATE
101 BROAD STREET
LAKE GENEVA, WI

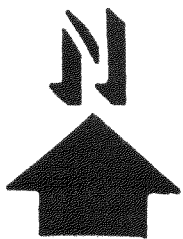

SCALE: 1"=30'

⊙ - IRON PIPE FOUND
⊙ - IRON ROD FOUND
() - RECORDED AS

I, ROBERT M. BAERENWALD, DO HEREBY CERTIFY THAT I
HAVE SURVEYED THE PROPERTY HEREON DESCRIBED ACCORDING
TO THE OFFICIAL RECORDS AND THAT THE PLAT HEREON IS A
CORRECT REPRESENTATION OF THE PROPERTY LINES TO THE
BEST OF MY KNOWLEDGE AND BELIEF.

Robert M. Baerenwald
ROBERT M. BAERENWALD
WISCONSIN REGISTERED LAND SURVEYOR, S-1508

DATE *June 1, 1987* JOB NO. 1081

NOTE: THIS IS NOT A CERTIFIED COPY UNLESS SEALED.