


WALWORTH COUNTY
SURVEYING & MAPPING
LAKE GENEVA, WISCONSIN


NOTE: IRON PIPE WAS UNDER
WATER ON DATE OF SURVEY

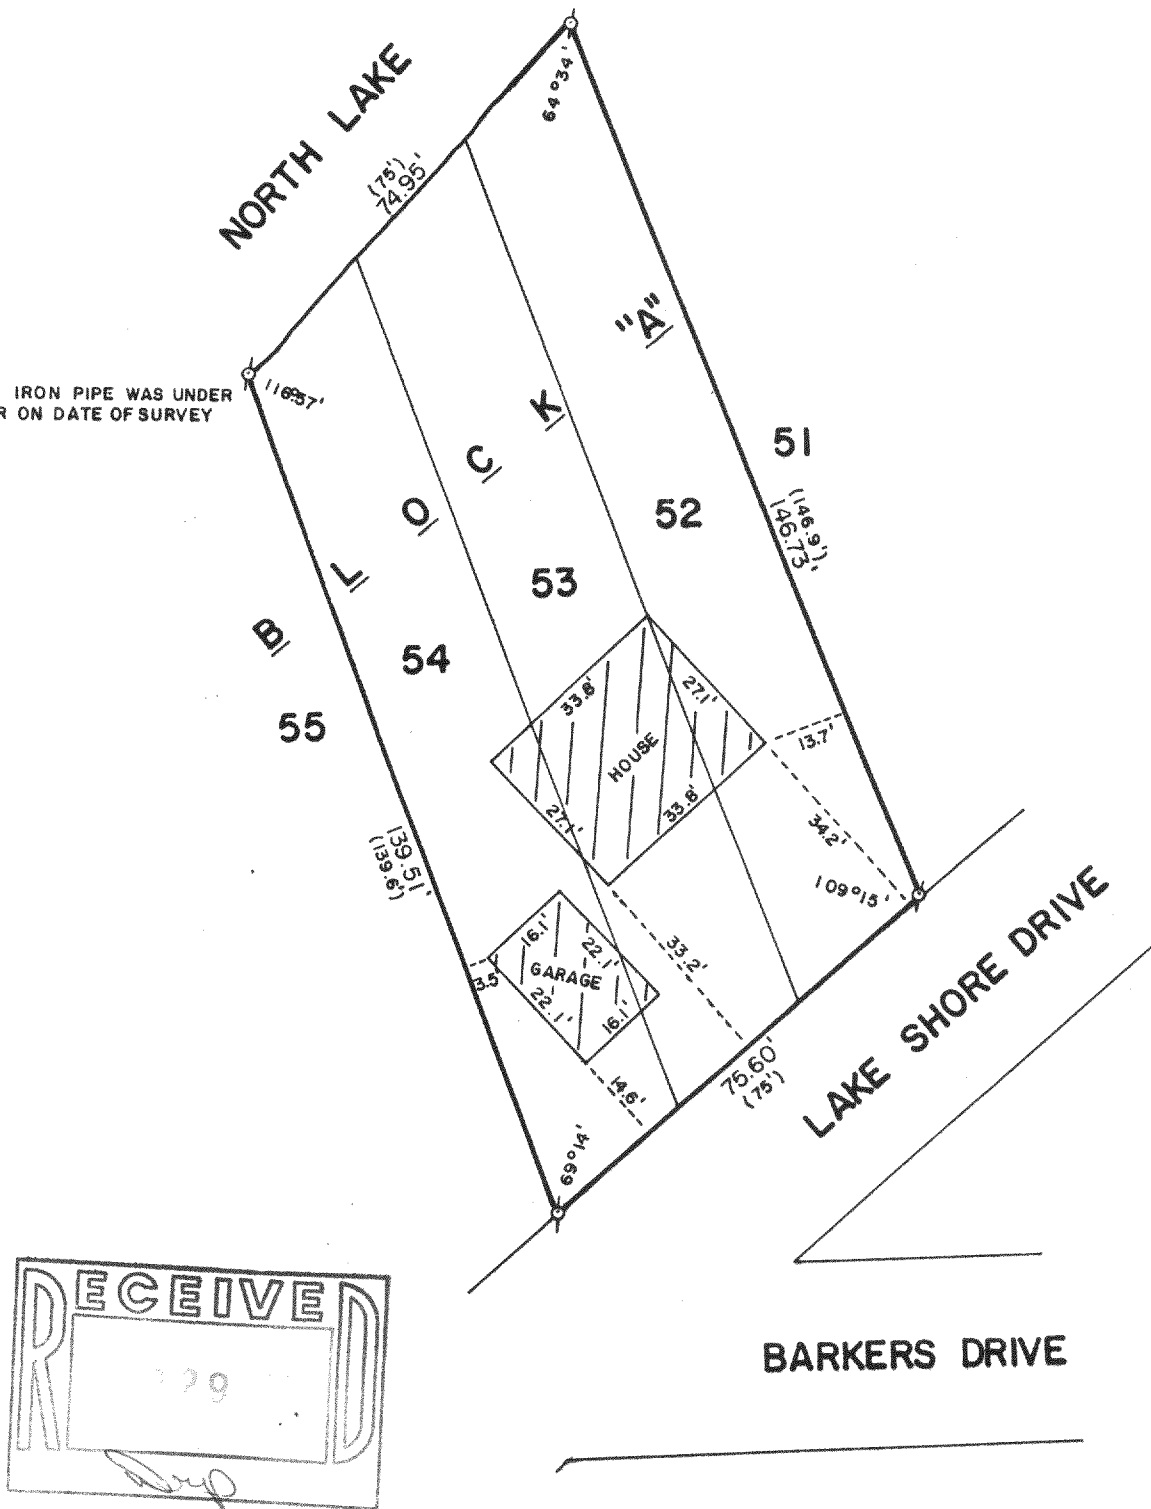

PLAT OF SURVEY OF

LOTS 52, 53 AND 54, BLOCK "A" OF NORTH
LAKE BEACH TRACT 3 AS FOUND TO BE
MONUMENTED, LOCATED IN T 3 N, R 16 E,
WALWORTH COUNTY, WISCONSIN..

ORDERED BY: KEEFE REAL ESTATE
704 MAIN STREET
LAKE GENEVA, WISCONSIN 53147

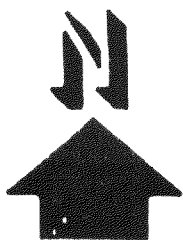

SCALE: 1"=30'

Ø - IRON PIPE FOUND
() - RECORDED AS

I, ROBERT M. BAERENWALD, DO HEREBY CERTIFY THAT I
HAVE SURVEYED THE PROPERTY HEREON DESCRIBED ACCORDING
TO THE OFFICIAL RECORDS AND THAT THE PLAT HEREON IS A
CORRECT REPRESENTATION OF THE PROPERTY LINES TO THE
BEST OF MY KNOWLEDGE AND BELIEF.

Robert M. Baerenwald
ROBERT M. BAERENWALD
WISCONSIN REGISTERED LAND SURVEYOR, S-1508

Aug. 14, 1987
DATE JOB NO. 1151

NOTE: THIS IS NOT A CERTIFIED COPY UNLESS SEALED.