



ABELL
SURVEYING & MAPPING
DELAVER, WISCONSIN 53115
414-728-6737

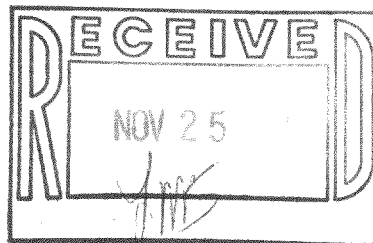

STREET

SYCAMORE

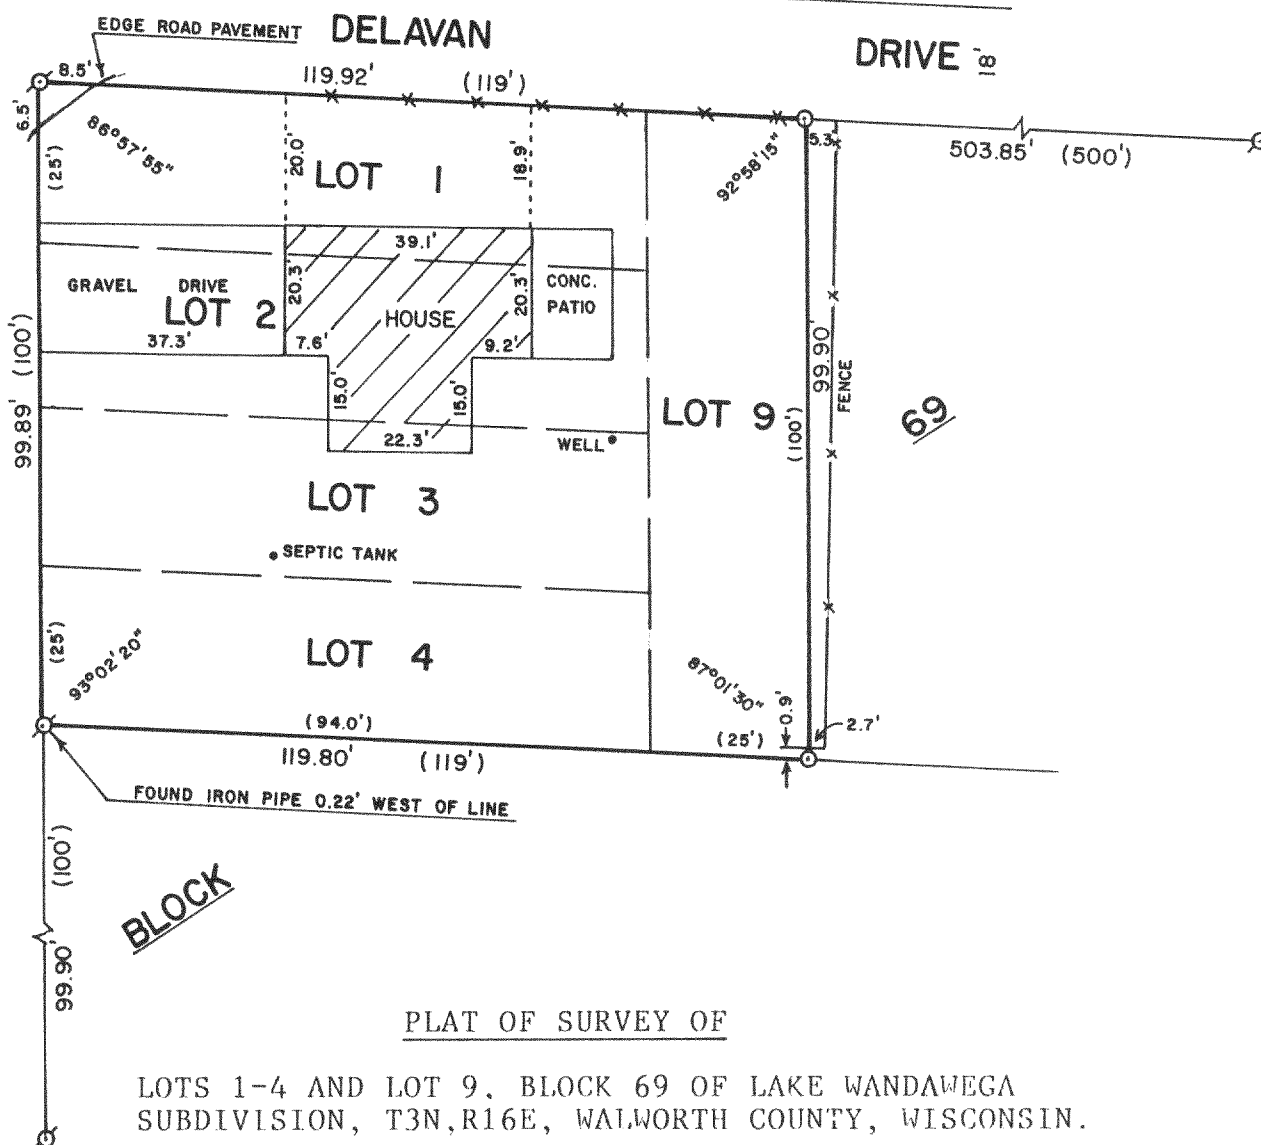

PLAT OF SURVEY OF

LOTS 1-4 AND LOT 9, BLOCK 69 OF LAKE WANDAWEGA
SUBDIVISION, T3N, R16E, WAUKESHA COUNTY, WISCONSIN.

ORDERED BY: THE RACER'S EDGE REALTY
ROUTE 2, BOX 236
DELAVER, WI. 53115



SCALE - 1"=30'

LEGEND

- ⊗ - IRON PIPE FOUND
- - IRON ROD SET
- () - RECORDED AS

I, DAVID F. ABELL, DO HEREBY CERTIFY
THAT I HAVE SURVEYED THE PROPERTY
HEREON DESCRIBED ACCORDING TO THE
OFFICIAL RECORDS AND THAT THE PLAT
HEREON IS A CORRECT REPRESENTATION
OF THE PROPERTY LINES TO THE BEST OF
MY KNOWLEDGE AND BELIEF.

David F. Abell

DAVID F. ABELL
WISCONSIN REGISTERED LAND SURVEYOR, S-1596

October 28, 1987

DATE JOB NUMBER - 87169

NOTE: THIS IS NOT A CERTIFIED COPY UNLESS SEALED.