



PLAT OF SURVEY OF LOT 6, PINEHURST SUBDIVISION,
BEING LOCATED IN SECTION 23, T3N, R16E, WALWORTH
COUNTY WISCONSIN.

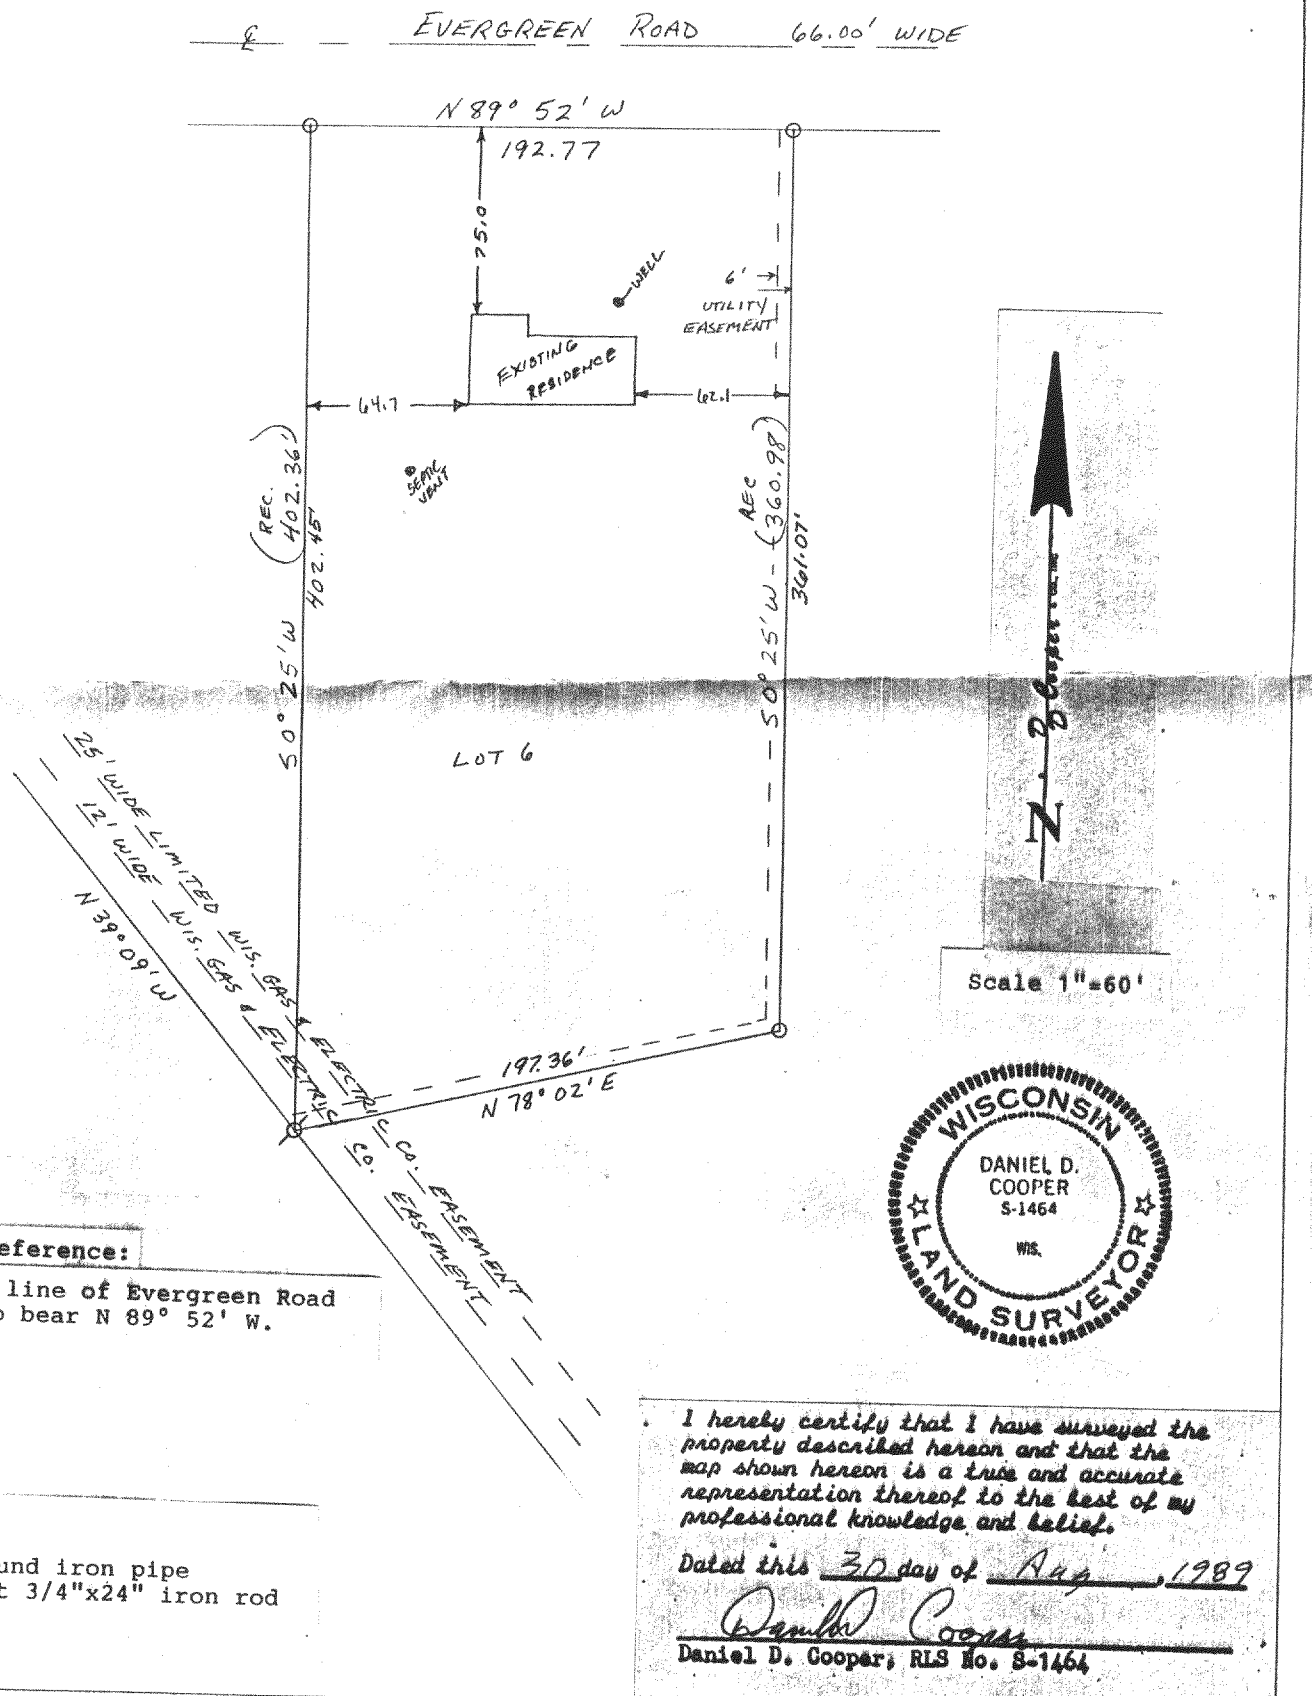

DRAWING No. 3510

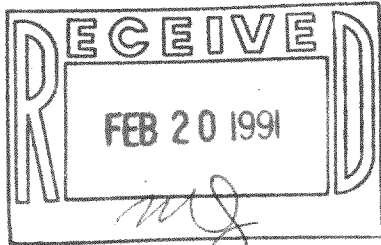

Reduced

TAX KEY # GPH 00004

316-475