
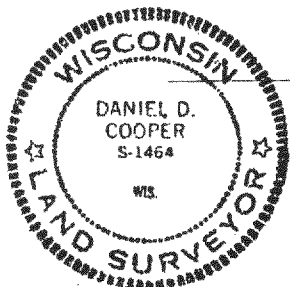


PLAT OF SURVEY OF LOT 20, SYLVAN TRACE SUBDIVISION,
LOCATED IN SECTION 2, T3N, R16E, WALWORTH COUNTY,
WISCONSIN.

Bearing Reference: Westerly
line of Lot assumed to
bear N00°07'10"W as recorded

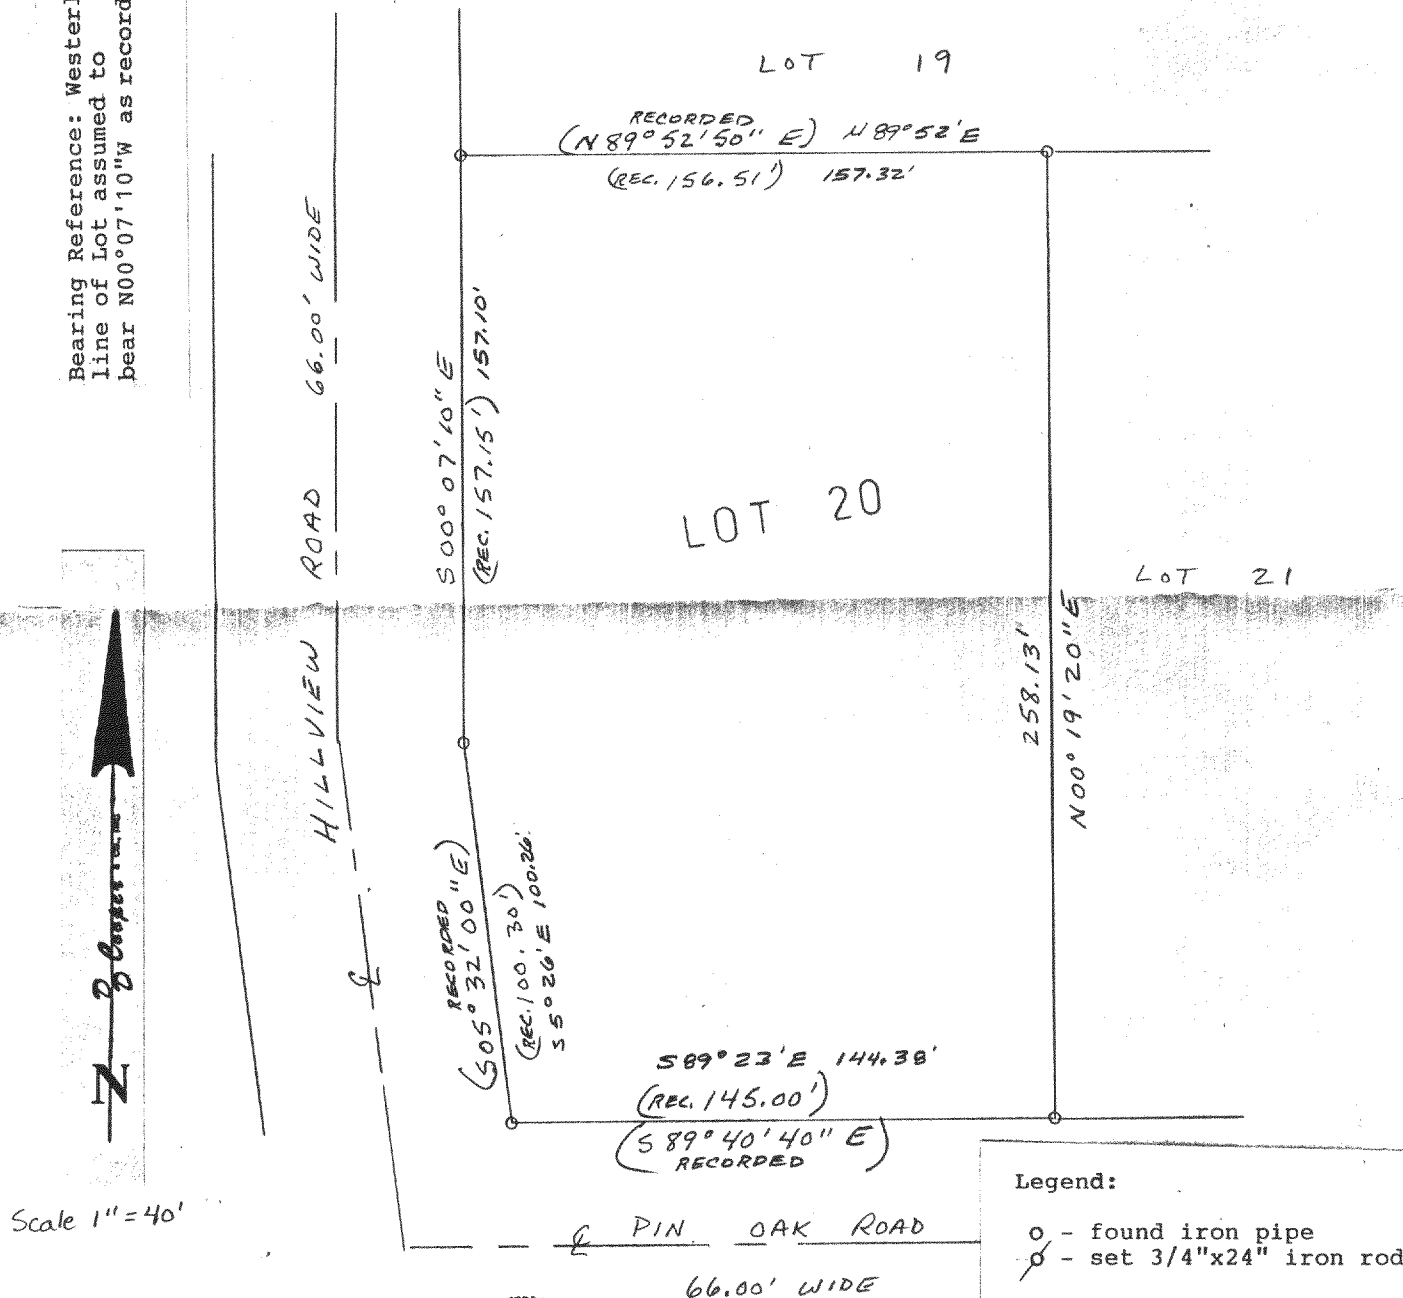


I hereby certify that I have surveyed the
property described hereon and that the
map shown hereon is a true and accurate
representation thereof to the best of my
professional knowledge and belief.

Dated this 13th day of October, 1989

Daniel D. Cooper
Daniel D. Cooper, RLS No. S-1464

DRAWING NO. 3535-19-52

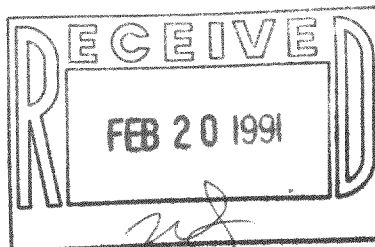

Reduced

Tax Key # GST 00020

316-478