


**ABELL
SURVEYING & MAPPING
DELAVER, WISCONSIN 53115
414-728-6737**

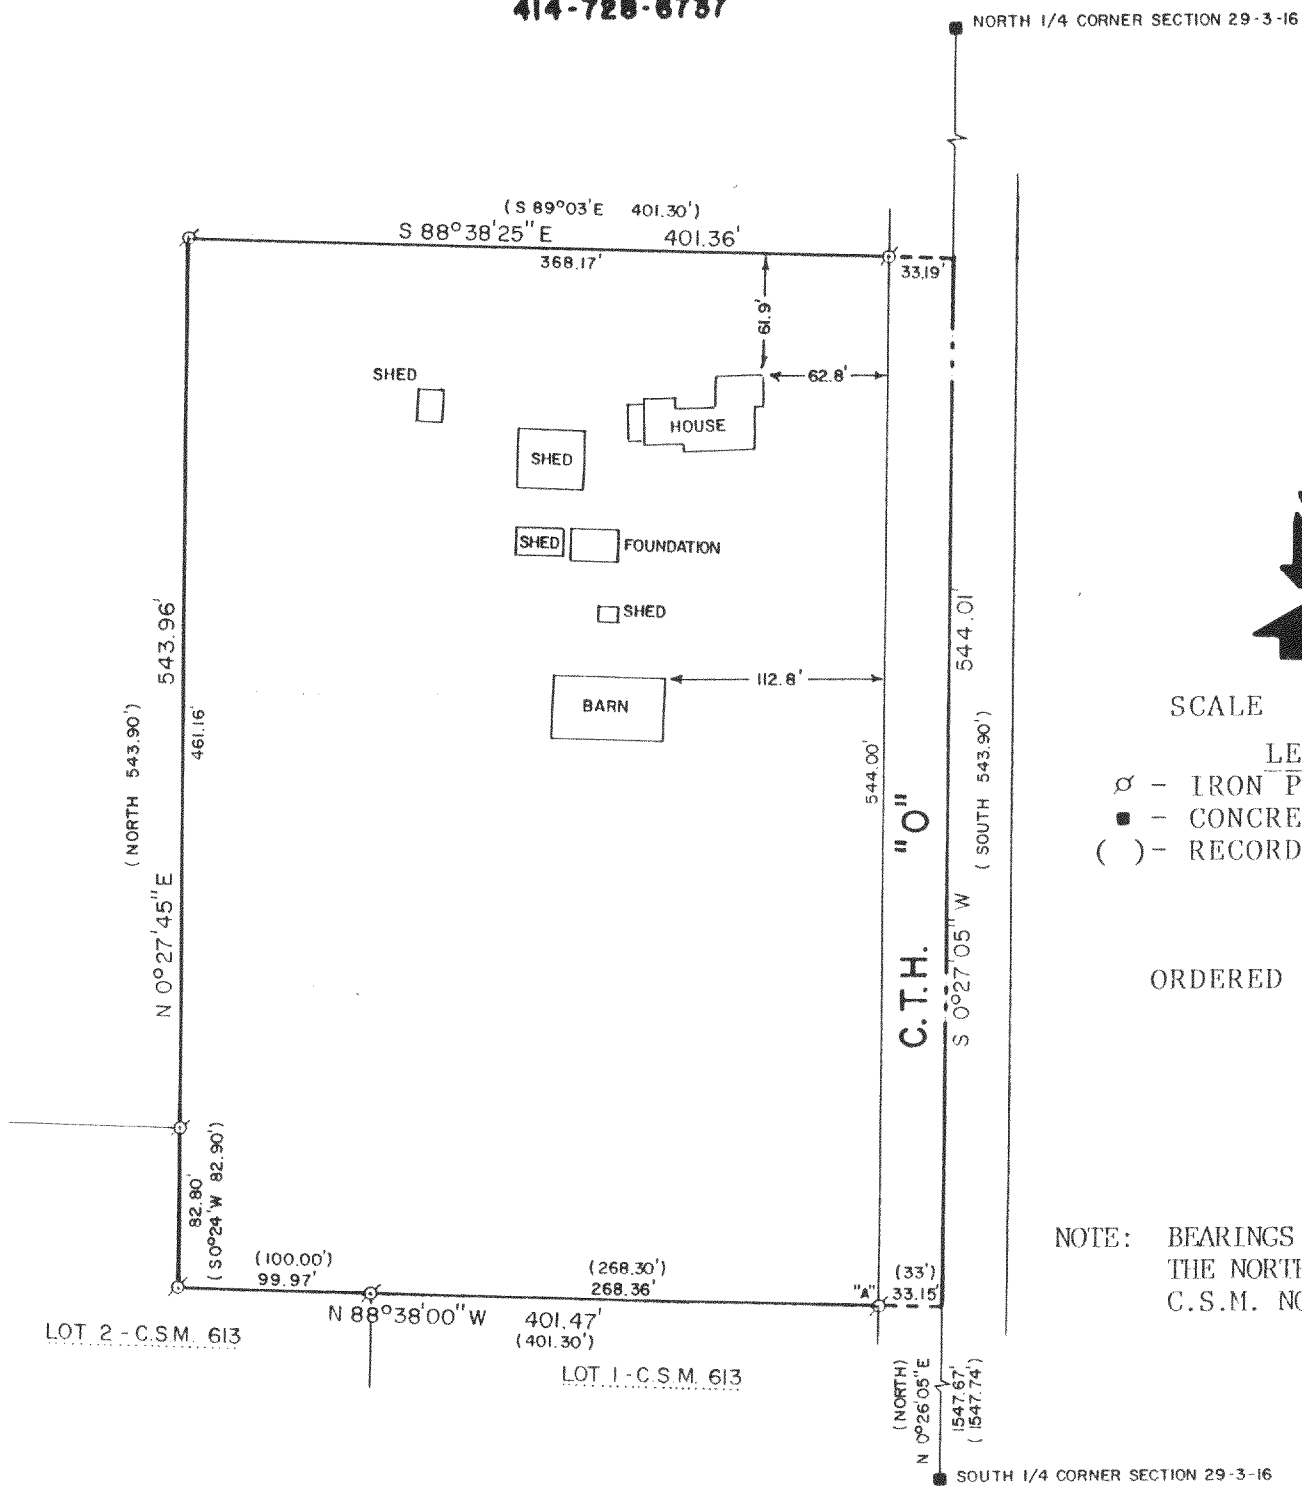

SCALE - 1"=100'

LEGEND

- ⊙ - IRON PIPE FOUND
- - CONCRETE MONUMENT FOUND
- () - RECORDED AS


ORDERED BY: LOU KREPEL
4119 CHERRY
RT. 4,
BOX 286
DELAVER, WI.
53115

NOTE: BEARINGS ARE REFERENCED TO
THE NORTH LINE OF LOT 1 OF
C.S.M. NO. 613 AS S 88°38' E.

PLAT OF SURVEY OF

A parcel of land located in the Southwest 1/4 of Section 29, T 3 N, R 16 E, Walworth County, Wisconsin, described as follows, to-wit: Commencing at the South 1/4 Section corner of said Section 29; thence North along the east line of said Southwest 1/4, 1547.74 feet to the place of beginning; thence N 89° 03' W along the north line of Lot 1 in Certified Survey No. 276, recorded in Volume 2 of Certified Surveys on page 31, Walworth County records, 401.30 feet; thence North parallel with the east line of said Southwest 1/4, 543.90 feet; thence S 89° 03' E, parallel with the north line of said Lot 1, 401.30 feet to the east line of said Southwest 1/4; thence South 543.90 feet to the place of beginning containing 5.01 acres of land more or less.

Tax Parcel No: GSC..2900009A.....

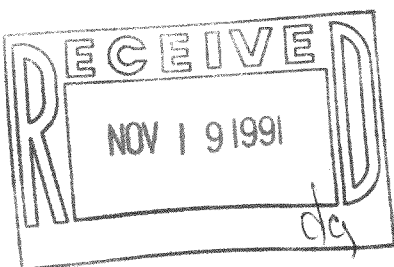

I, DAVID F. ABELL, DO HEREBY CERTIFY
THAT I HAVE SURVEYED THE PROPERTY
HEREON DESCRIBED ACCORDING TO THE
OFFICIAL RECORDS AND THAT THE PLAT
HEREON IS A CORRECT REPRESENTATION
OF THE PROPERTY LINES TO THE BEST OF
MY KNOWLEDGE AND BELIEF.

David F. Abell

DAVID F. ABELL
WISCONSIN REGISTERED LAND SURVEYOR, S-1596

March 22, 1990

DATE JOB NUMBER - 90047
NOTE: THIS IS NOT A CERTIFIED COPY UNLESS SEALED.

REVISED: MAY 23, 1991

316-536

GSC29-9A