

PLAT OF SURVEY

WITH PROPOSED RESIDENCE LOCATION

LOT 1 OF CERTIFIED SURVEY MAP NO. 2130
SEC. 23, T. 3 N., R. 16 E.
WALWORTH COUNTY, WI.

NOTE: COPIES OF THIS MAP TO WHICH THE FOLLOWING CERTIFICATE WILL APPLY ARE BLUE LINE PRINTS SHOWING SURVEYOR'S ORIGINAL SEAL AND SIGNATURE IN BLACK INK. COPIES BY ANY OTHER MEANS MAY HAVE ALTERATIONS WHICH DO NOT REPRESENT THE SURVEYOR'S WORK PRODUCT.

I HEREBY CERTIFY THAT THIS PLAT OF SURVEY IS A TRUE AND ACCURATE REPRESENTATION OF THE BOUNDARY LINES OF THE SUBJECT PARCEL AND SHOWS THE LOCATION OF THE PROPOSED RESIDENCE AS STAKED TO THE BEST OF MY KNOWLEDGE AND BELIEF.


THIS SURVEY IS MADE FOR THE USE OF THE PRESENT OWNERS OF THE PROPERTY, AND ALSO THOSE WHO PURCHASE, MORTGAGE, OR GUARANTEE THE TITLE THERETO WITHIN ONE YEAR FROM THE DATE HEREOF.

DATED: 04/21/92


PETER S. GORDON RLS 2101



WEST LINE NW 1/4
ASSIGNED BEARING N 00° 06' E

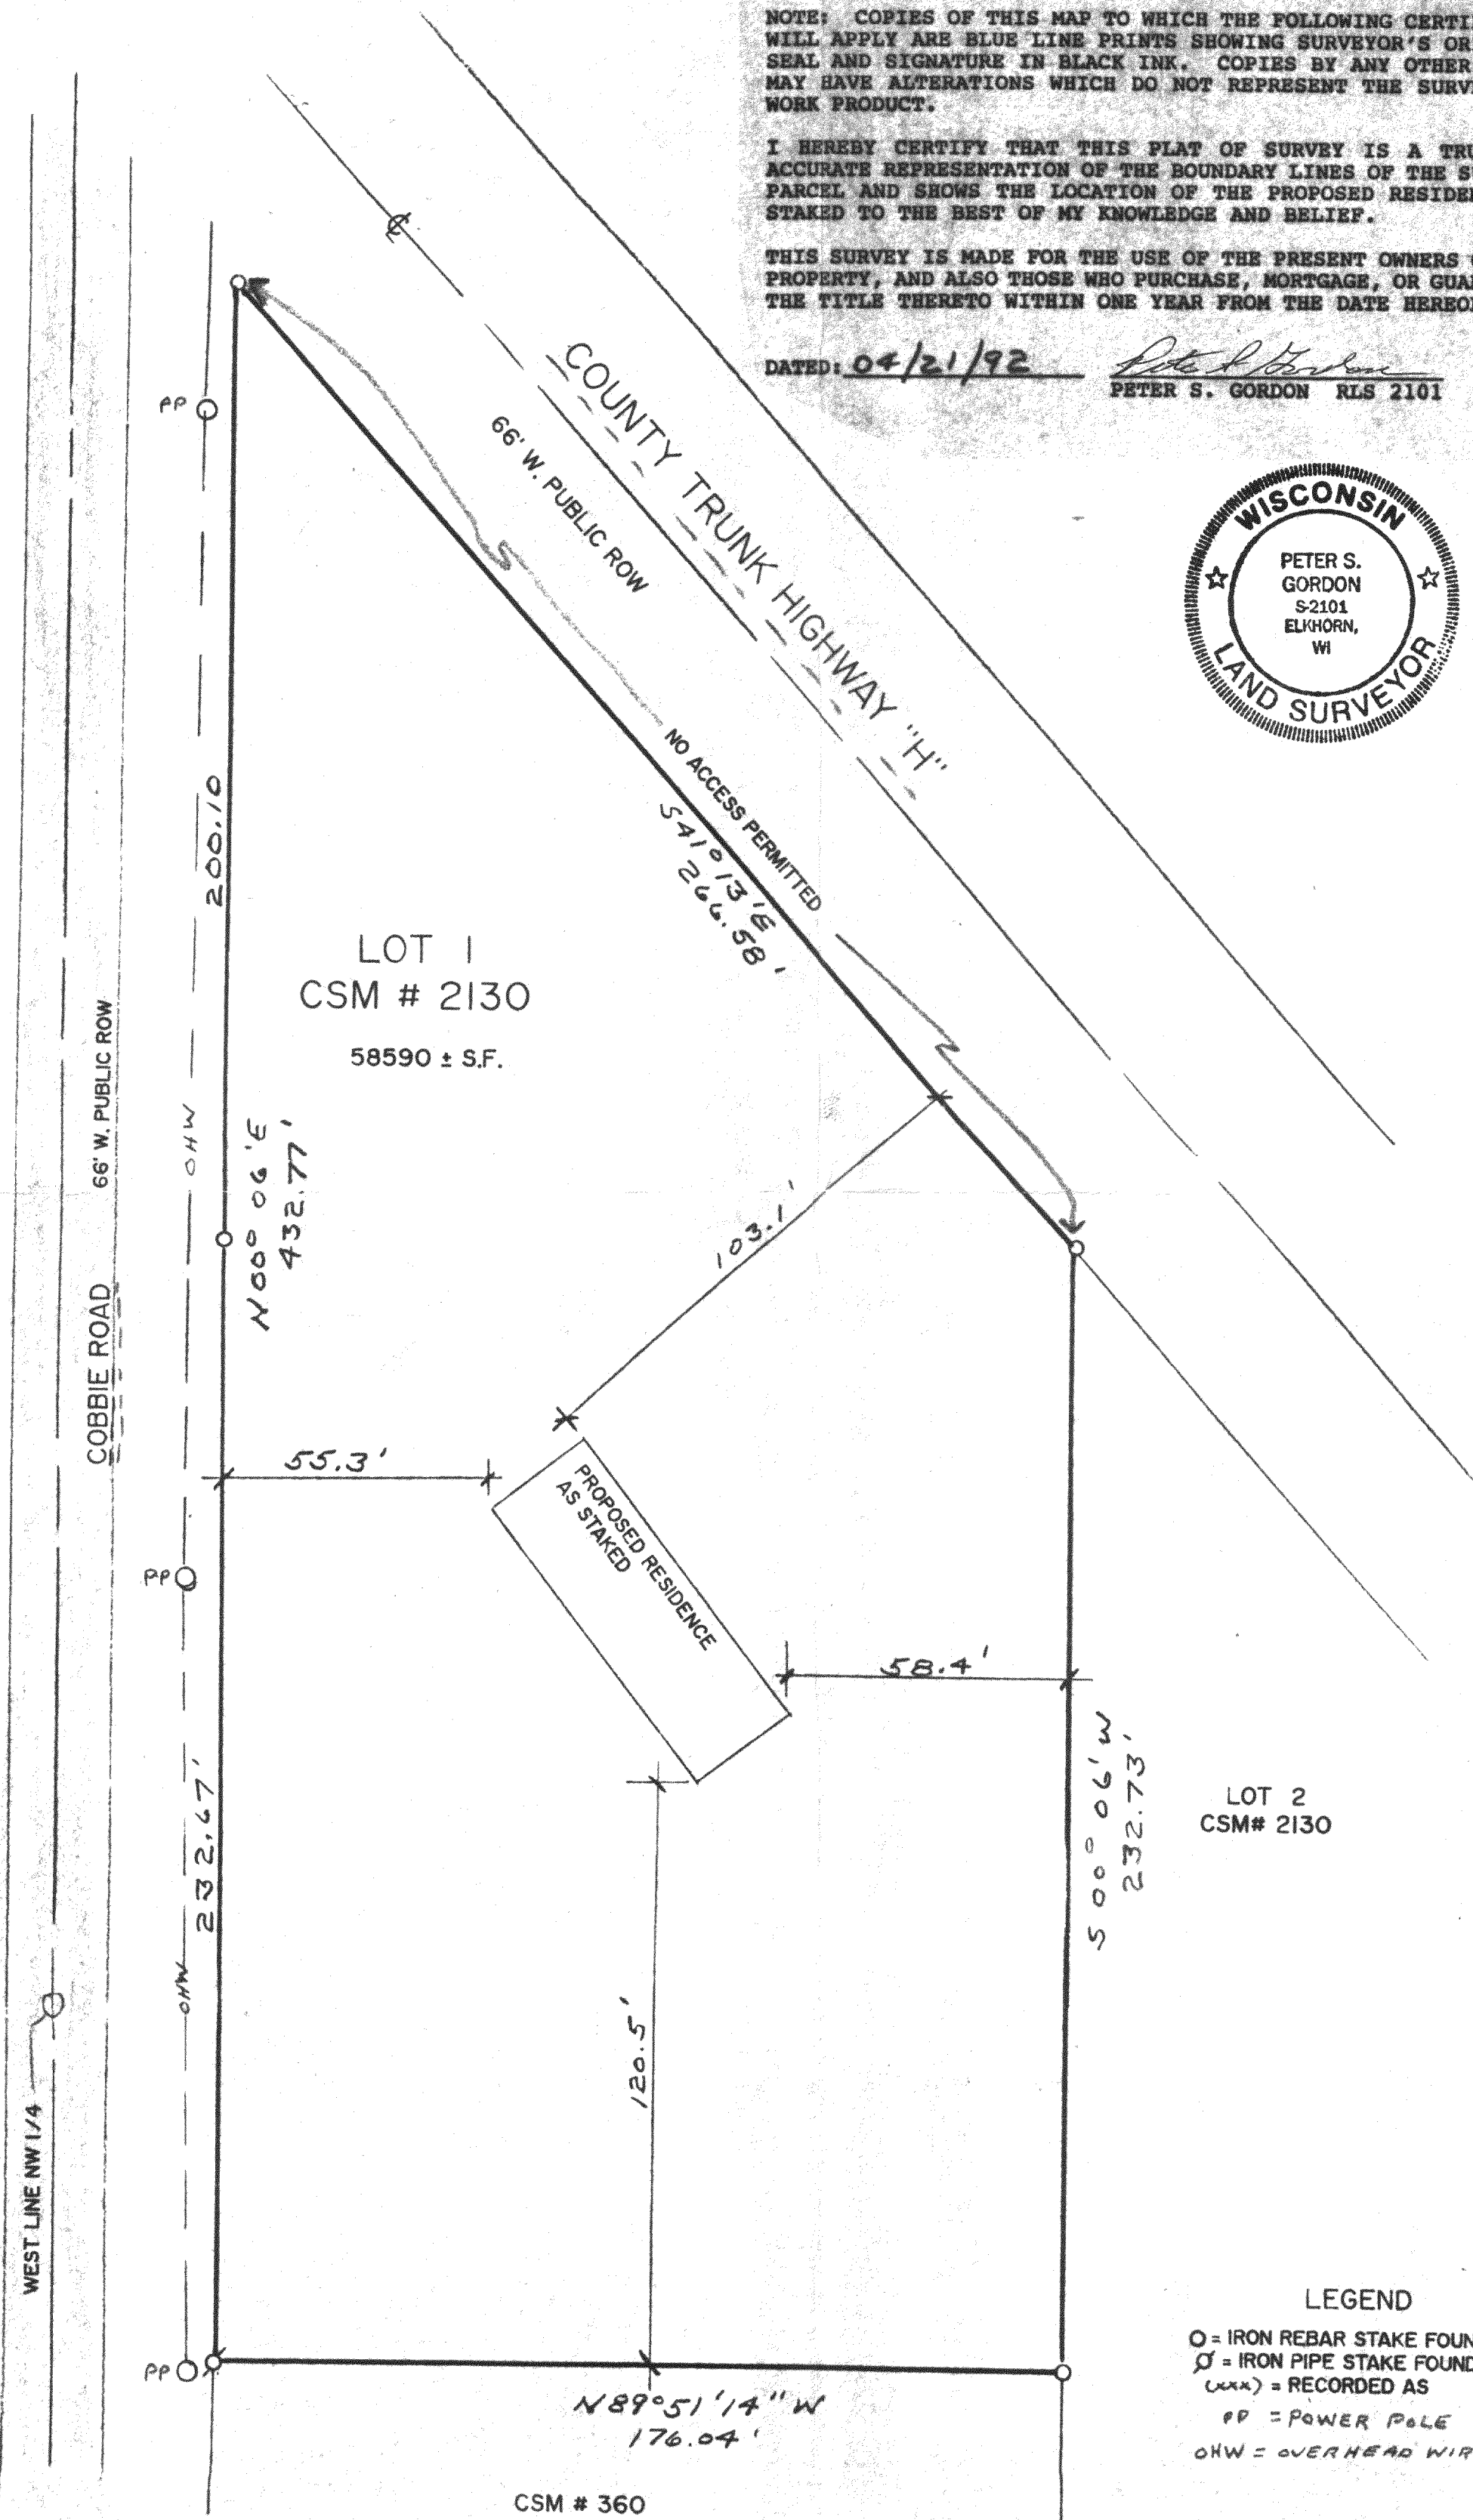

MAP SCALE IN FEET
1" = 30'

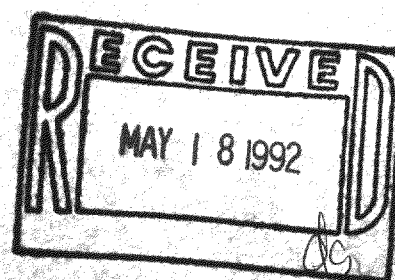

WORK ORDERED BY: MARK GORECKI

PLAT OF SURVEY
LOT 1 OF CERTIFIED SURVEY MAP NO. 2130
SEC. 23, T. 3 N., R. 16 E.
WALWORTH COUNTY, WI.

FARRIS, HANSEN & ASSOCIATES, INC.
Engineering, Architecture, Surveying
7 Ridgeway Court P.O. Box 437
ELKHORN, WISCONSIN 53121
Office: (414) 723-2098
Fax: (414) 723-5886

REVISIONS

PROJECT NO
3611
DATE
04/21/92
SHEET NO
1 OF 1