

Wisconsin Registered Land Surveyor S-1594


Rt. 3, Box 273
Elkhorn, Wisconsin 53121
Phone: (414) 723-4260 (office)
(414) 723-4813 (residence)

PLAT OF SURVEY

LOTS 1-7 INCLUSIVE OF
BLOCK 28 OF
INTERLAKEN 3RD MAP,
located in the South
1/2 of Section 11,
Town 3 North, Range
16 East, Walworth
County, Wisconsin.

ORDERED BY: SCHAUDER BUILDERS
4115 HWY 51 NORTH
JANESVILLE, WI. 53545-9674

OWNERS: MR. AND MRS. JAMES WULFF

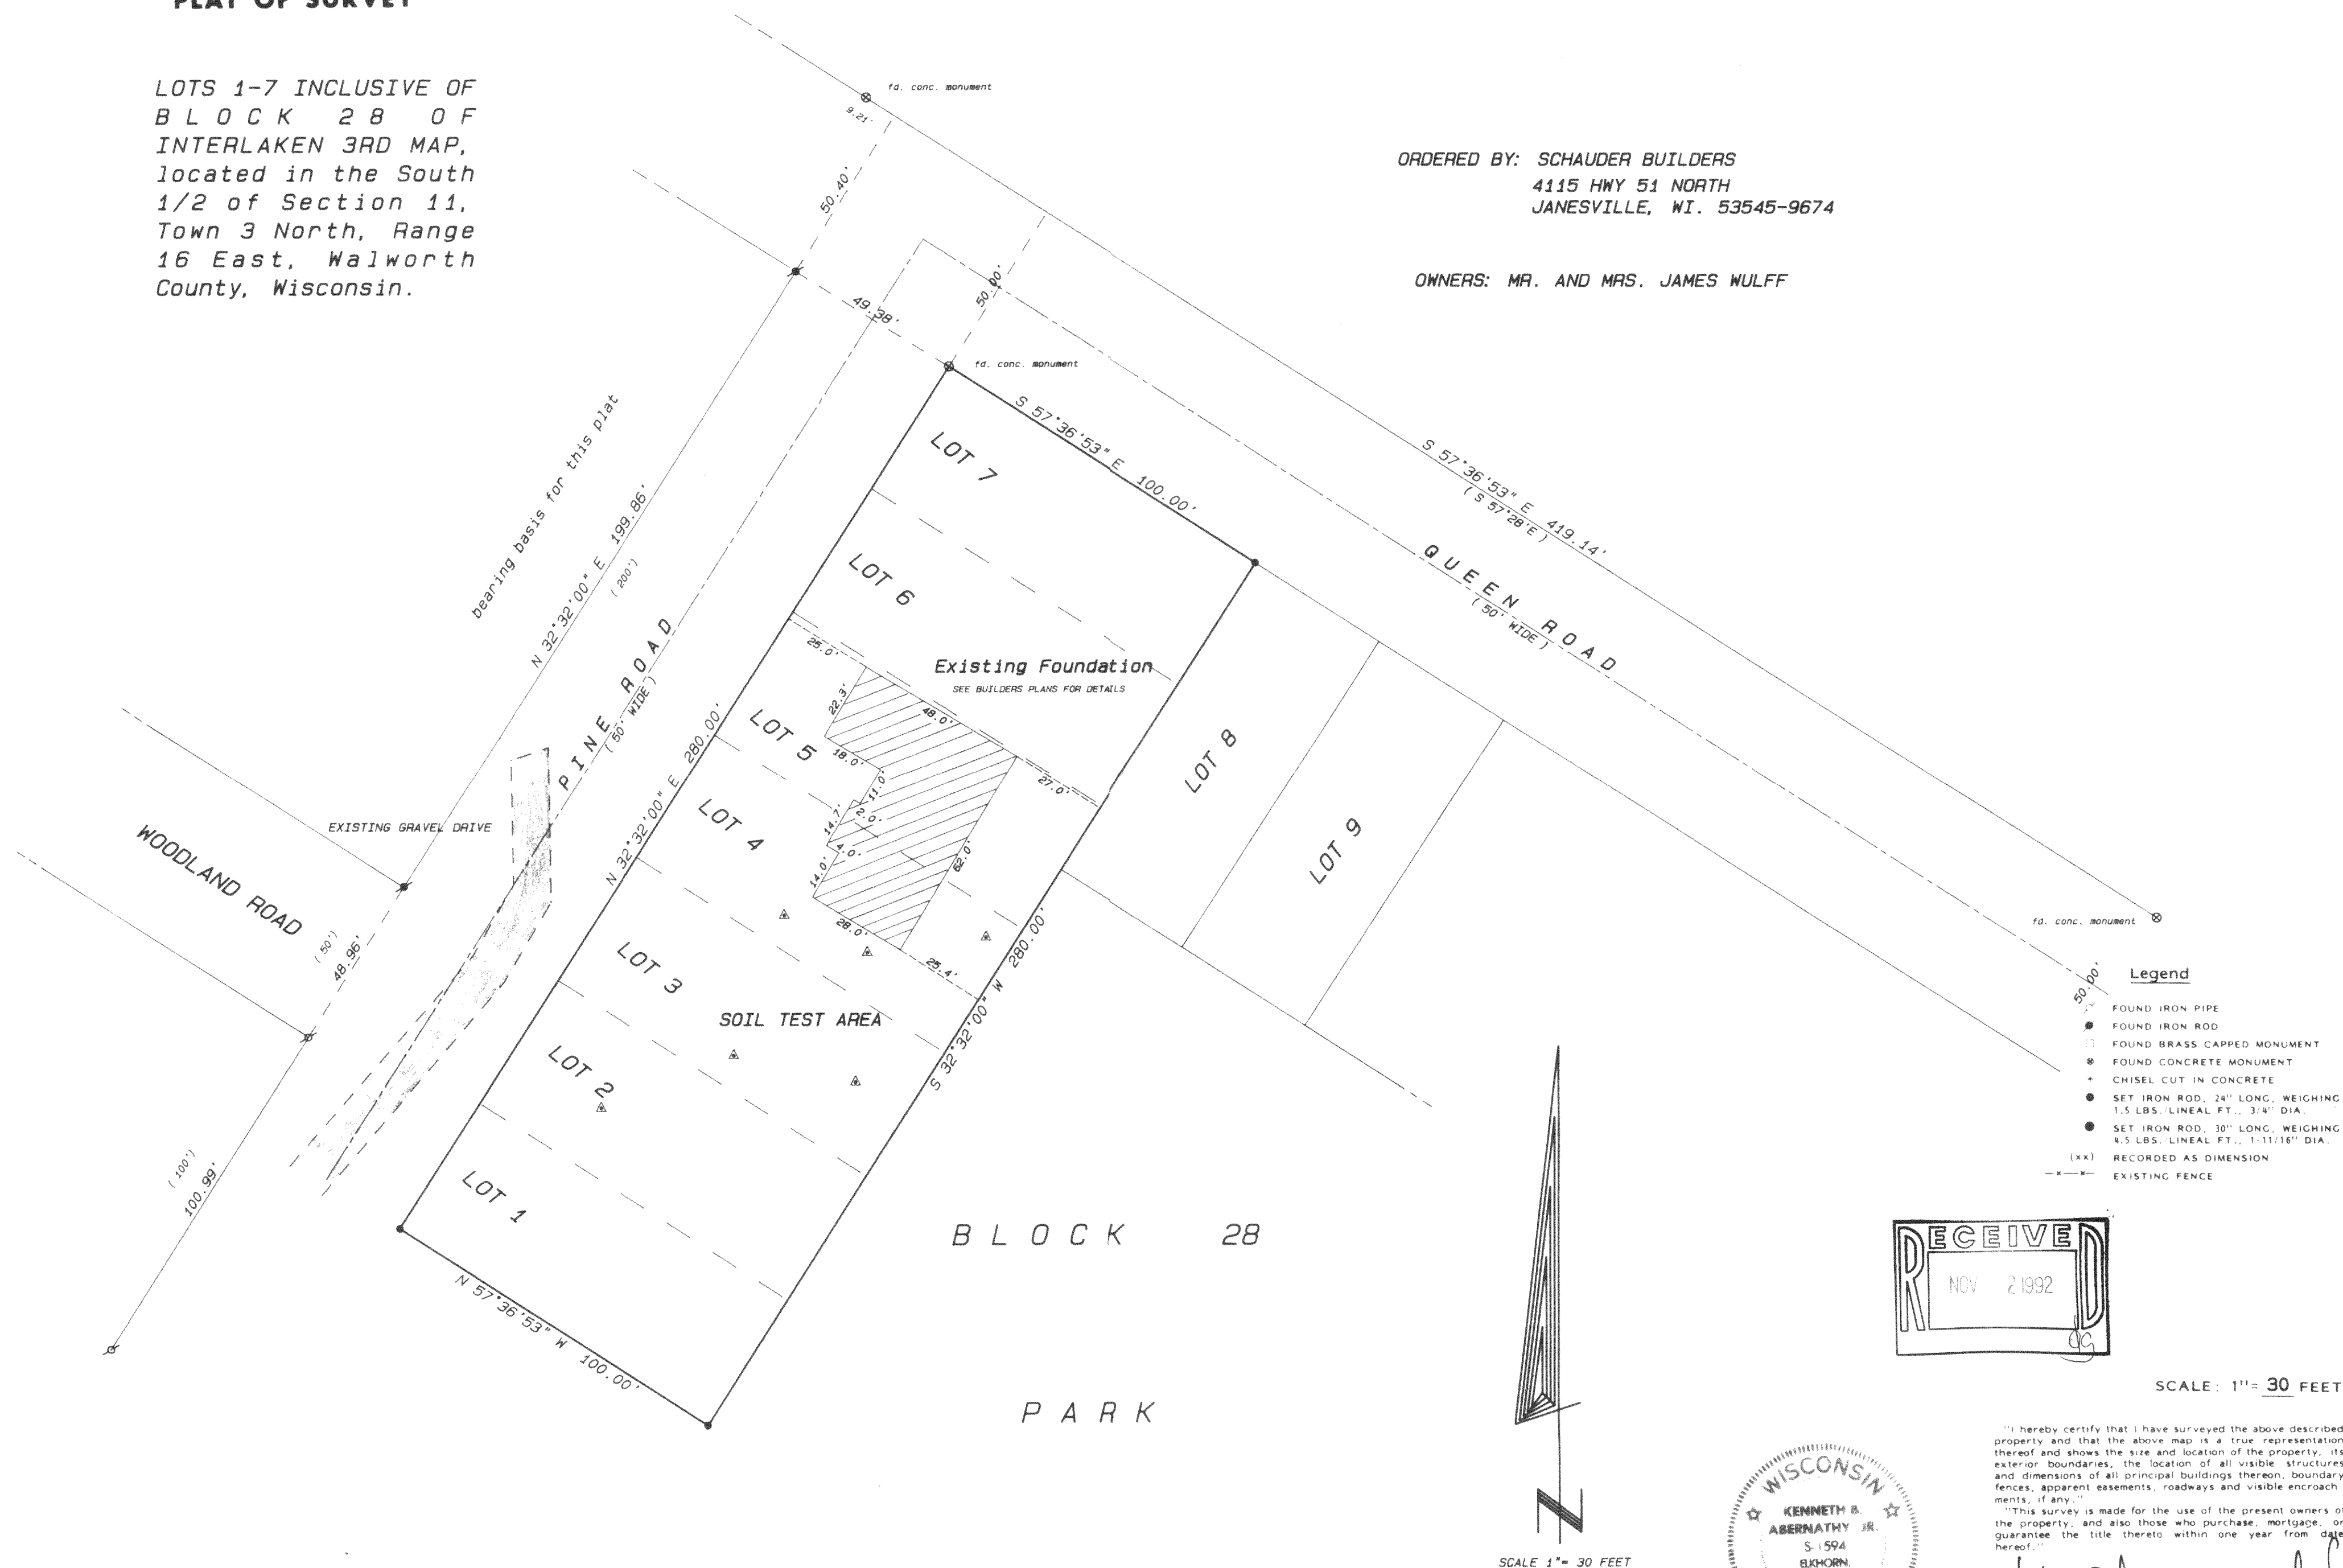

SCALE: 1" = 30 FEET

"I hereby certify that I have surveyed the above described property and that the above map is a true representation thereof and shows the size and location of the property, its exterior boundaries, the location of all visible structures and dimensions of all principal buildings thereon, boundary fences, apparent easements, roadways and visible encroachments, if any."

"This survey is made for the use of the present owners of the property, and also those who purchase mortgage, or guarantee the title thereto within one year from date hereof."

hereof.

Kenneth B. Abernathy

KENNETH B. ABERNATHY, JR.
WISCONSIN REGISTERED LAND SURVEYOR
S-1594

Revised May 27, 1992
Date: May 4, 1992

GI-272

316-591