

PLAT OF SURVEY
of
Lot 2, Block 2 of Lake Wandewega Highlands
located in the NE 1/4 of Section 11 and
the NW 1/4 of Section 12, T3N, R16E, Town
of Sugar Creek, Walworth County, Wisconsin.

SURVEYED FOR: Thomas & Mary Krenzel
3651 S. Paulina
Chicago, IL 60609


SURVEYED BY: Jensen Surveying & Mapping S.C.
45 S. Wisconsin Street
Elkhorn, Wisconsin 53121
(414) 723-3434

RECERTIFIED 8-11-92 FOR: MODERN REALTY, INC.
102 N. WISCONSIN ST.
ELKHORN, WI 53121



SCALE - 1" = 20'

LEGEND
■ Found Concrete Monument
● Found iron pipe
○ Set iron pipe

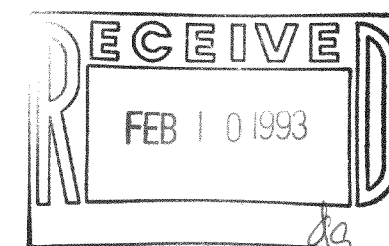

Copyright © 1990 by Jensen Surveying & Mapping S.C.

All rights reserved. No part of this survey plat may be reproduced or transmitted in any form by any means - graphic, electronic, or mechanical, including photocopying, tracing, or information storage and retrieval systems - without permission in writing from Thomas P.A. Jensen, Jensen Surveying & Mapping S.C.

Note: This survey plat is not certified unless signed and sealed in red ink.

I, Thomas P.A. Jensen, Wisconsin Registered Land Surveyor, do hereby certify that this survey was performed by me, or under my direction, in full compliance with the owner's instructions and Chapter A-E 7 of the Wisconsin Administrative Code "Minimum Standards For Property Surveys"; and that this map is an accurate representation thereof to the best of my knowledge and belief.

Thomas P.A. Jensen
Thomas P.A. Jensen R.L.S-1084
Jensen Surveying & Mapping S.C.

RECERTIFIED 8-11-92 1992.101

1190.139

316-618

GWH - 33