

#199-65

#199-65




DESCRIPTION: Lots 1, 2, 3, 4, 5, 6, 7, 8, & 9 of Block 12 and Lots 1, 2, 3, & 4 of Block 5 of North Lake Shorewoods Subdivision, located in Section 5, of T. 3 N., R. 16 E. Walworth County, Wisconsin.

CERTIFICATE: I, James F. Biagi, surveyor, do hereby certify that I have surveyed the property hereon described.

August 4, 1965.

*James F. Biagi*

James F. Biagi RLS 272

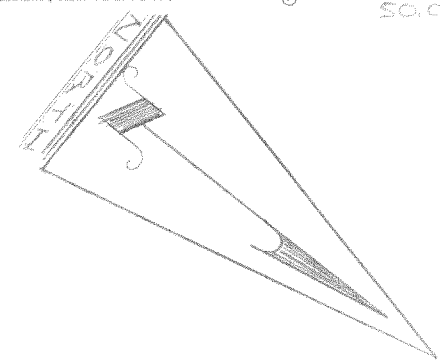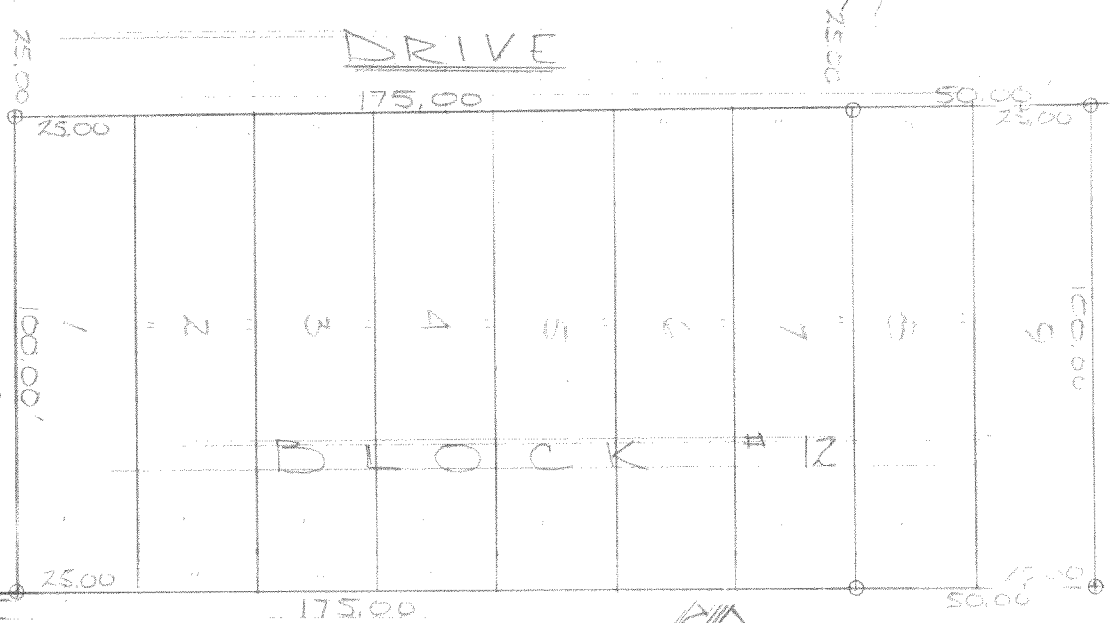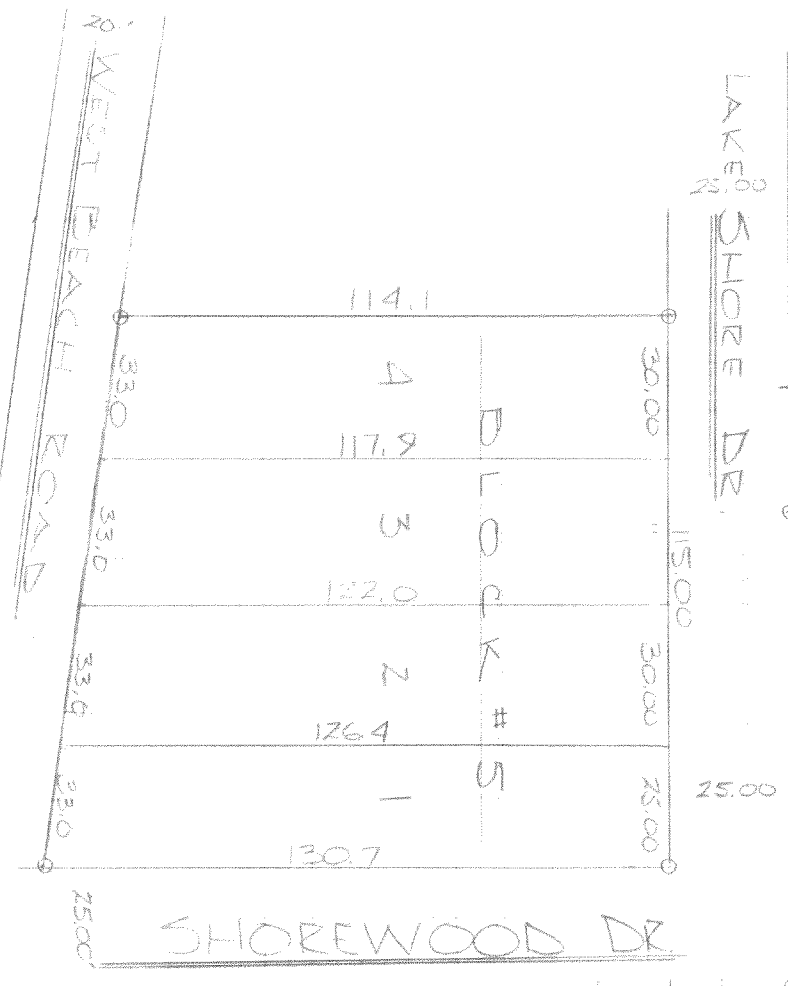

6 N. 1/4 S. 118, 119, 32

316-61B