ABERNATHY and ASSOCIATES Kenneth B. Abernathy Jr.


Wisconsin Registered Land Surveyor S-1594

Rt. 3, Box 273 Elkhorn, Wisconsin 53121

Phone: (414) 723-4260 (office) (414) 723-4813 (residence)

PLAT OF SURVEY

Lot 1 and Lot 2 of Block 17 of the Original Plat of Interlaken Subdivision, 1st Map, Located in the Southeast 1/4 of Section 11, Town 3 North, Range 16 East, Town of Sugar Creek, County of Walworth, State of Wisconsin.

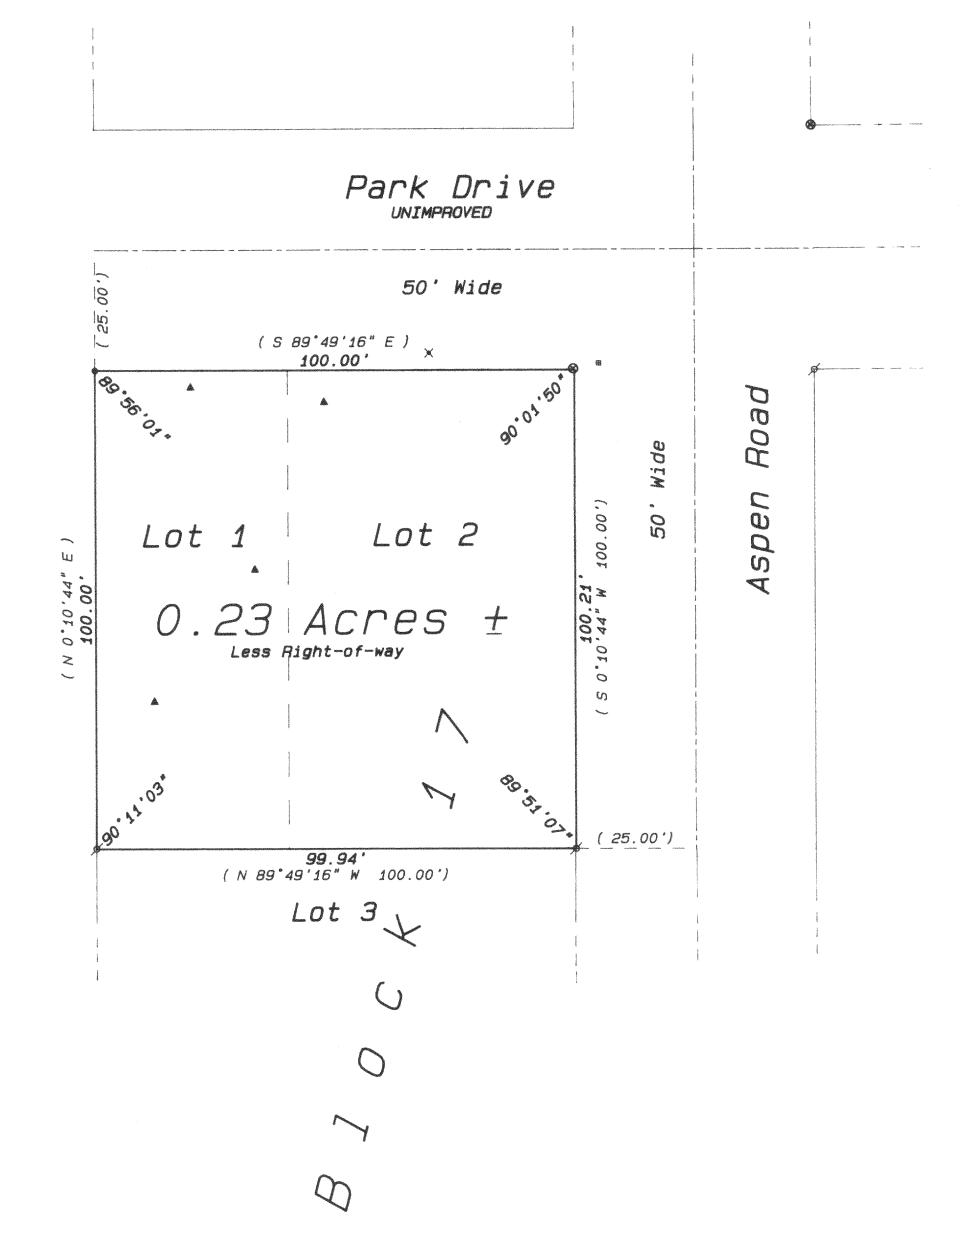

Legend

FOUND IRON PIPE

FOUND IRON ROD FOUND BRASS CAPPED MONUMENT

S FOUND CONCRETE MONUMENT

+ CHISEL CUT IN CONCRETE

SET IRON PIPE, 24" LONG, WEIGHING
1.13 LBS./LINEAL FT., 1" DIA.

SET IRON ROD, 30" LONG, WEIGHING
4.5 LBS./LINEAL FT., 1-11/16" DIA.

(xx) RECORDED AS DIMENSION

- X-X- EXISTING FENCE

B UNDERGROUND UTILITY BOX

SOILS TEST BORING

SCALE: 1"= 20 FEET

ARREMATE DE 5.1394 MAKOWOKIA.

ECEIVE

SEP | 6 | 993

"I hereby certify that I have surveyed the above described property and that the above map is a true representation thereof and shows the size and location of the property, its exterior boundaries, the location of all visible structures and dimensions of all principal buildings thereon, boundary fences, apparent easements, roadways and visible encroach-

ments, if any."

"This survey is made for the use of the present owners of the property, and also those who purchase, mortgage, for guarantee the title thereto within one year from date hereof.

KENNETH B. ABERNATHY, JR. WISCONSIN REGISTERED LAND SURVEYOR,

\_ Job No. 1993.718 Date: July 30, 1993

GI-225

Ordered by: Pam Paul

Coldwell Banker

TLC Realty, Inc.

Elkhorn, Wisconsin

53121

Route 5, Box 5

S-1594