


FARRIS, HANSEN & ASSOCIATES, INC.
ENGINEERING, ARCHITECTURE, SURVEYING
7 RIDGWAY COURT - P. O. BOX 437, ELKHORN, WISCONSIN 53121
PHONE: (414) 723-2098 FAX: (414) 723-5886

PLAT OF SURVEY

WORK ORDERED BY:
MARK & CORNELL BRELLENTHIN
W. 4184 POTTERS ROAD
ELKHORN, WISCONSIN

LEGEND
= SET IRON REBAR STAKE
● = FOUND IRON PIPE STAKE
= FOUND IRON REBAR STAKE
= FOUND CONCRETE MONUMENT
(xxx) = RECORDED AS

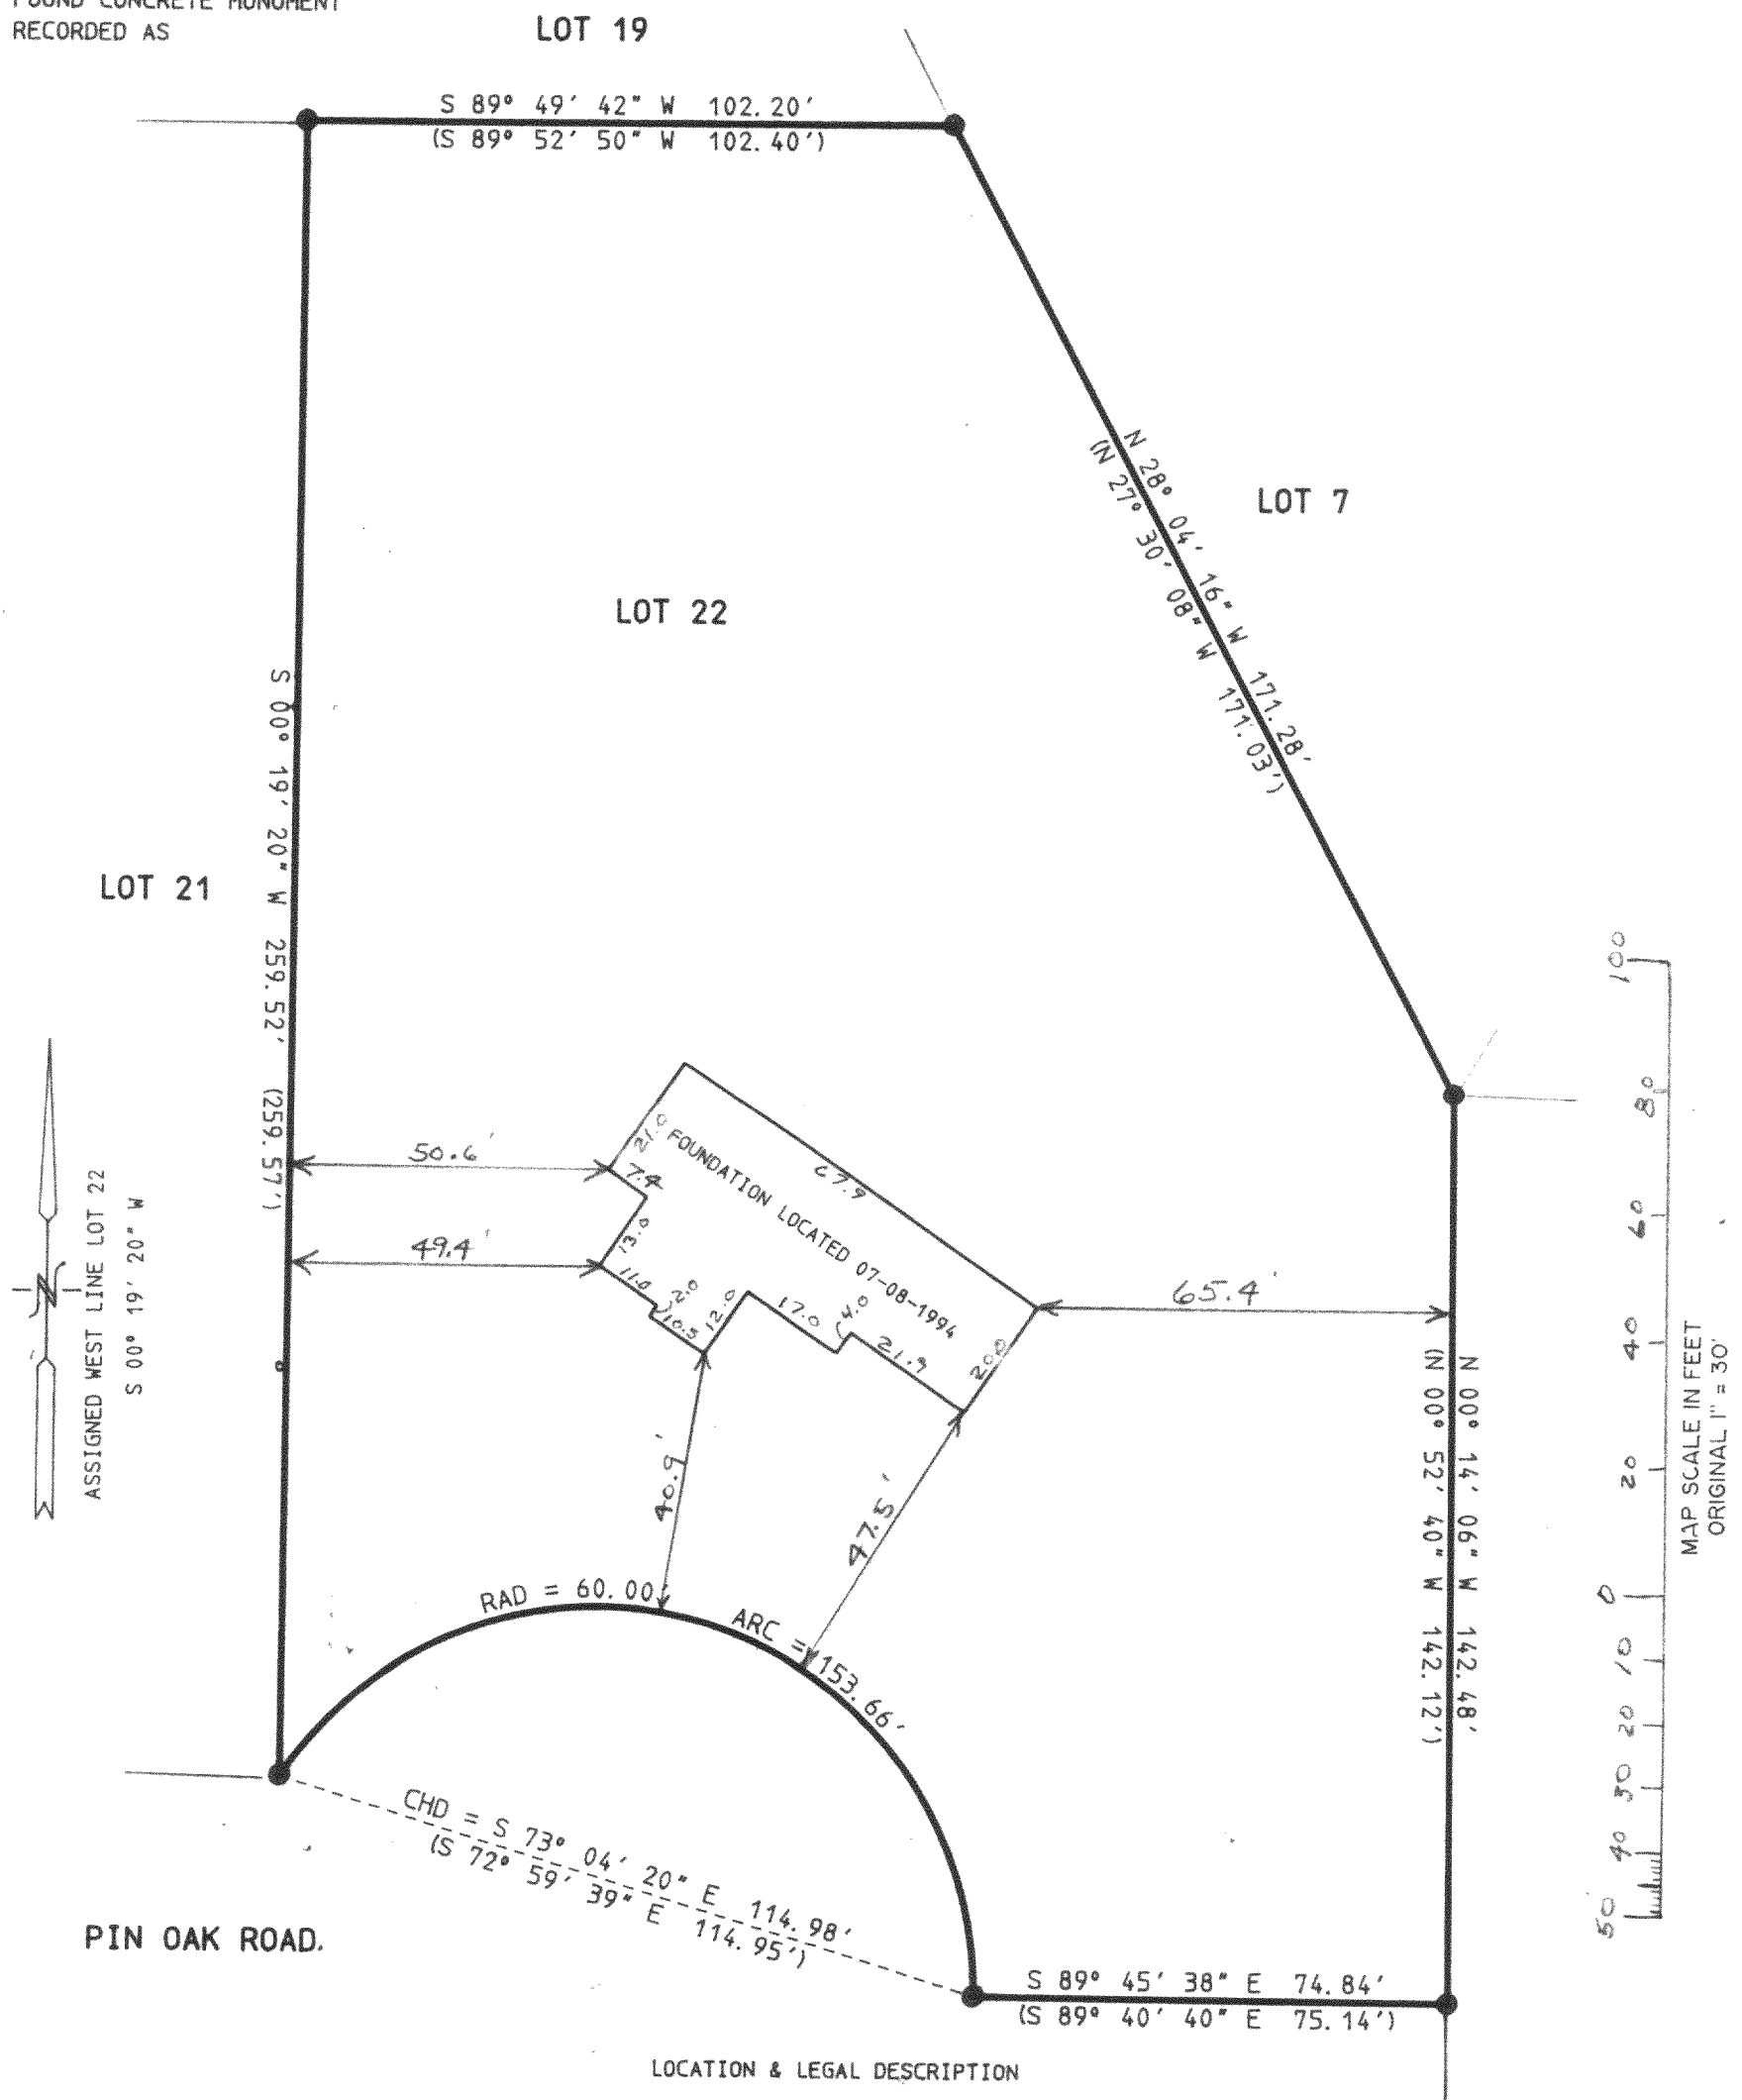



LOT 22 OF SYLVAN TRACE SUBDIVISION LOCATED IN SECTION 2 OF T. 3 N., R. 16 E., TOWN OF SUGAR CREEK, WALWORTH COUNTY, WISCONSIN

NOTE: COPIES OF THIS MAP TO WHICH THE FOLLOWING CERTIFICATE WILL APPLY ARE BLUE LINE PRINTS SHOWING SURVEYOR'S ORIGINAL SEAL AND SIGNATURE IN BLACK INK. COPIES BY ANY OTHER MEANS MAY HAVE ALTERATIONS WHICH DO NOT REPRESENT THE SURVEYOR'S WORK PRODUCT.

I HEREBY CERTIFY THAT THE ABOVE DESCRIBED PROPERTY HAS BEEN SURVEYED UNDER MY DIRECTION AND THAT THE ABOVE MAP IS A TRUE REPRESENTATION THEREOF AND SHOWS THE SIZE AND LOCATION OF THE PROPERTY AND ITS EXTERIOR BOUNDARIES. THIS SURVEY IS MADE FOR THE USE OF THE PRESENT OWNERS OF THE PROPERTY, AND ALSO THOSE WHO PURCHASE, MORTGAGE, OR GUARANTEE THE TITLE THERETO WITHIN ONE YEAR FROM THE DATE HEREOF.

DATED: 7-11-94

Peter A. Gordon

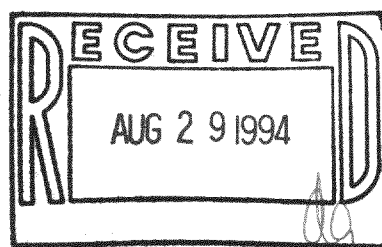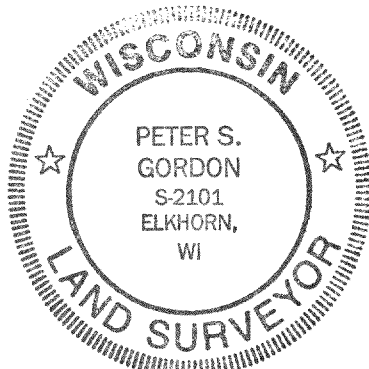

PROJ 4122
DATED 07-11-1994

6ST-22

316-709