


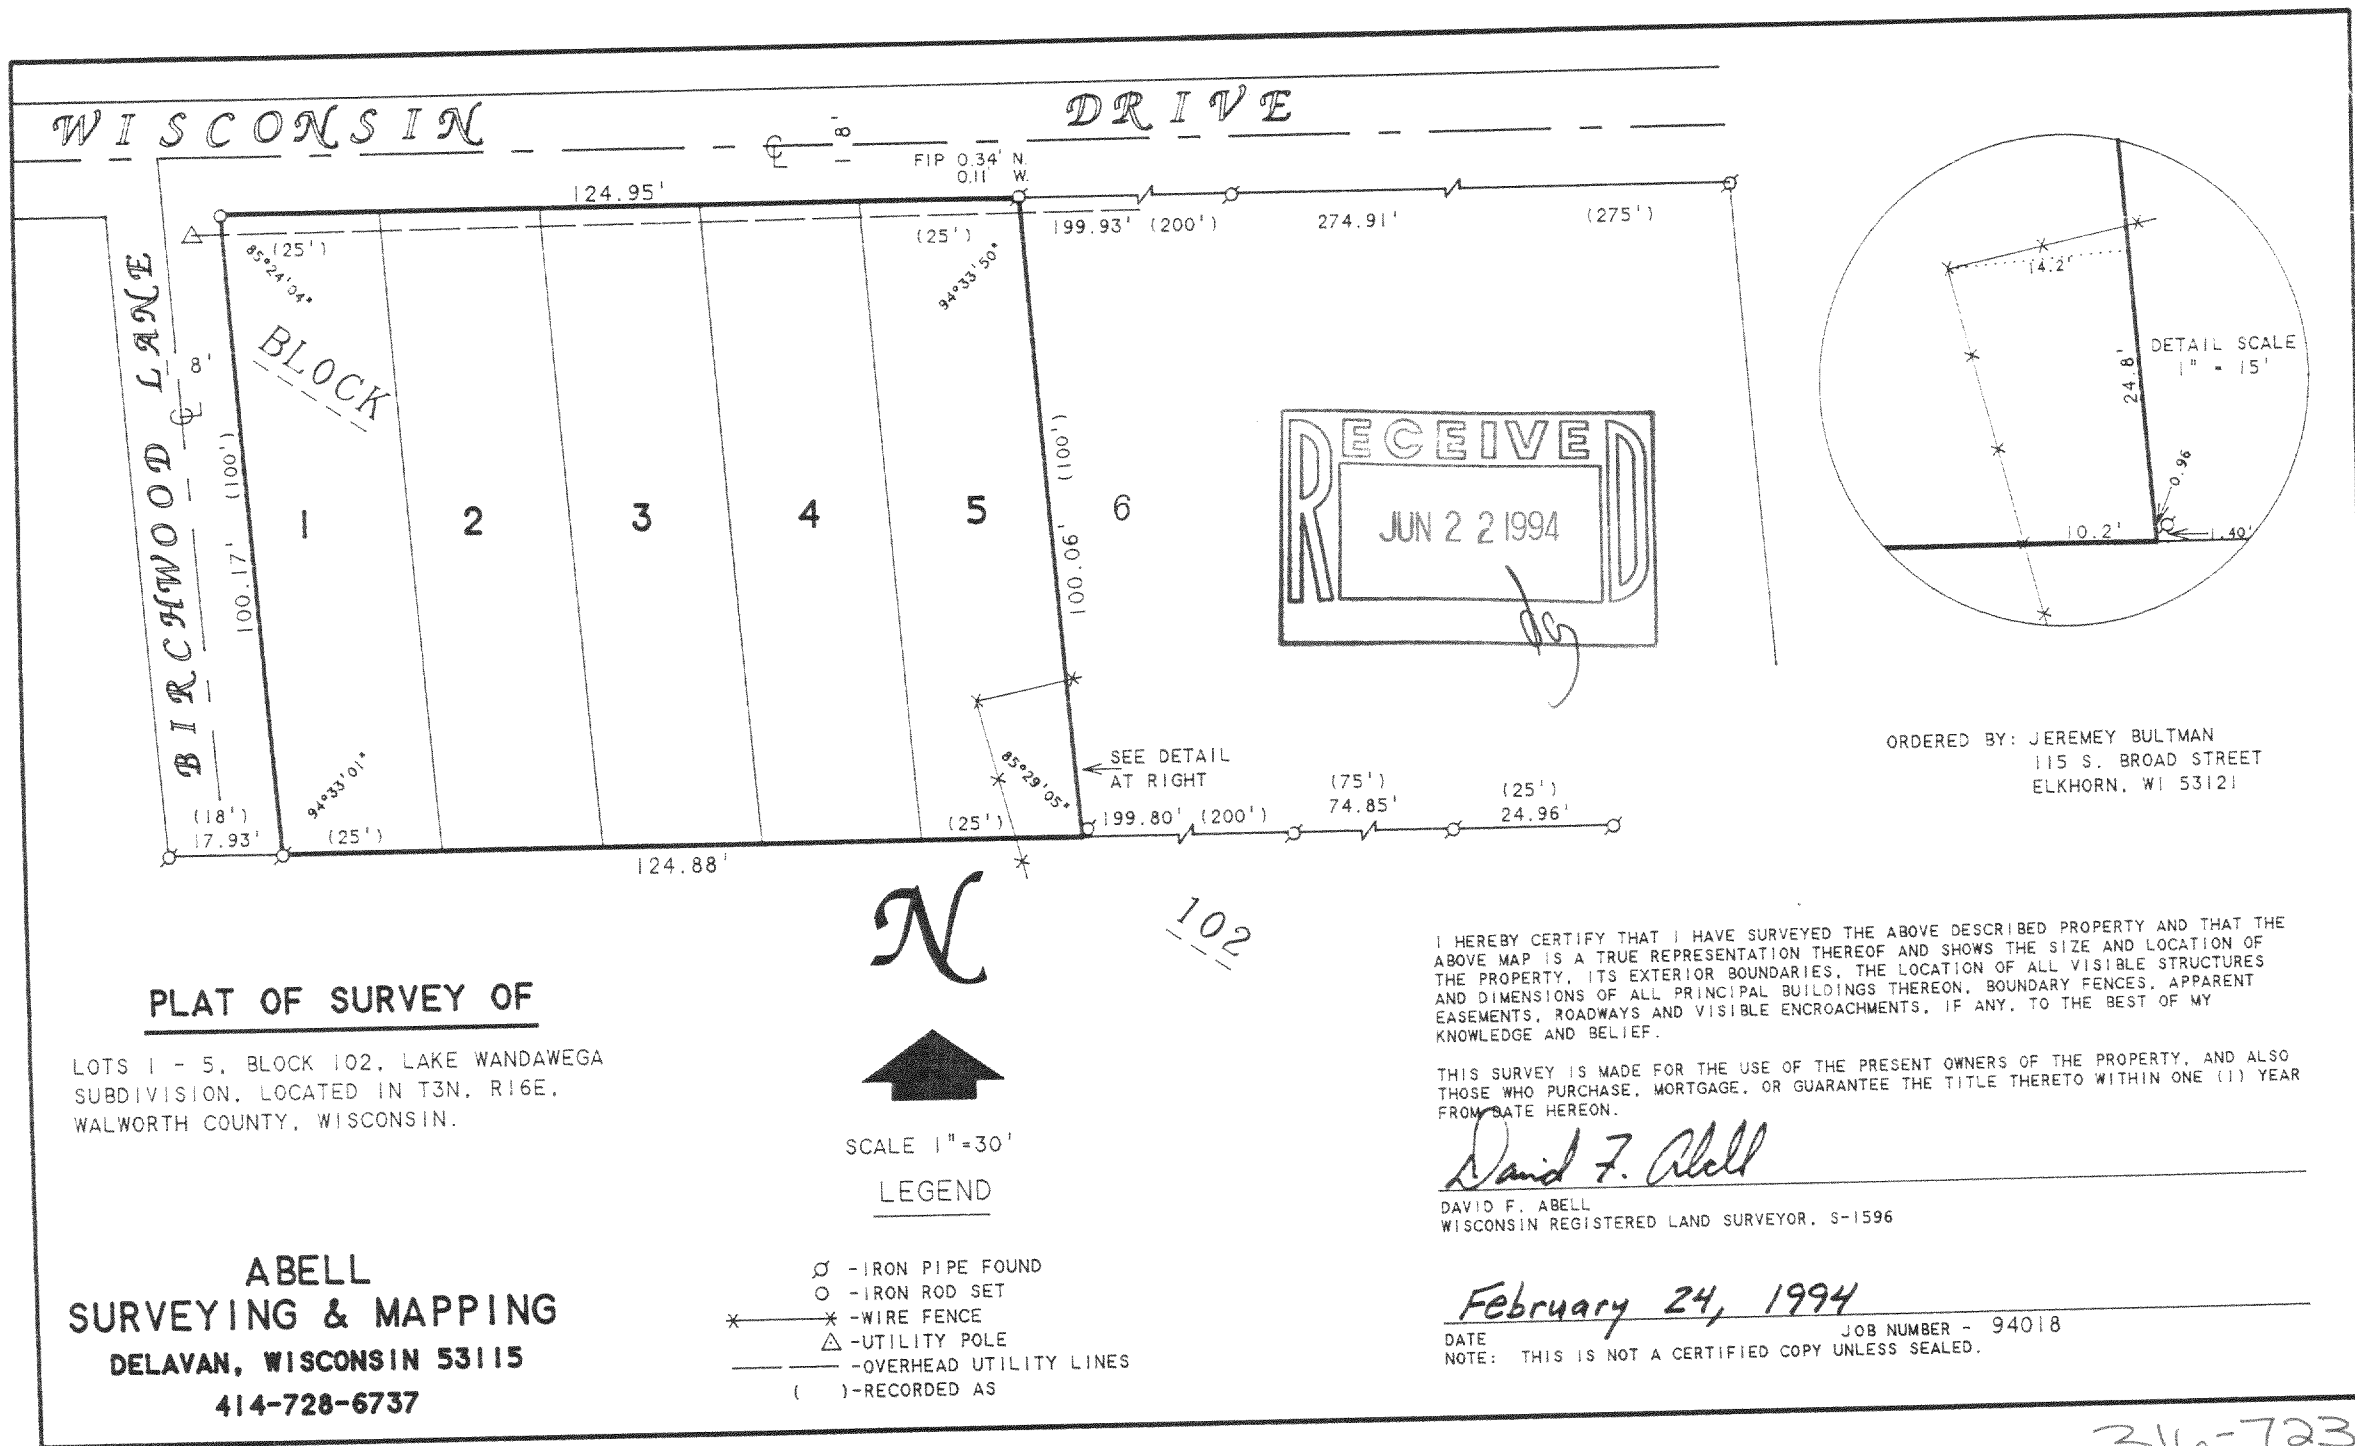

GLW-231

316-723