


**ABELL
SURVEYING & MAPPING
DELAN, WISCONSIN 53115
414-728-6737**

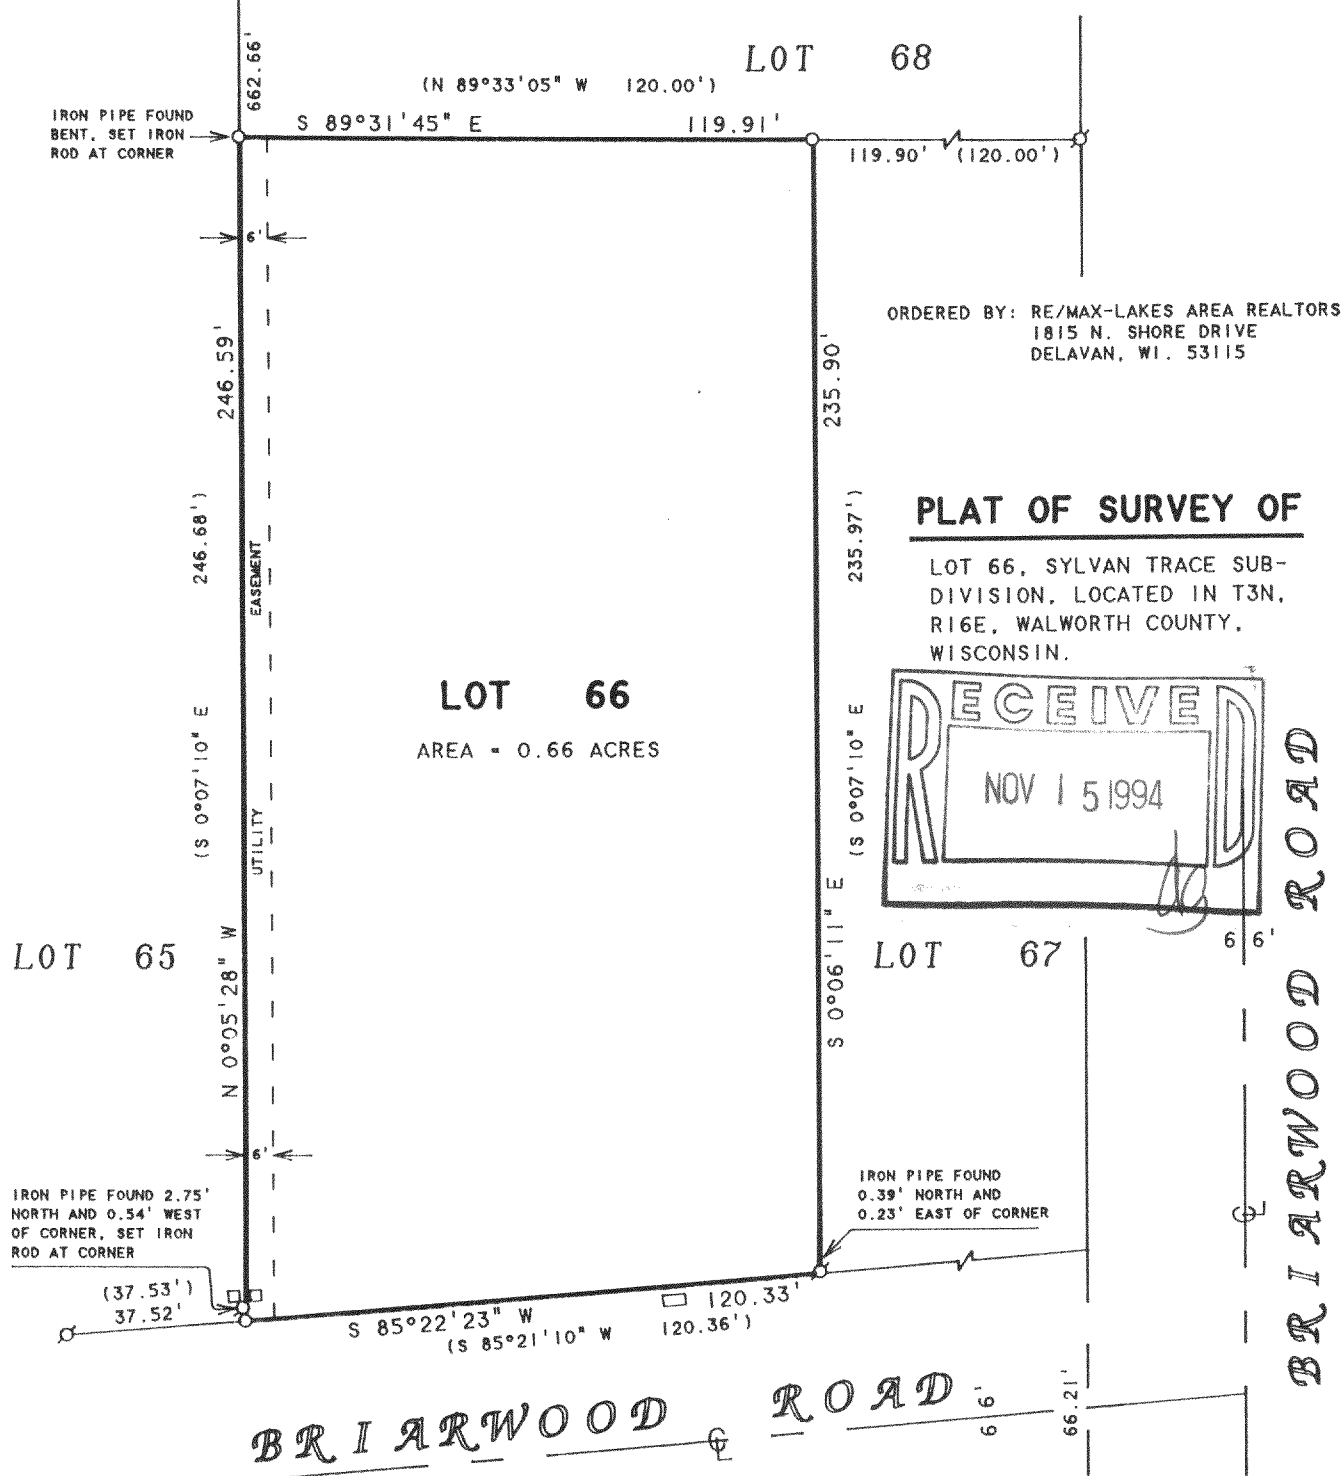

GST-66

316-729