
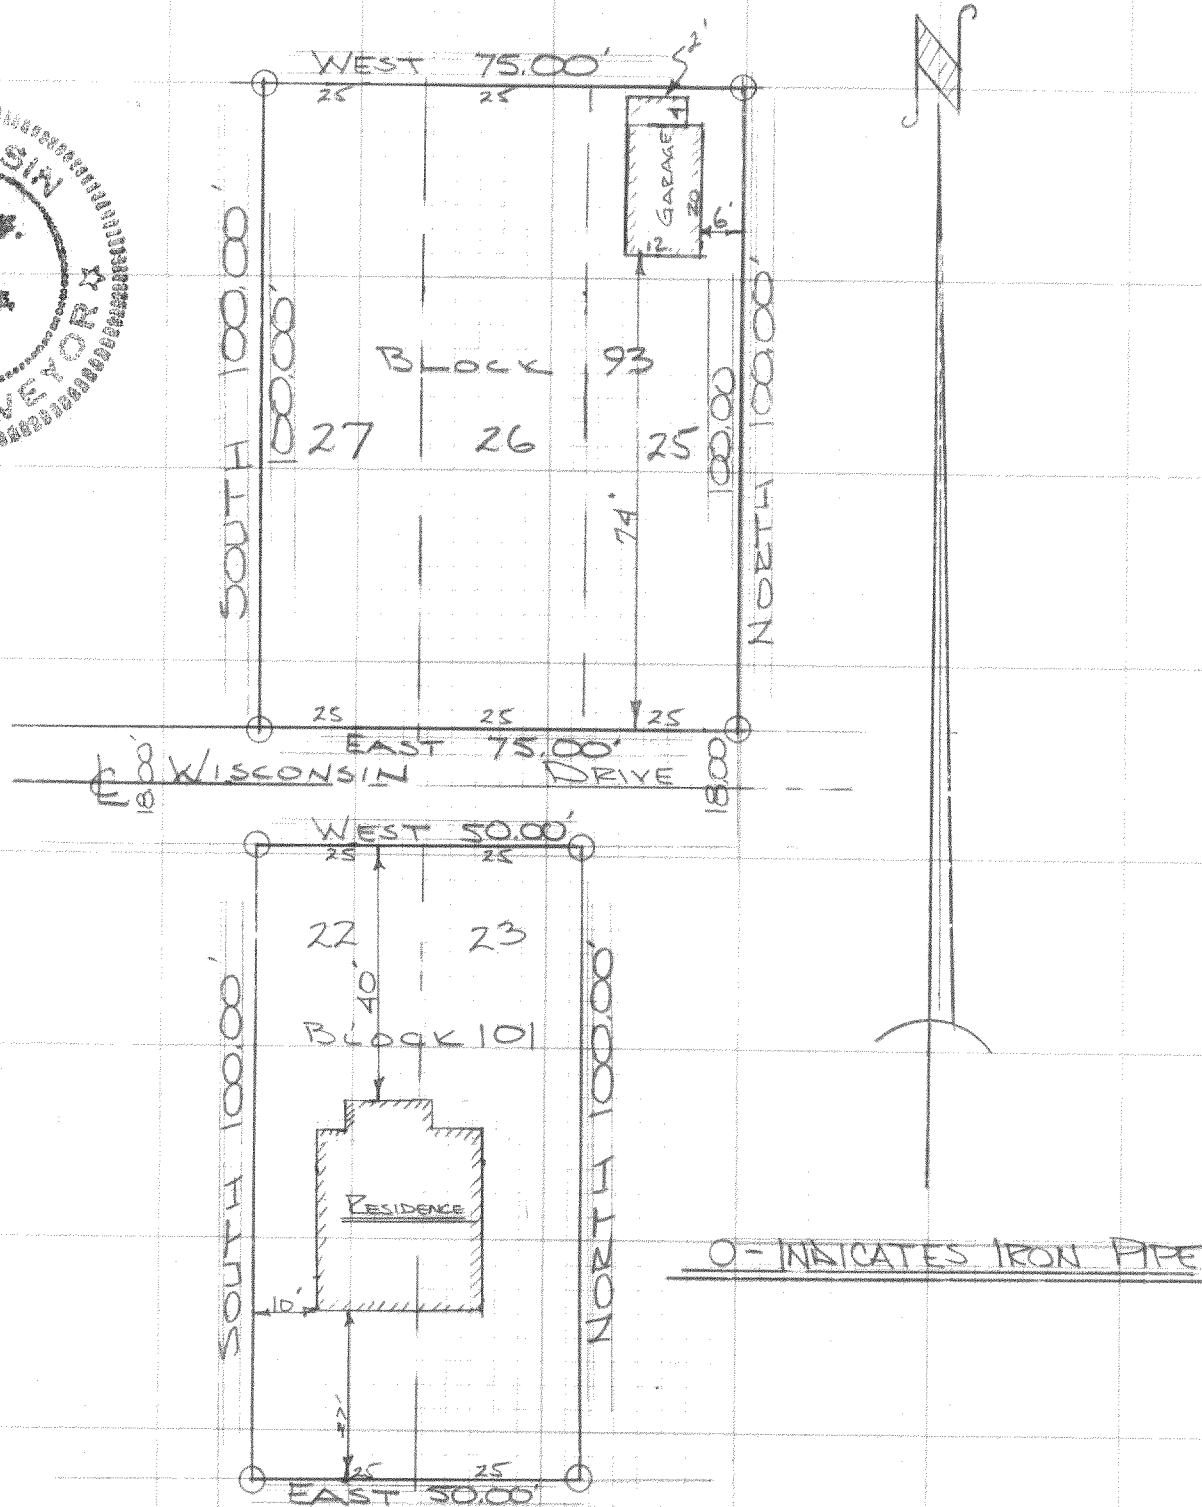


#69-68

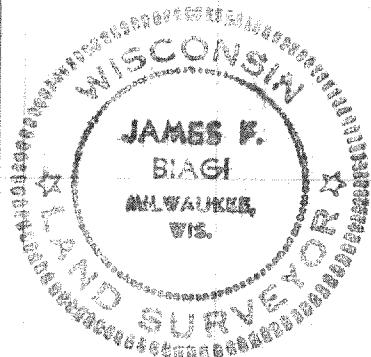

DESCRIPTION: Lots 22 and 23 of Block 101, and Lots 25, 26, and 27 of Block 93 of Lake Wandawega Subdivision located in Sections 1, 2, and 12 of T. 3 N., R. 16 E., Walworth County, Wisconsin.

CERTIFICATE: I, James F. Biagi, surveyor, do hereby certify that I have surveyed the property hereon described and that the location of the improvements are as shown hereon.

June 11, 1968.

James F. Biagi, RLS 272

640 224, 171

316-73B