


KOLB LAND CONSULTING, INC.
LAND SURVEYING • SUBDIVIDING • LAND PLANNING

929 WILLIAMS STREET LAKE GENEVA, WISCONSIN 53147 414 248-3697


ORDERED BY: JOHN A. SARENA
W 5129 STRAWBERRY HILL RD.
ELKHORN, WI 53121

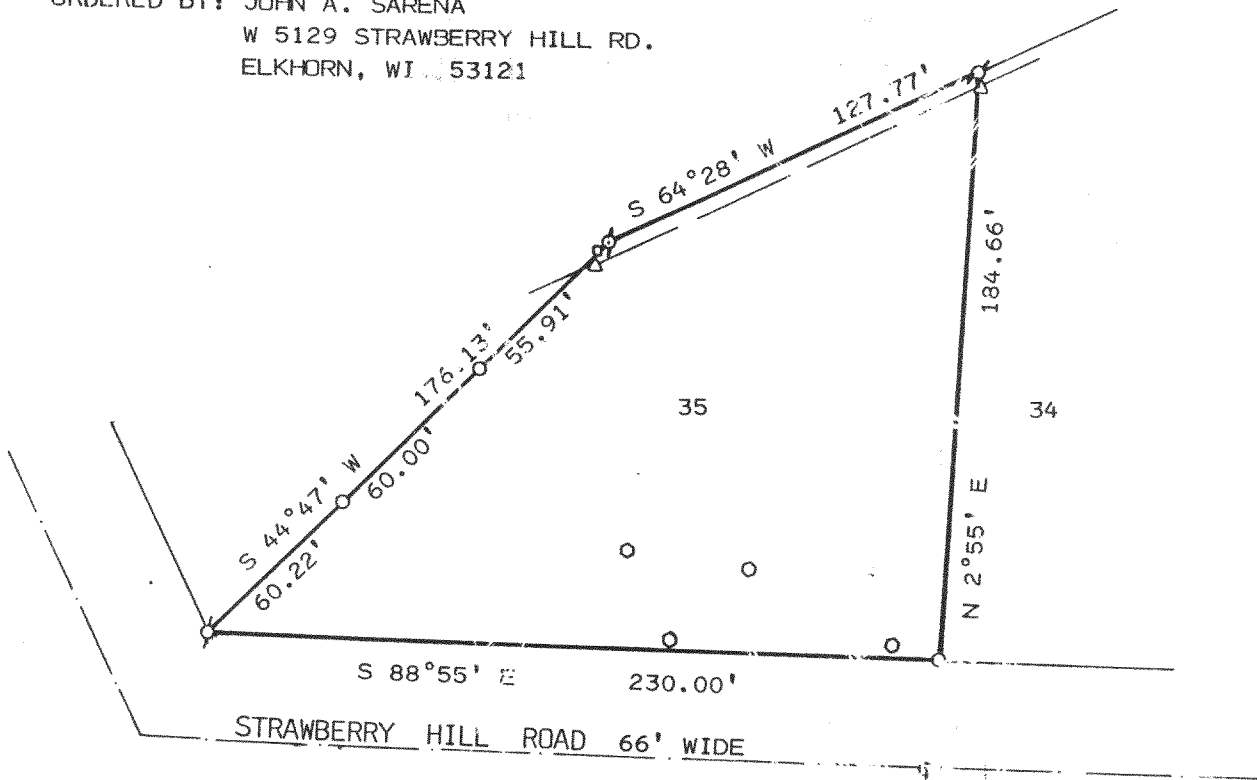

PLAT OF SURVEY OF

LOT 35 OF STRAWBERRY DANKE PLANTATION 1ST
ADDITION, A SUBDIVISION LOCATED IN THE
NORTHWEST 1/4 OF SECTION 1, T3N, R16E, TOWN
OF SUGAR CREEK, WALWORTH COUNTY, WISCONSIN.

NOTE: BEARINGS ARE ASSUMED AS
SHOWN ON THE RECORDED
SUBDIVISION PLAT.

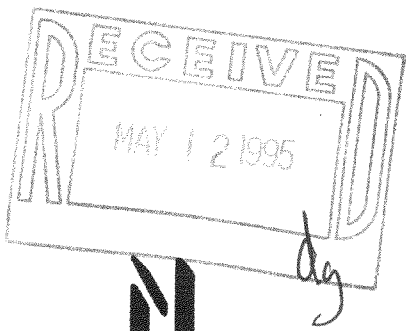

SCALE: 1" = 60'
LEGEND

- ø - IRON PIPE FOUND
- o - IRON PIPE SET
- o - BORING HOLE
- Δ - UTILITY POLE
- - OVERHEAD UTILITY LINE
- - UTILITY PEDISTAL

I HEREBY CERTIFY THAT I HAVE SURVEYED THE
ABOVE DESCRIBED PROPERTY AND THAT THE ABOVE
MAP IS A TRUE REPRESENTATION THEREOF AND
SHOWS THE SIZE AND LOCATION OF THE PROPERTY,
ITS EXTERIOR BOUNDARIES, THE LOCATION OF ALL
VISIBLE STRUCTURES AND DIMENSIONS OF ALL
PRINCIPAL BUILDINGS THEREON, BOUNDARY FENCES,
APPARENT EASEMENTS, ROADWAYS AND VISIBLE
ENCROACHMENTS, IF ANY, TO THE BEST OF MY
KNOWLEDGE AND BELIEF.

THIS SURVEY IS MADE FOR THE USE OF THE
PRESENT OWNERS OF THE PROPERTY AND ALSO
THOSE WHO PURCHASE, MORTGAGE OR GUARANTEE
THE TITLE THERETO WITHIN ONE (1) YEAR FROM
DATE HEREOF.
SURVEY NOT VALID UNLESS SURVEYOR'S SIGNATURE
IS IN RED.

HAROLD H. KOLB

WISCONSIN REGISTERED LAND SURVEYOR, S-187

DATE JULY 13, 1994

REVISED

REVISED

3-16-S-35

GSPA-35

316-788