
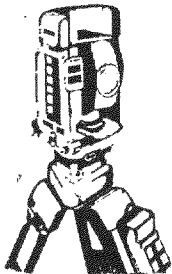
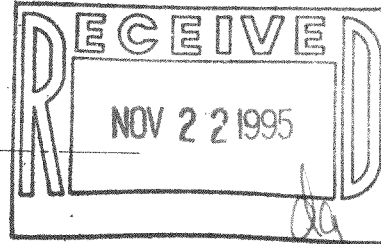


PLAT OF SURVEY
-OF-


LOT 79, BAYWOOD ESTATES THIRD ADDITION, located in the Northeast 1/4 of the Northwest 1/4 of Section 1, Township 3 North, Range 16 East in the Town of Sugar Creek, Walworth County, Wisconsin.

Survey For: Lloyd, Phenicie, Lynch & Kelly, S.C.

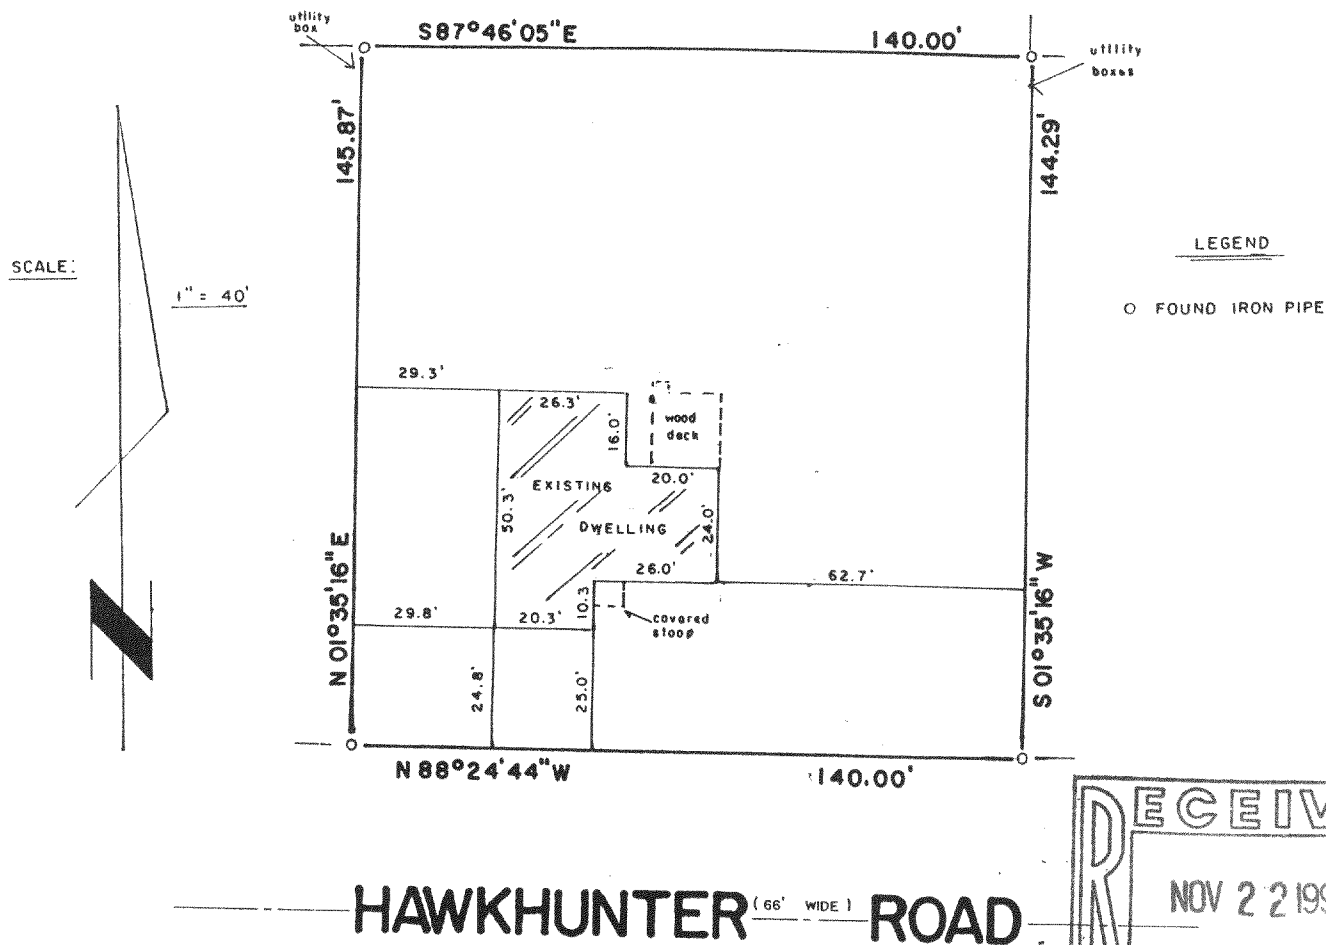

B.W. SURVEYING

Land Surveys
Mapping And Planning
425 Milwaukee Avenue
Burlington, WI 53105
(414) 767-0225

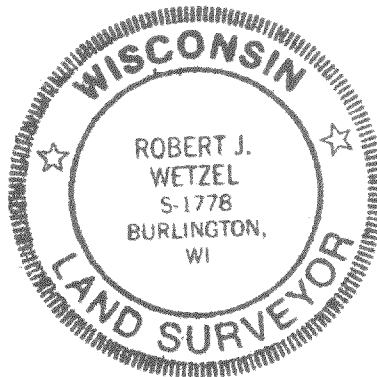

THIS IS NOT AN ORIGINAL PRINT
UNLESS THIS SEAL IS RED

Robert J. Wetzel
ROBERT J. WETZEL
REGISTERED LAND SURVEYOR - 1778

"I hereby certify that I have surveyed the above described property and that the above map is a true representation thereof and shows the size and location of the property, its exterior boundaries, the location of all visible structures and dimensions of all principal buildings thereon, boundary fences, apparent easements, roadways and encroachments, if any."

"This survey is made for the use of the present owners of the property, and those who purchase, mortgage, or guarantee the title thereto within one year from the date hereof."

7/11/95
DATE

2140
JOB NUMBER
316-819

GBEG-10