

ABERNATHY and ASSOCIATES



Kenneth B. Abernathy Jr.

Wisconsin Registered Land Surveyor S-1594

Rt. 3, Box 273
Elkhorn, Wisconsin 53121
Phone: (414) 723 4260 (office)
(414) 723 7209 (FAX)


PLAT OF SURVEY

LOTS 15 THRU 17 INCLUSIVE OF
BLOCK 3 OF LAKE WANDAWEGA
HIGHLANDS SUBDIVISION LOCATED IN
SECTIONS 11 AND 12, TOWN 3 NORTH,
RANGE 16 EAST, TOWN OF SUGAR
CREEK, WALWORTH COUNTY, WISCONSIN.

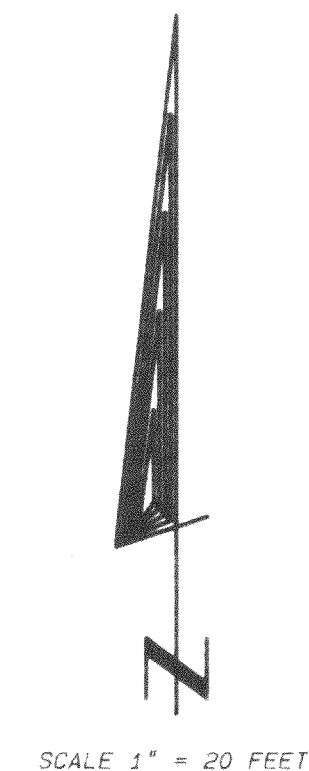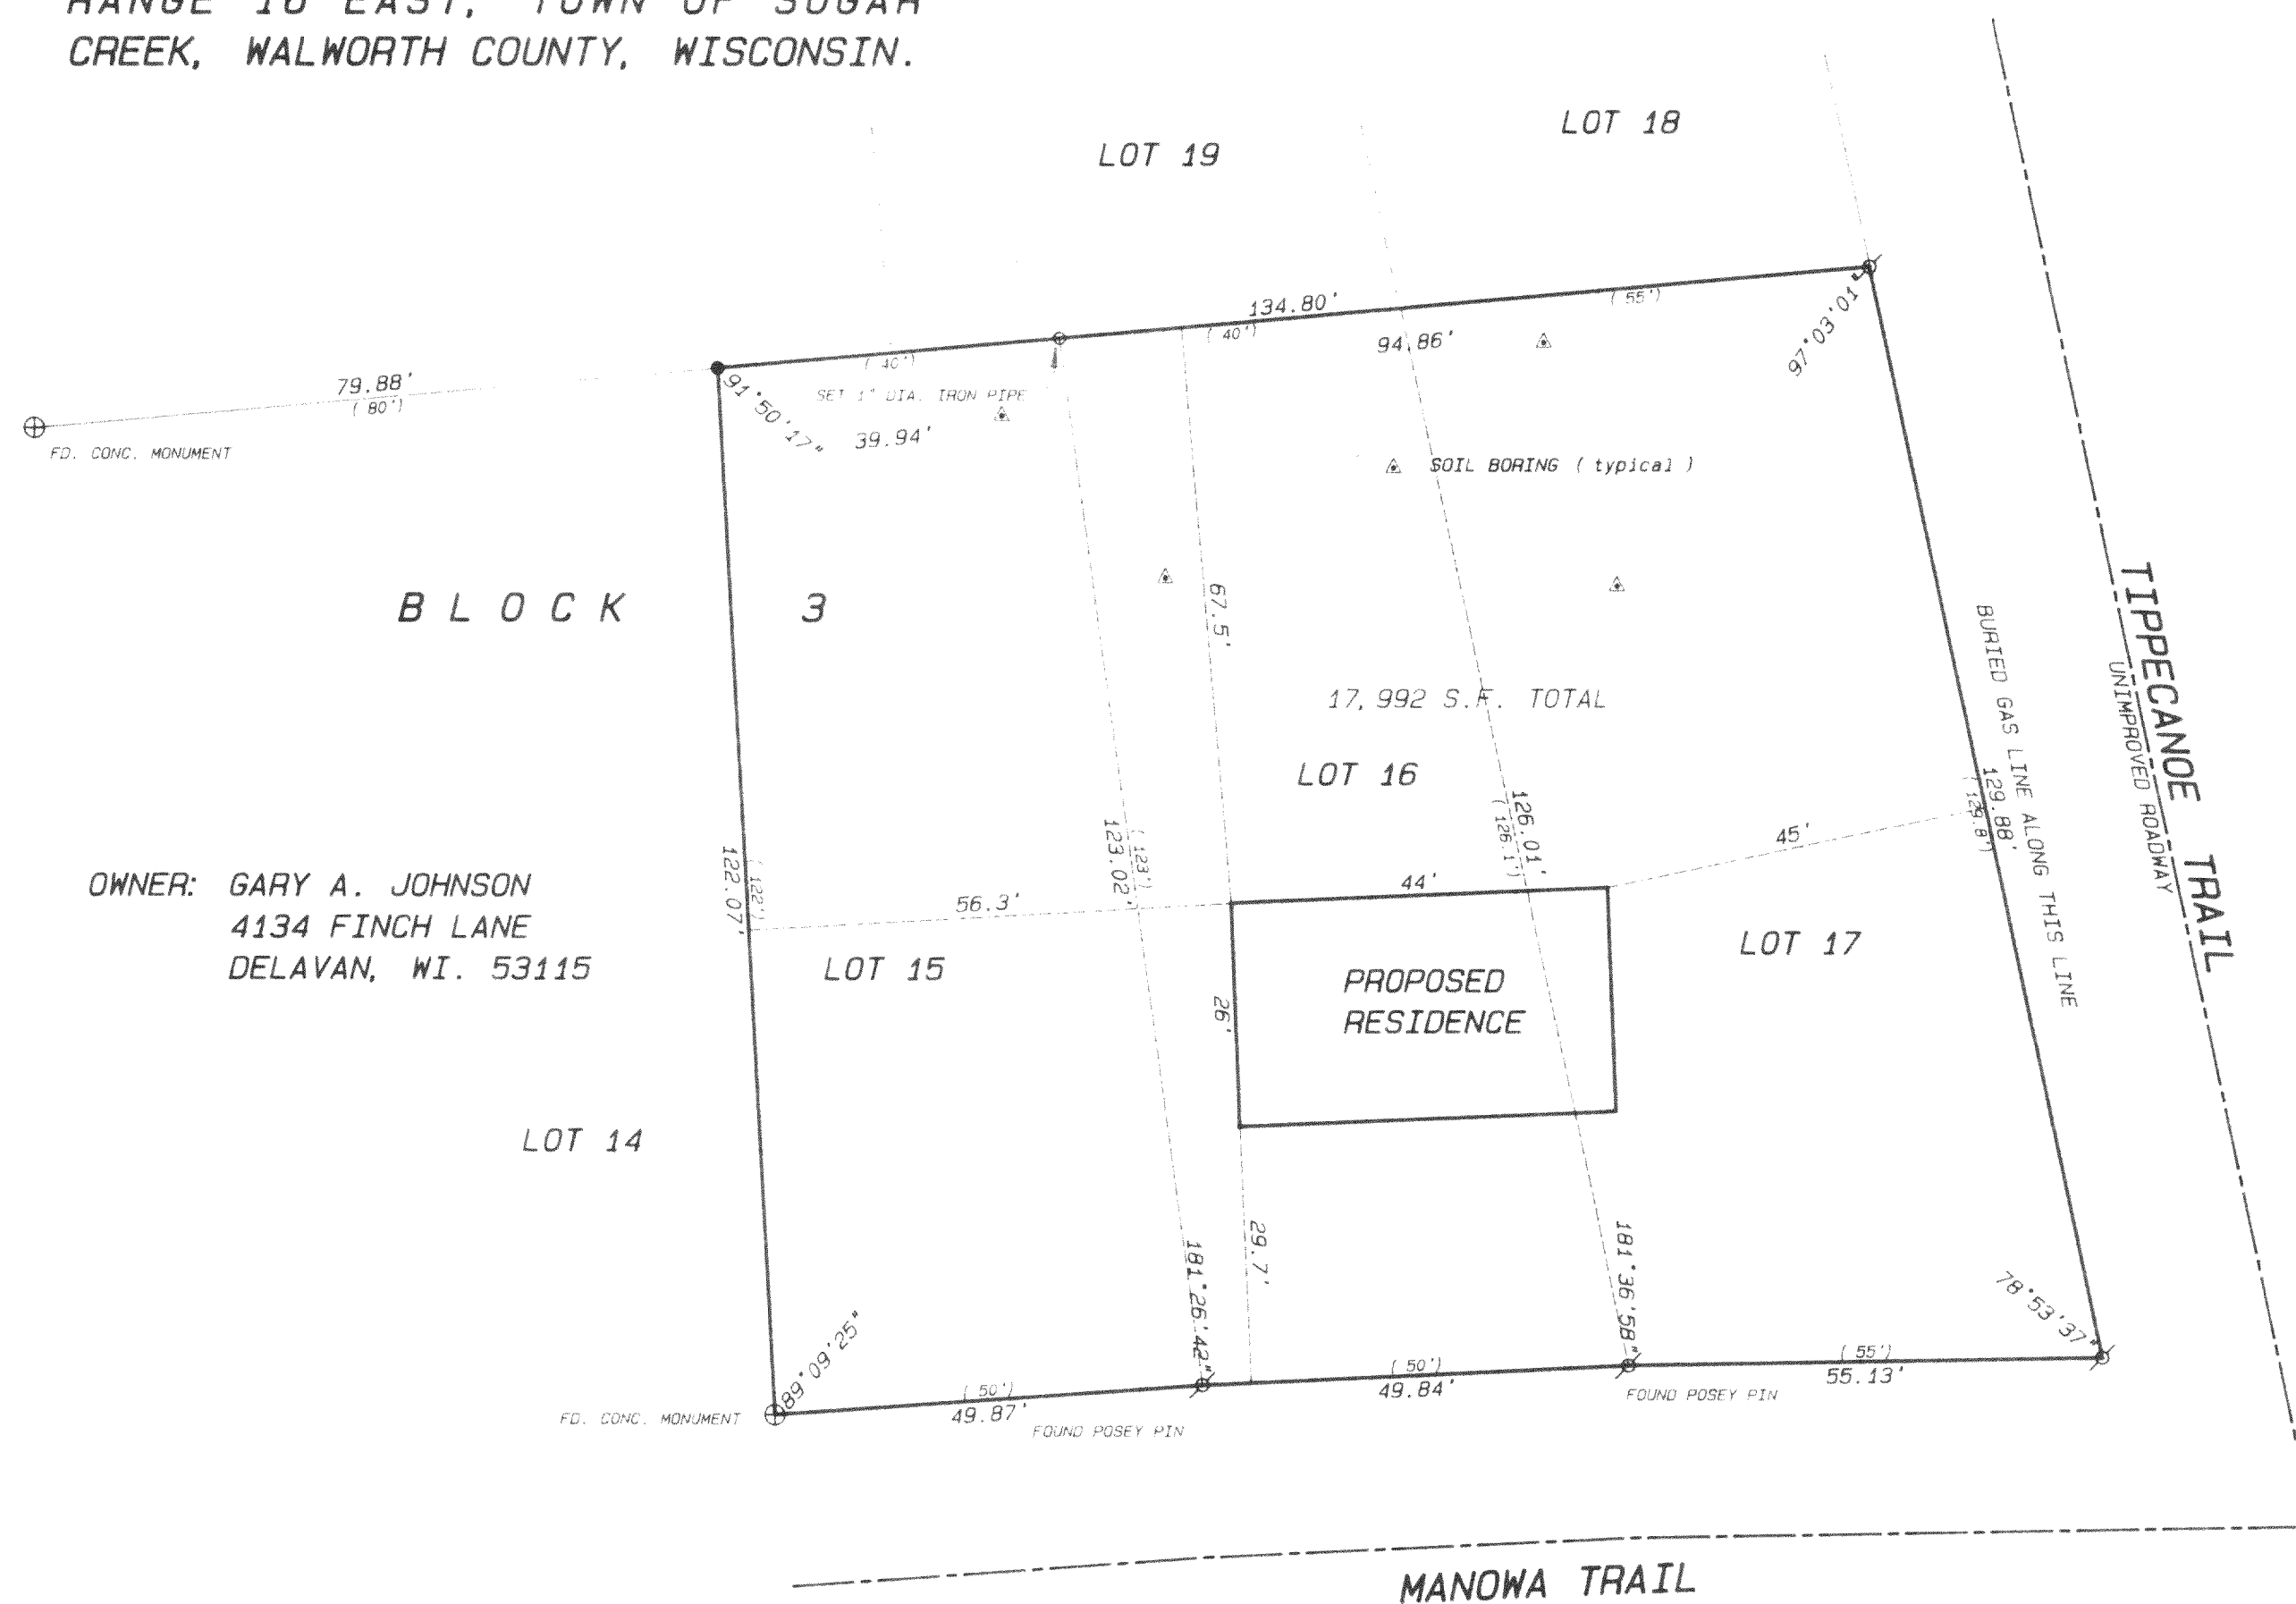


Legend

- FOUND IRON PIPE
- FOUND IRON ROD
- FOUND BRASS CAPPED MONUMENT
- FOUND CONCRETE MONUMENT
- CHISEL CUT IN CONCRETE
- SET IRON ROD, 24" LONG, WEIGHING 1.5 LBS. LINEAL FT., 3/4" DIA.
- SET IRON ROD, 30" LONG, WEIGHING 4.5 LBS. LINEAL FT., 1 1/16" DIA.
- RECORDED AS DIMENSION
- EXISTING FENCE

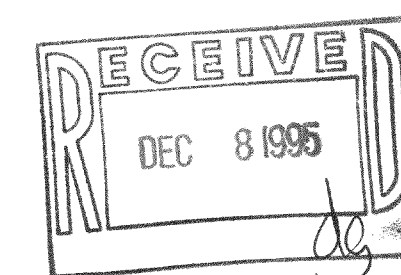

SCALE: 1" = 20 FEET

REVISED 9/19/95
ADDED LOT 15 AND PROPOSED RESIDENCE

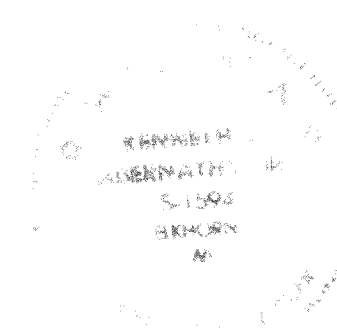

I hereby certify that the above described property has been surveyed by me in accordance with the laws of the State of Wisconsin and that the above map is a true representation thereof and shows the size and location of the property, its exterior boundaries, the location of all visible structures and dimensions of all principal buildings, the area, boundary lines, adjacent interests, easements and visible encroachments, if any.

This survey is made for the use of the present owners of the property, and shall be binding upon them, their heirs, assigns, and all persons claiming through them, from date hereof.

Kenneth B. Abernathy, Jr.
KENNETH B. ABERNATHY, JR.
WISCONSIN REGISTERED LAND SURVEYOR,
S-1594

Date: DEC. 21, 1994 Job No. 94.1212

GWH-41
GWH-42
GWH-43

316-829