

316-831


316-83B

BARLEY ROAD

50°

DAISY ROAD

50°

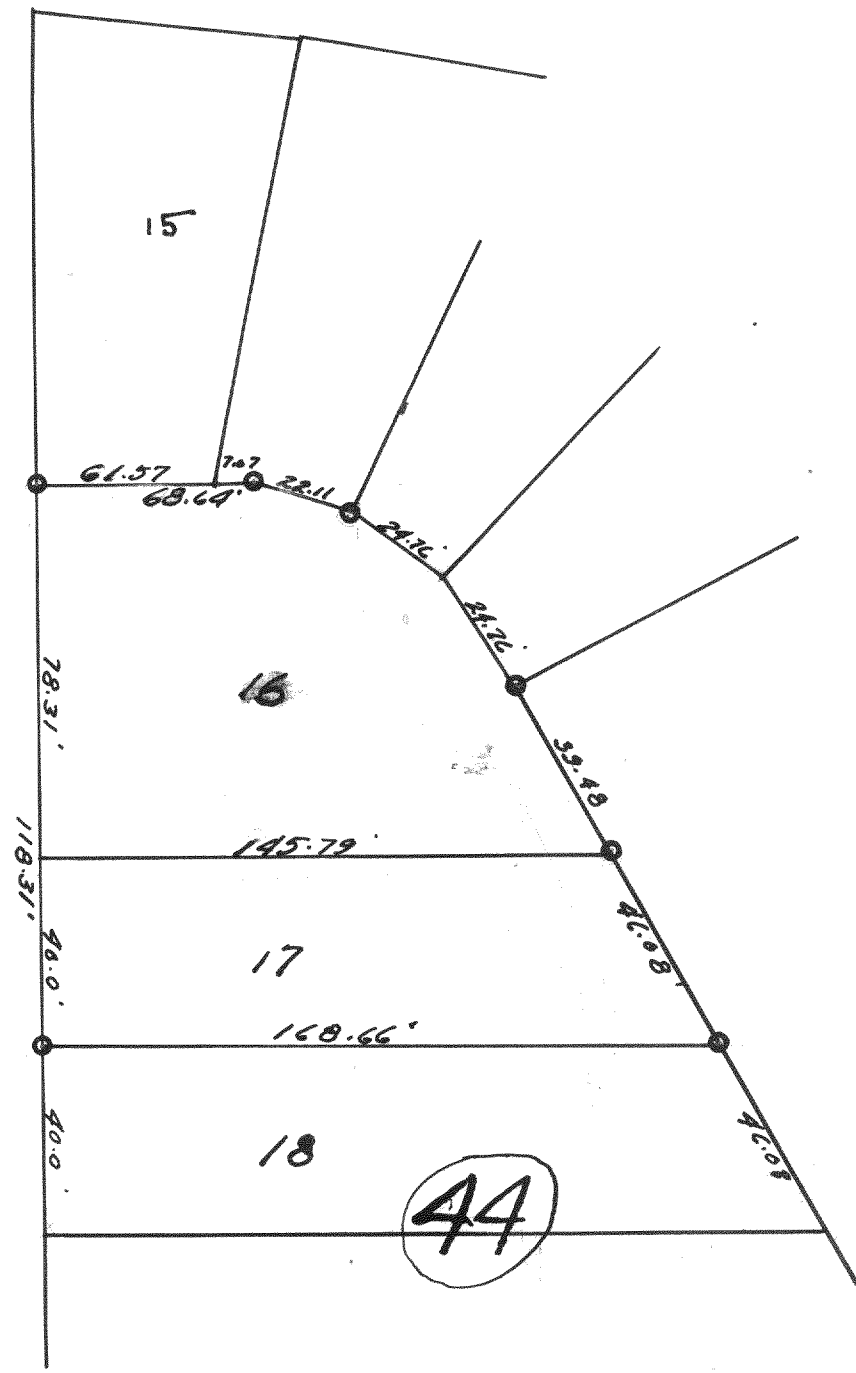

DESCRIPTION:

Lots 16 and 17 Block 44 of the 4th Map of Interlaken Subdivision of a portion of Section 11, Town 3 north, Range 16 east of the 4th Principal Meridian.

CERTIFICATE:

I, hereby certify that I have on this the 28th day of June 1952, surveyed the above described property and that the above portrayed plat is a true and correct reproduction of said survey.  
SIGNED AND SEALED ON THIS THE 30TH DAY OF JUNE 1952.

Joseph M. Biagi, Professional Engineer  
Elkhorn Wisconsin.

316-83B

61-407

316-83B