
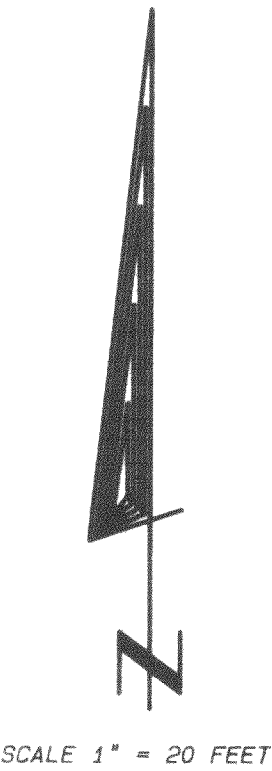


PLAT OF SURVEY


PLAT OF SURVEY OF LOTS 1 - 8
INCLUSIVE OF BLOCK 1 OF NORTH
LAKE BEACH TRACT NO. 3,
LOCATED IN THE SOUTHEAST 1/4
OF SECTION 5, TOWN 3 NORTH,
RANGE 16 EAST, WALWORTH COUNTY.

S & S PARTNERSHIP
C/O CARL GUSTAFSON
ERA CORNER REALTY
5362 STATE ROAD "11"
ELKHORN, WIS. 53121


BROKERS REFERENCE: PARCEL NO. 3

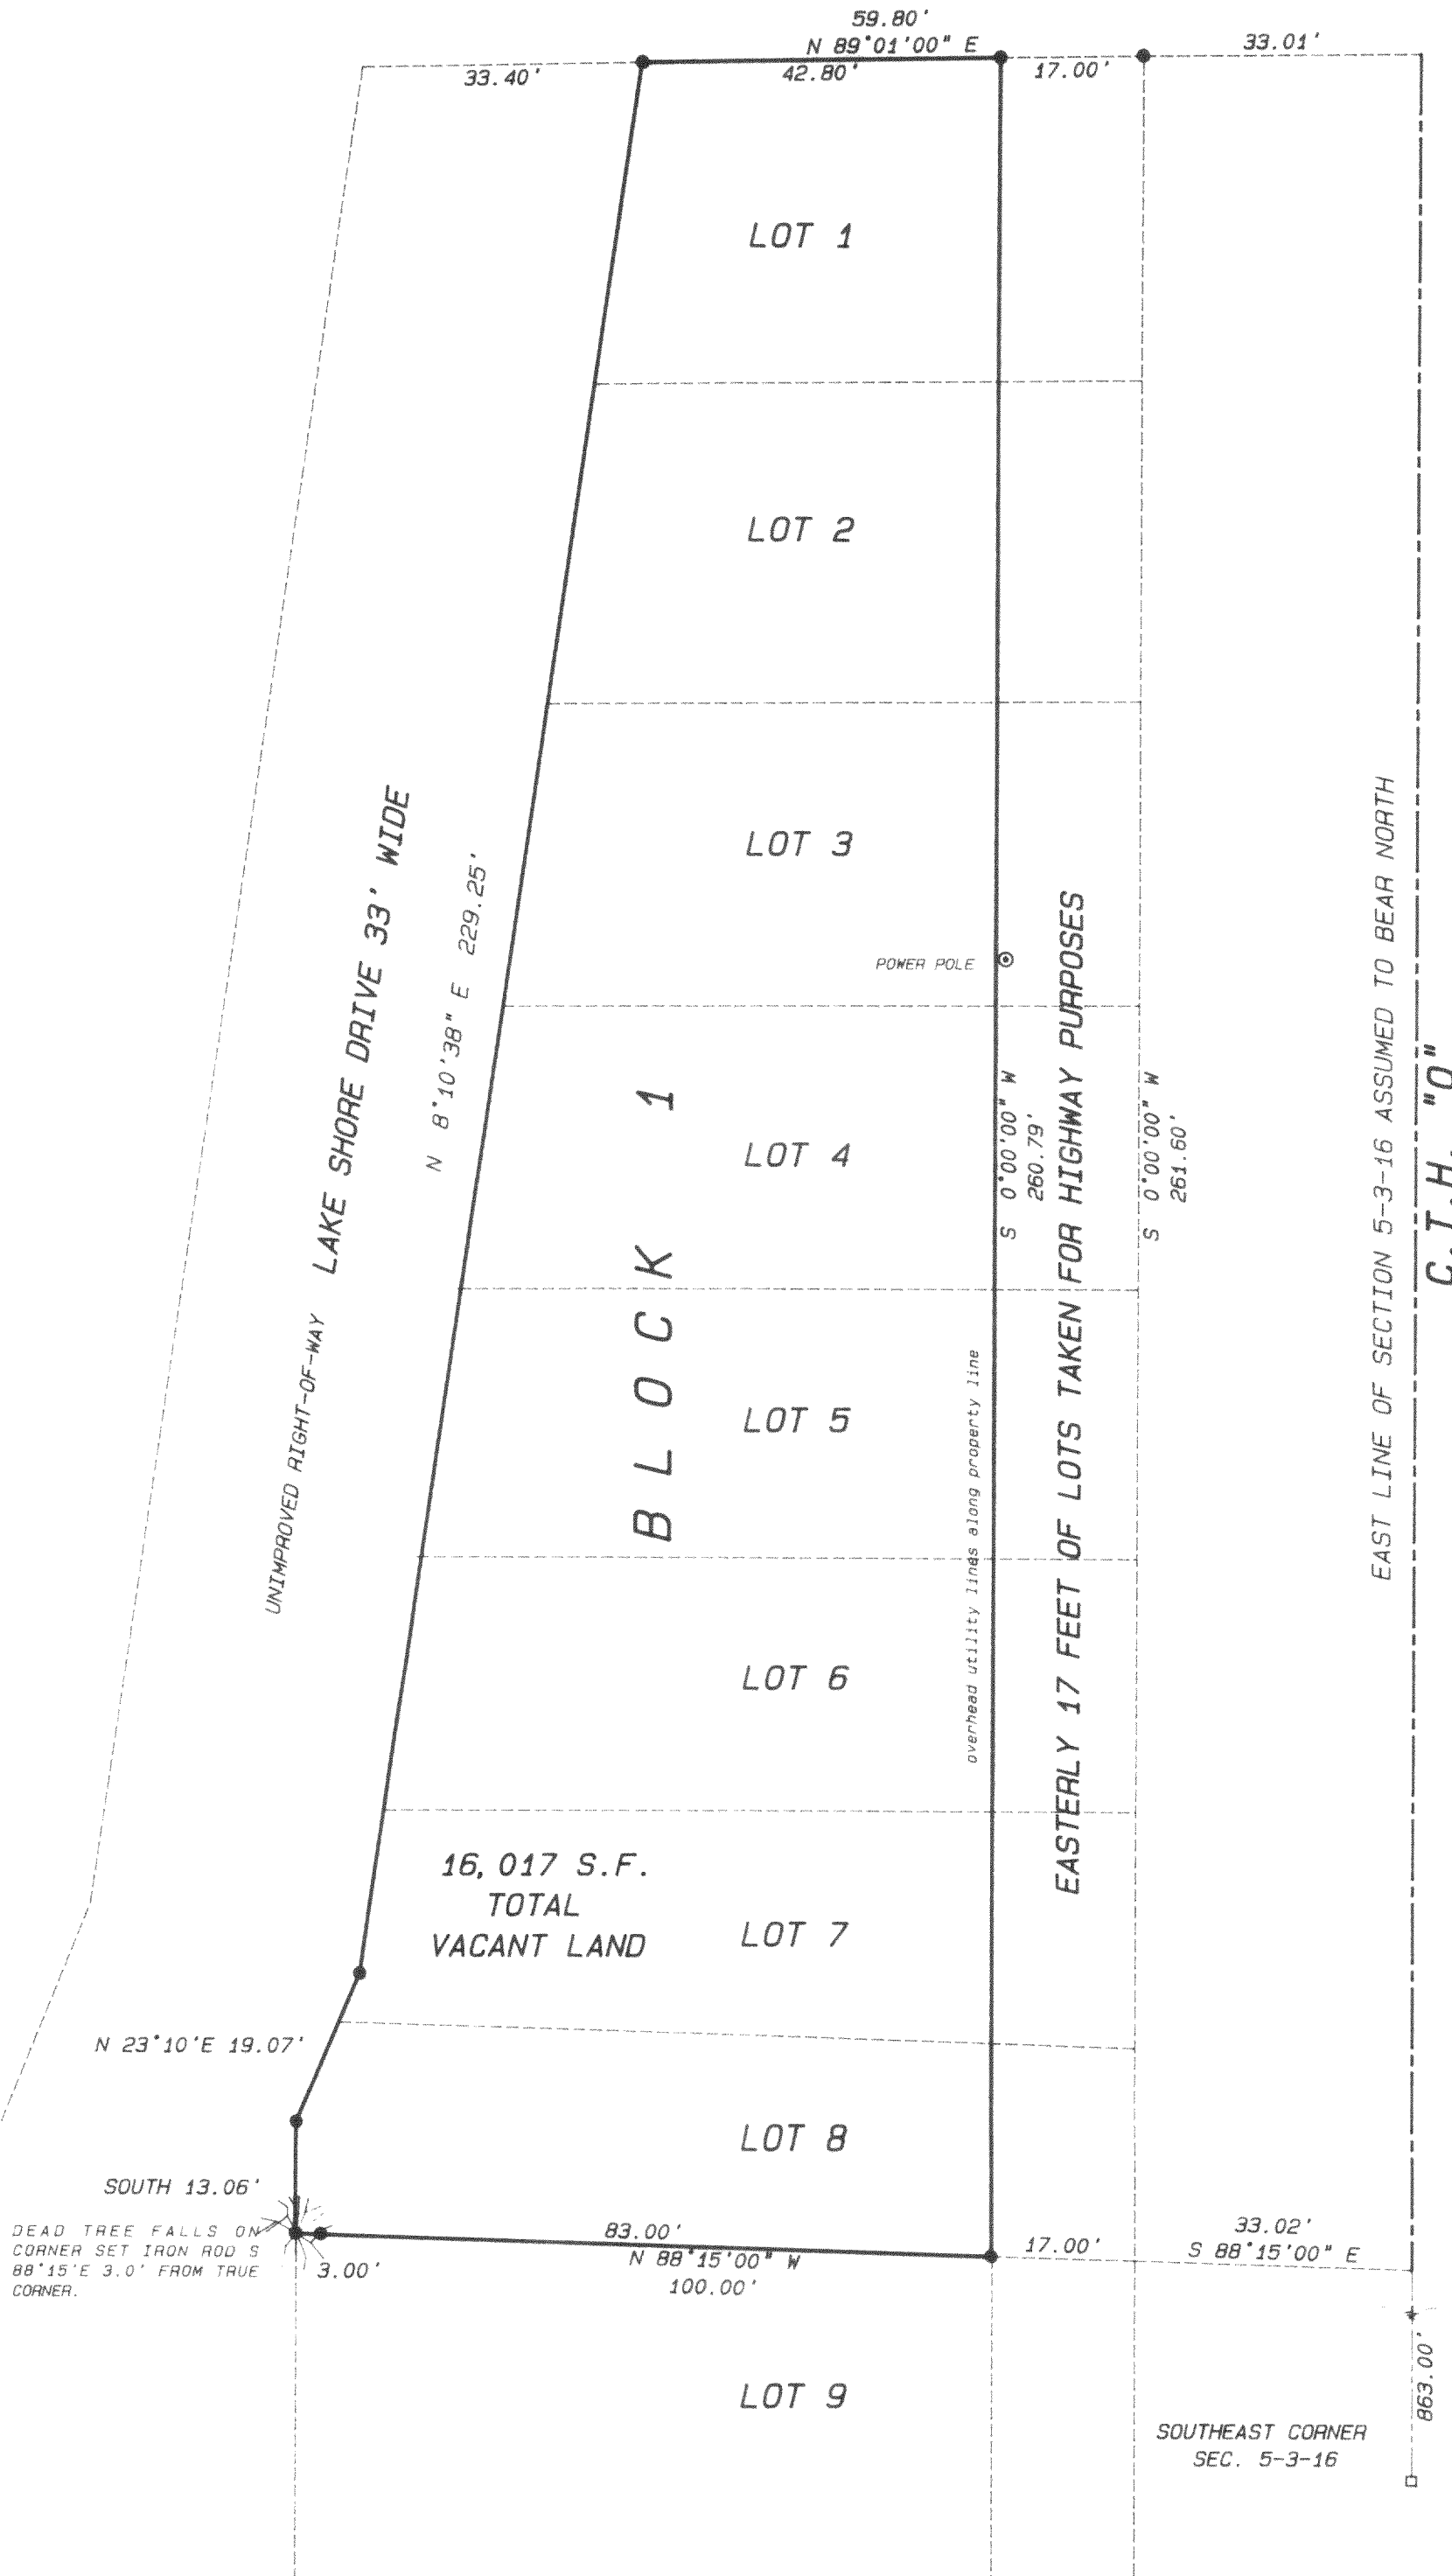

- Legend
- FOUND IRON PIPE
 - FOUND IRON ROD
 - FOUND BRASS CAPPED MONUMENT
 - FOUND CONCRETE MONUMENT
 - CHISEL CUT IN CONCRETE
 - SET IRON ROD, 24" LONG, WEIGHING 1.5 LBS. LINEAL FT., 3/4" DIA.
 - SET IRON ROD, 30" LONG, WEIGHING 4.5 LBS. LINEAL FT., 1-11/16" DIA.
 - RECORDED AS DIMENSION
 - EXISTING FENCE

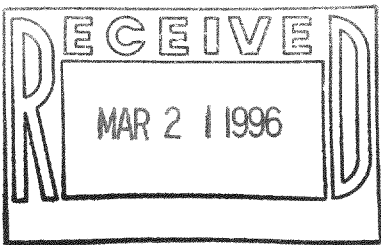

SCALE: 1"= 20 FEET

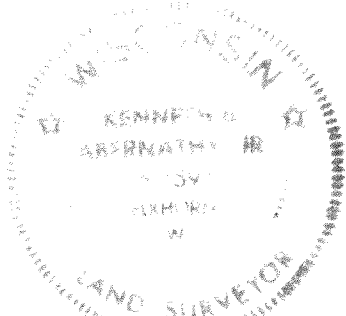

"I hereby certify that the above described property has been surveyed by me or under my direction and that the above map is a true representation thereof and shows the size and location of the property, its exterior boundaries, the location of all visible structures and dimensions of all principal buildings thereon, boundary fences, apparent easements, roadways and visible encroachments, if any."

"This survey is made for the use of the present owners of the property, and also those who purchase, mortgage, or guarantee the title thereto within one year from date hereof."

Kenneth B. Abernathy, Jr.
KENNETH B. ABERNATHY, JR.,
WISCONSIN REGISTERED LAND SURVEYOR,
S-1594
Date: MARCH 5, 1996 Job No. 96.615

GNLB3-342
316-871