

ABERNATHY and ASSOCIATES

Kenneth B. Abernathy Jr.

Wisconsin Registered Land Surveyor S-1594


Rt. 3, Box 273
Elkhorn, Wisconsin 53121
Phone: (414) 723-4260 (office)
(414) 723-7209 (FAX)

PLAT OF SURVEY

The Northeastly 1/2 of Lot 22, and all of Lots 23, 24, and 25 in Block 33 of Interlaken Subdivision, Town of Sugar Creek, according to the recorded plat thereof.

Owner: Egofske-Porter Drilling, Inc.

Ordered by: Don M. & Betty Jeziorski
Broker/Owners
Glacier Realty
W5109 County Road "A"
Elkhorn, Wisconsin 53121

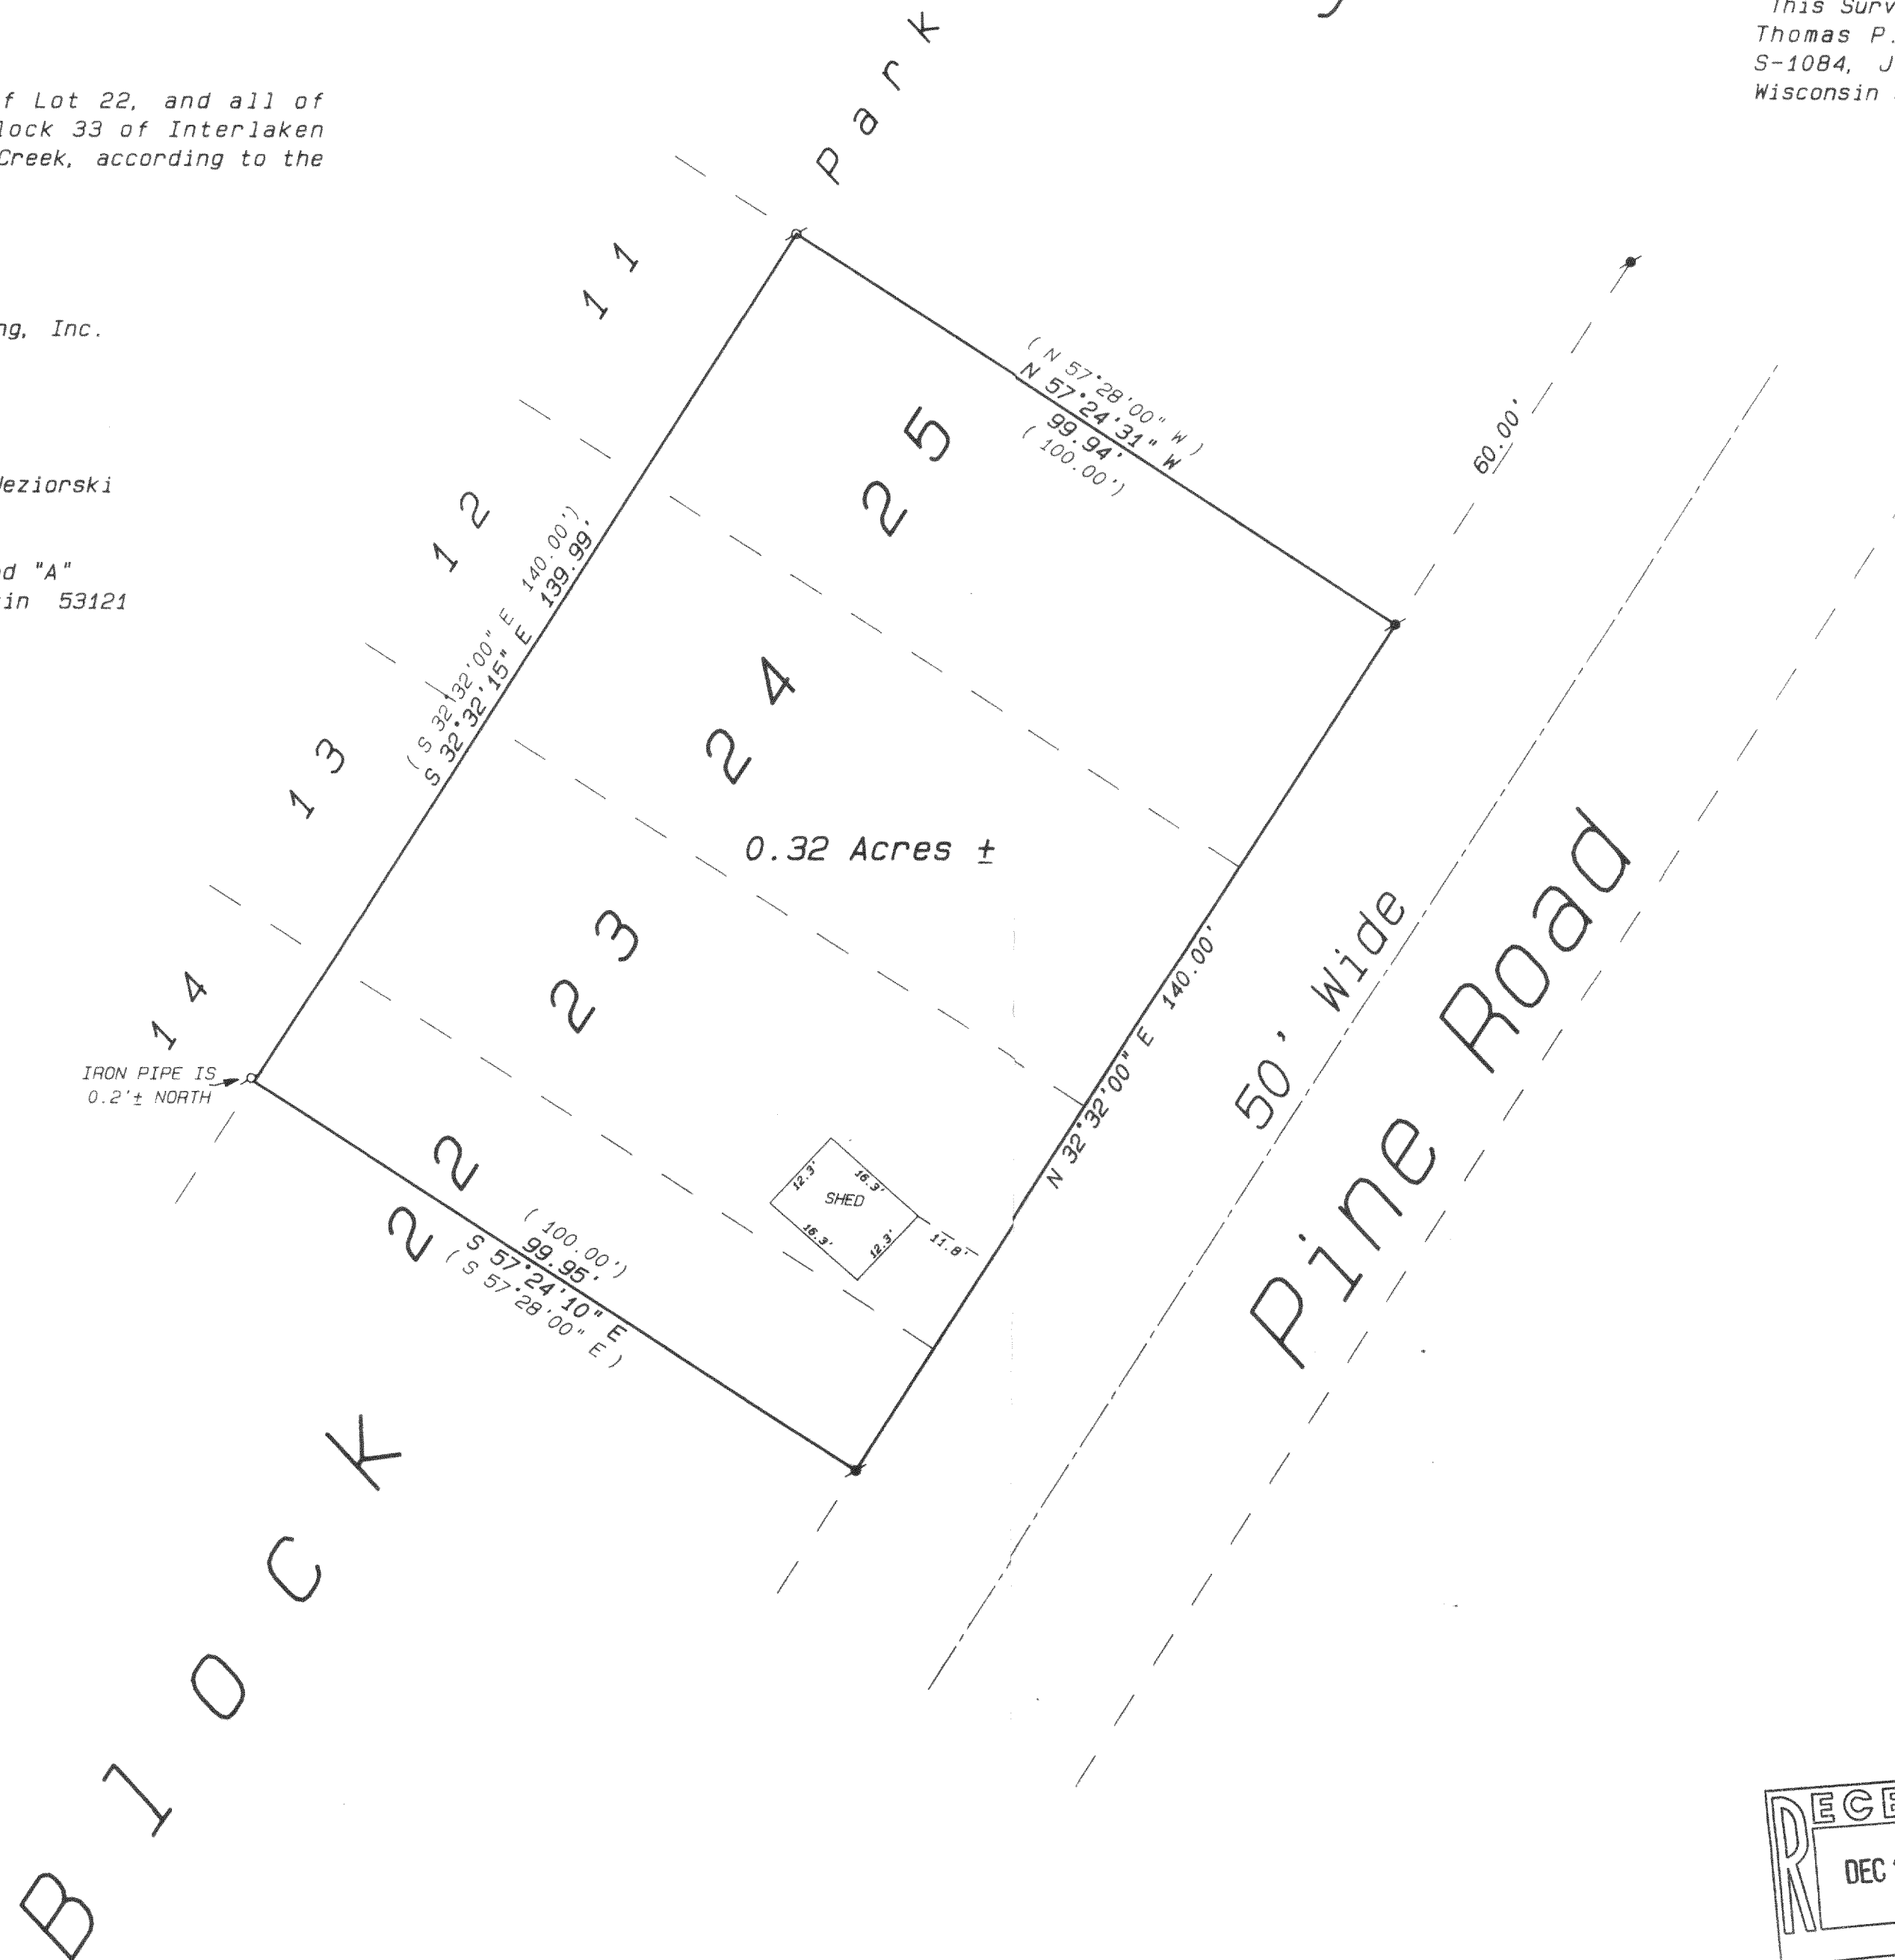


NOTE


This Survey retraces a previous Plat of Survey by Thomas P.A. Jensen, Wisconsin Land Surveyor S-1084, Jensen Surveying and Mapping, Elkhorn, Wisconsin 53121, Dated July 1978.

Legend

- FOUND IRON PIPE
- FOUND IRON ROD
- FOUND BRASS CAPPED MONUMENT
- FOUND CONCRETE MONUMENT
- CHISEL CUT IN CONCRETE
- SET IRON ROD, 24" LONG, WEIGHING 1.5 LBS./LINEAL FT., 3/4" DIA.
- SET IRON ROD, 30" LONG, WEIGHING 4.5 LBS./LINEAL FT., 1-11/16" DIA.
- RECORDED AS DIMENSION
- EXISTING FENCE

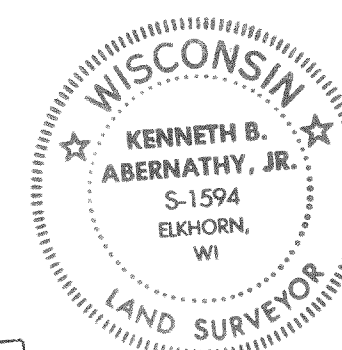

SCALE: 1" = 20 FEET

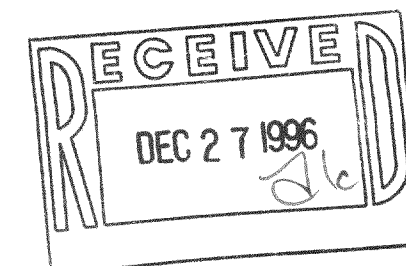

"I hereby certify that the above described property has been surveyed by me or under my direction and that the above map is a true representation thereof and shows the size and location of the property, its exterior boundaries, the location of all visible structures and dimensions of all principal buildings thereon, boundary fences, apparent easements, roadways and visible encroachments, if any."

"This survey is made for the use of the present owners of the property, and also those who purchase, mortgage, or guarantee the title thereto within one year from date hereof."

Kenneth B. Abernathy, Jr.

KENNETH B. ABERNATHY, JR.
WISCONSIN REGISTERED LAND SURVEYOR,
S-1594

Date: October 2, 1996 Job No. 1996.921

GI-291

316-886