

PLAT OF SURVEY

WORK ORDERED BY ---  
GENE SCHILTS  
P.O. BOX 378  
ELKHORN, WISCONSIN 53121


FARRIS, HANSEN & ASSOCIATES, INC.  
Engineering, Architecture, Surveying  
7 Ridgway Court P.O. Box 437  
ELKHORN, WISCONSIN 53121  
Office: (414) 723-2098  
Fax: (414) 723-5886

REVISIONS

PROJECT NO.  
4643  
DATE  
11/14/96  
SHEET NO.  
1 OF 1

PLAT OF SURVEY

LOTS 7 THRU 17 OF BLOCK 36  
& LOTS 1 THRU 8, THE WEST 1/2 OF LOT 11, & LOTS 12 THRU 15  
OF BLOCK 31  
INTERLAKEN SUBDIVISION, ACCORDING TO THE RECORDED PLAT  
THEREOF, WALWORTH COUNTY, WISCONSIN


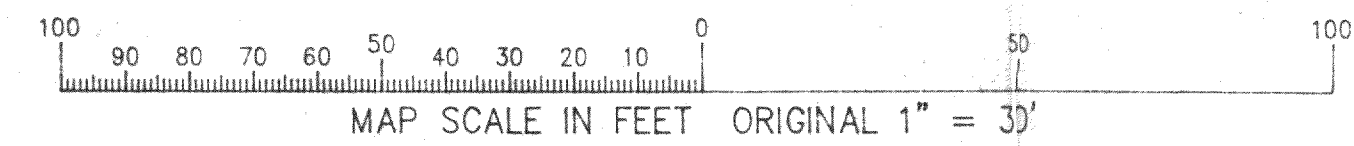


NOTE: COPIES OF THIS MAP TO WHICH THE FOLLOWING CERTIFICATE  
WILL APPLY ARE BLUE LINE PRINTS SHOWING SURVEYOR'S ORIGINAL  
SEAL AND SIGNATURE IN BLACK INK. COPIES BY ANY OTHER MEANS  
MAY HAVE ALTERATIONS WHICH DO NOT REPRESENT THE SURVEYOR'S  
WORK PRODUCT.

I HEREBY CERTIFY THAT THE ABOVE DESCRIBED PROPERTY HAS BEEN  
SURVEYED UNDER MY DIRECTION AND THAT THE ABOVE MAP IS A TRUE  
REPRESENTATION THEREOF AND SHOWS THE SIZE AND LOCATION OF  
THE PROPERTY AND ITS EXTERIOR BOUNDARIES. THIS SURVEY IS  
MADE FOR THE USE OF THE PRESENT OWNERS OF THE PROPERTY, AND  
ALSO THOSE WHO PURCHASE, MORTGAGE, OR GUARANTEE THE TITLE  
THERE TO WITHIN ONE YEAR FROM THE DATE HEREOF.



DATED: 11-14-96

PETER S. GORDON R.L.S. 2101

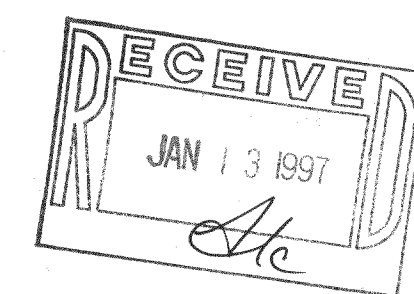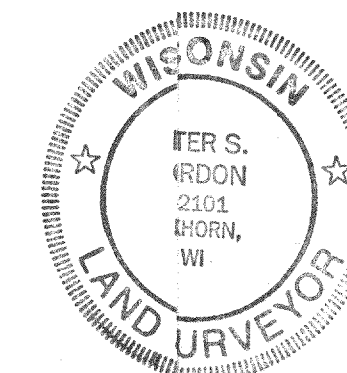

LEGEND

- = FOUND IRON PIPE STAKE
- = FOUND IRON REBAR STAKE
- ⦿ = SET IRON REBAR STAKE
- (XXX) = RECORDED AS

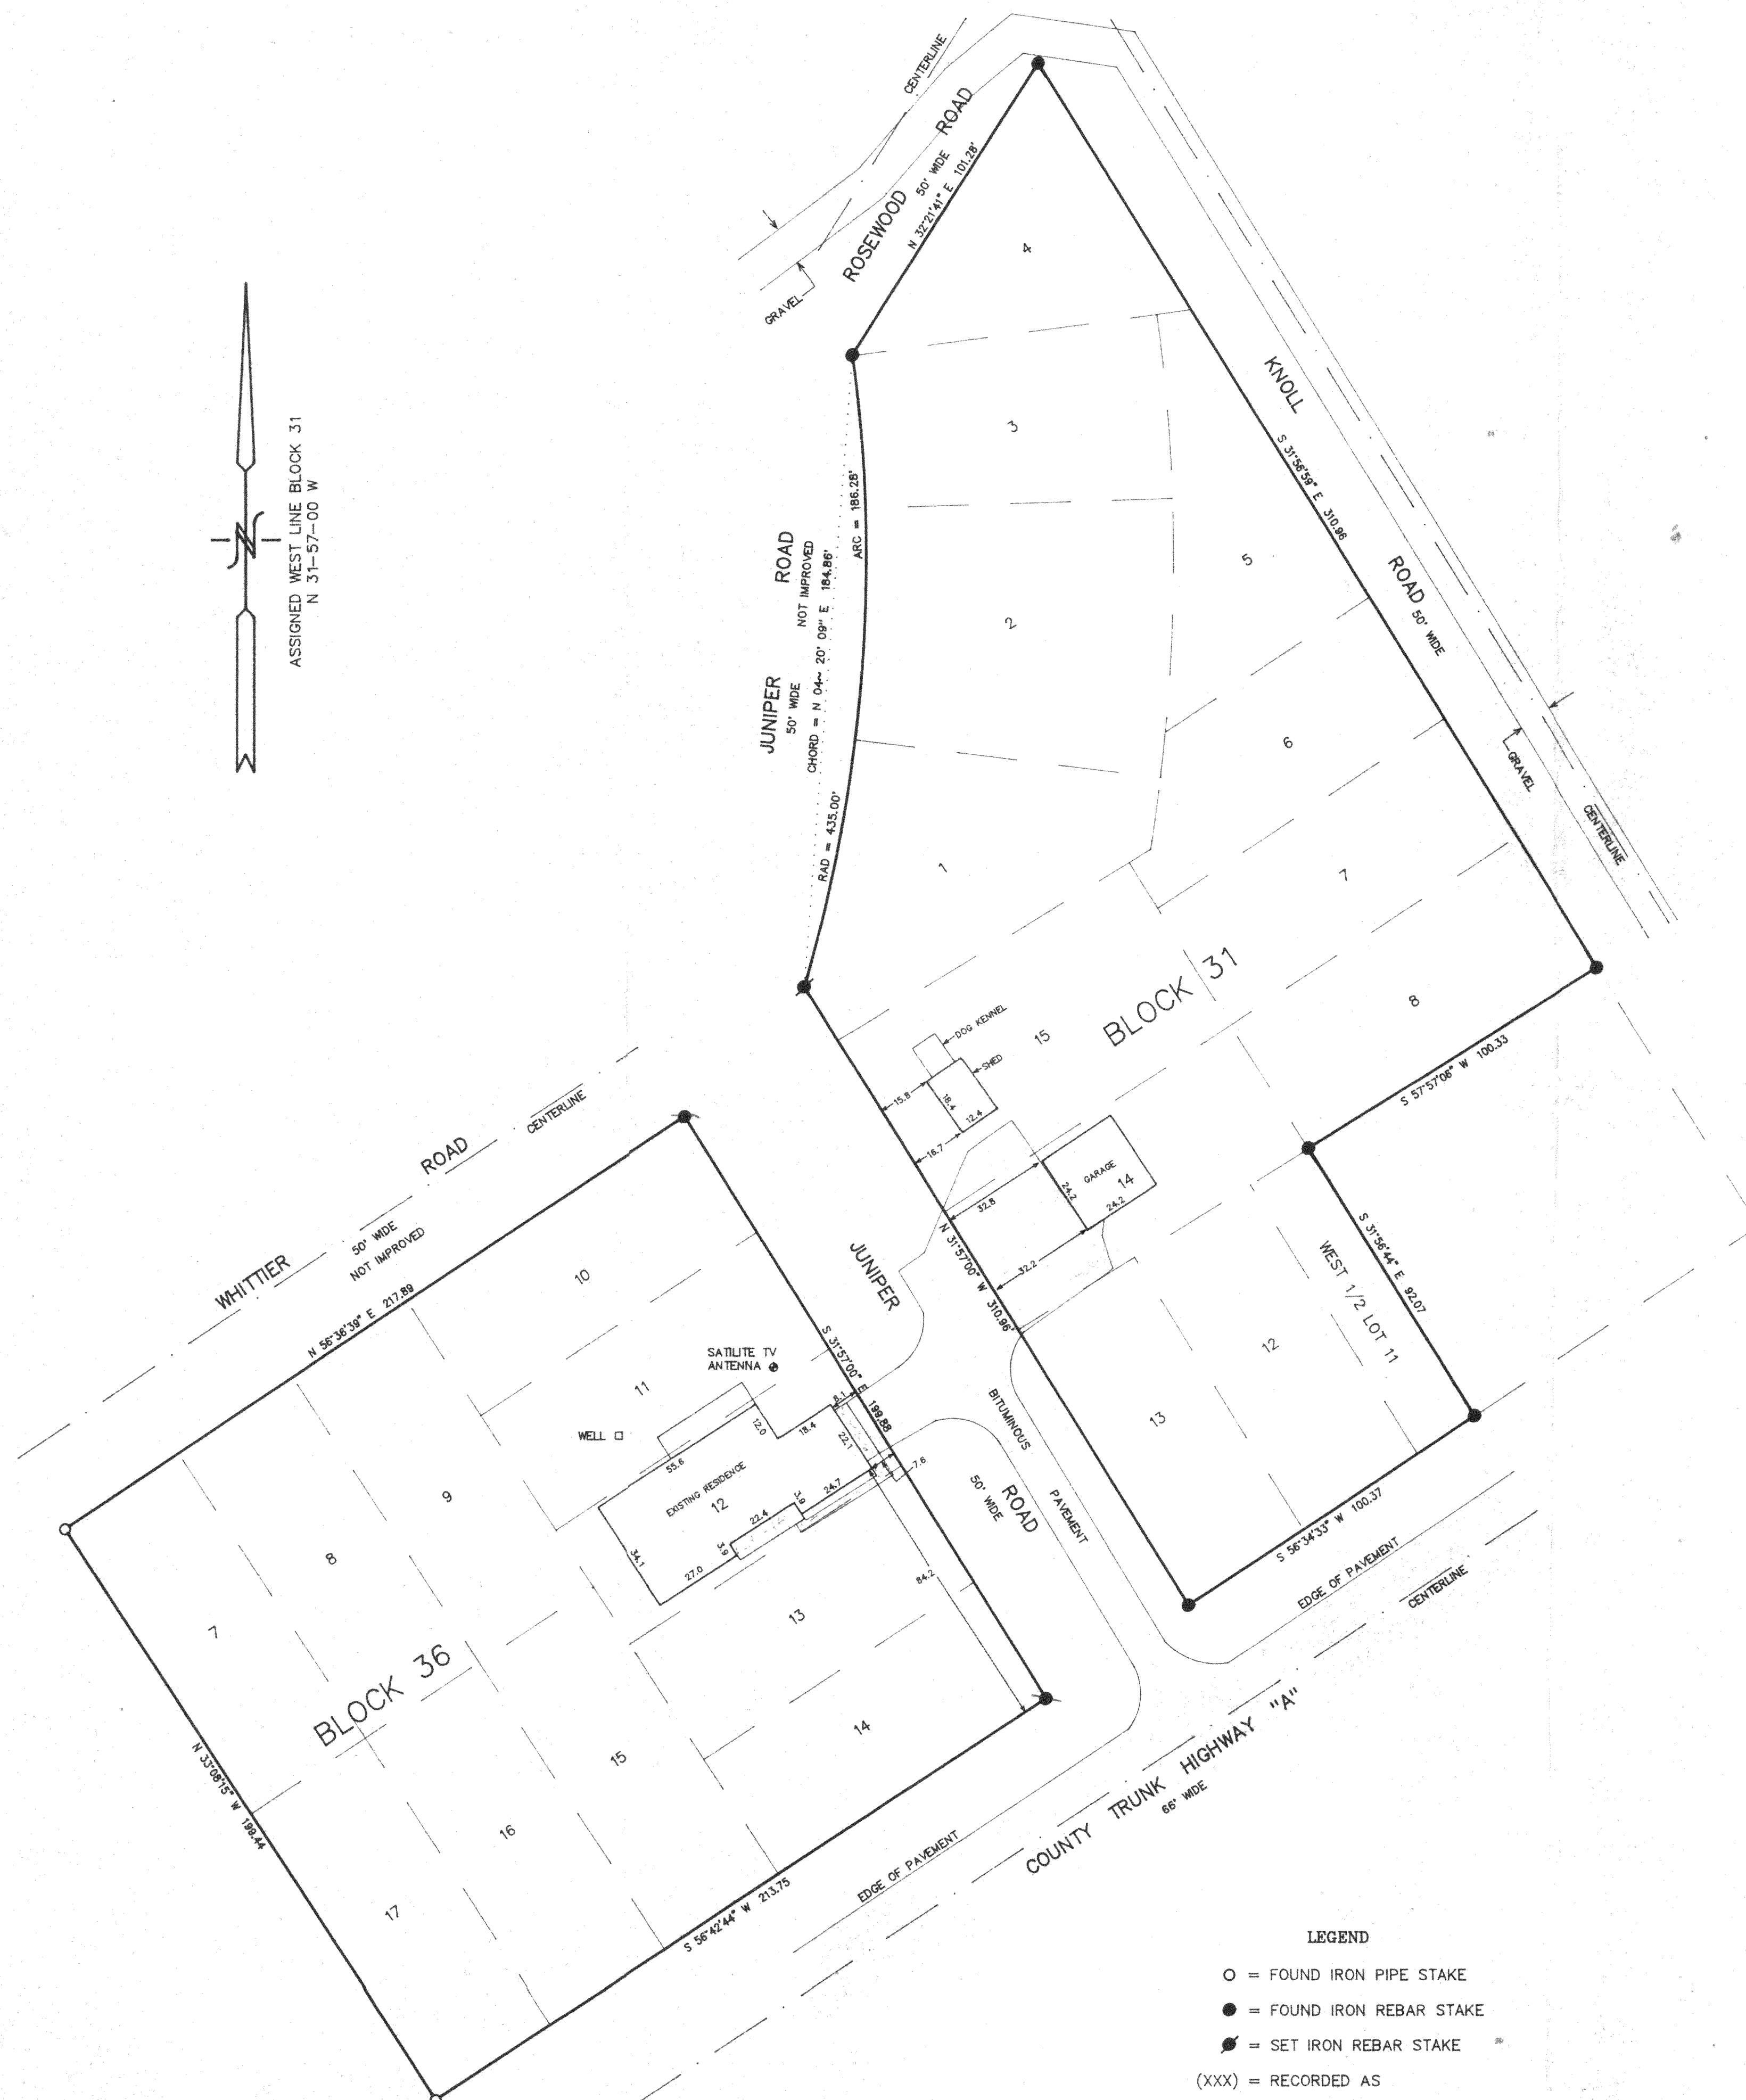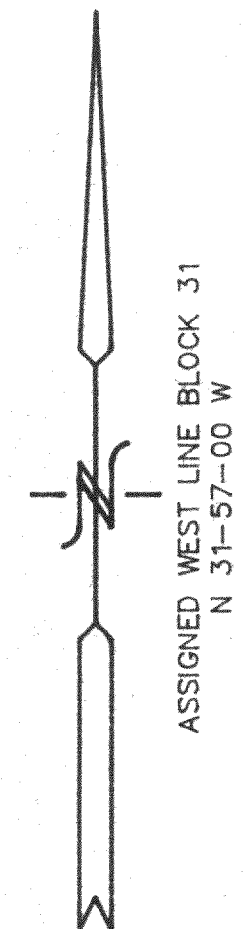

II-319  
II-320  
II-321  
II-278  
II-278A  
II-280

GI-281  
316-902