

ABERNATHY and ASSOCIATES

Kenneth B. Abernathy Jr.

Wisconsin Registered Land Surveyor S-1594

Rt. 3, Box 273
Elkhorn, Wisconsin 53121
Phone: (414) 723 4260 (office)
(414) 723-7209 (FAX)


PLAT OF SURVEY

LOT 2 OF CERTIFIED SURVEY MAP NUMBER 2658 AS RECORDED IN VOL. 13 AS PAGES 239 AND 240 AS DOCUMENT NO. 318057 BEING LOCATED IN PART OF THE NORTHEAST 1/4 AND THE SOUTHEAST 1/4 OF THE NORTHWEST 1/4 OF SECTION 6, TOWN 3 NORTH, RANGE 16 EAST, TOWN OF SUGAR CREEK, WALWORTH COUNTY, WISCONSIN.

BENCHMARK ELEV. = 100.00'
NAIL & ORANGE RIBBON IN
UTILITY POLE APPROX. 40'
FROM GROUND LEVEL


ORDERED BY: TOM KOLAFA BUILDERS, INC.
P.O. BOX 331
WAUKESHA, WI. 53188

CLIENT REFERENCE: SELBY RESIDENCE

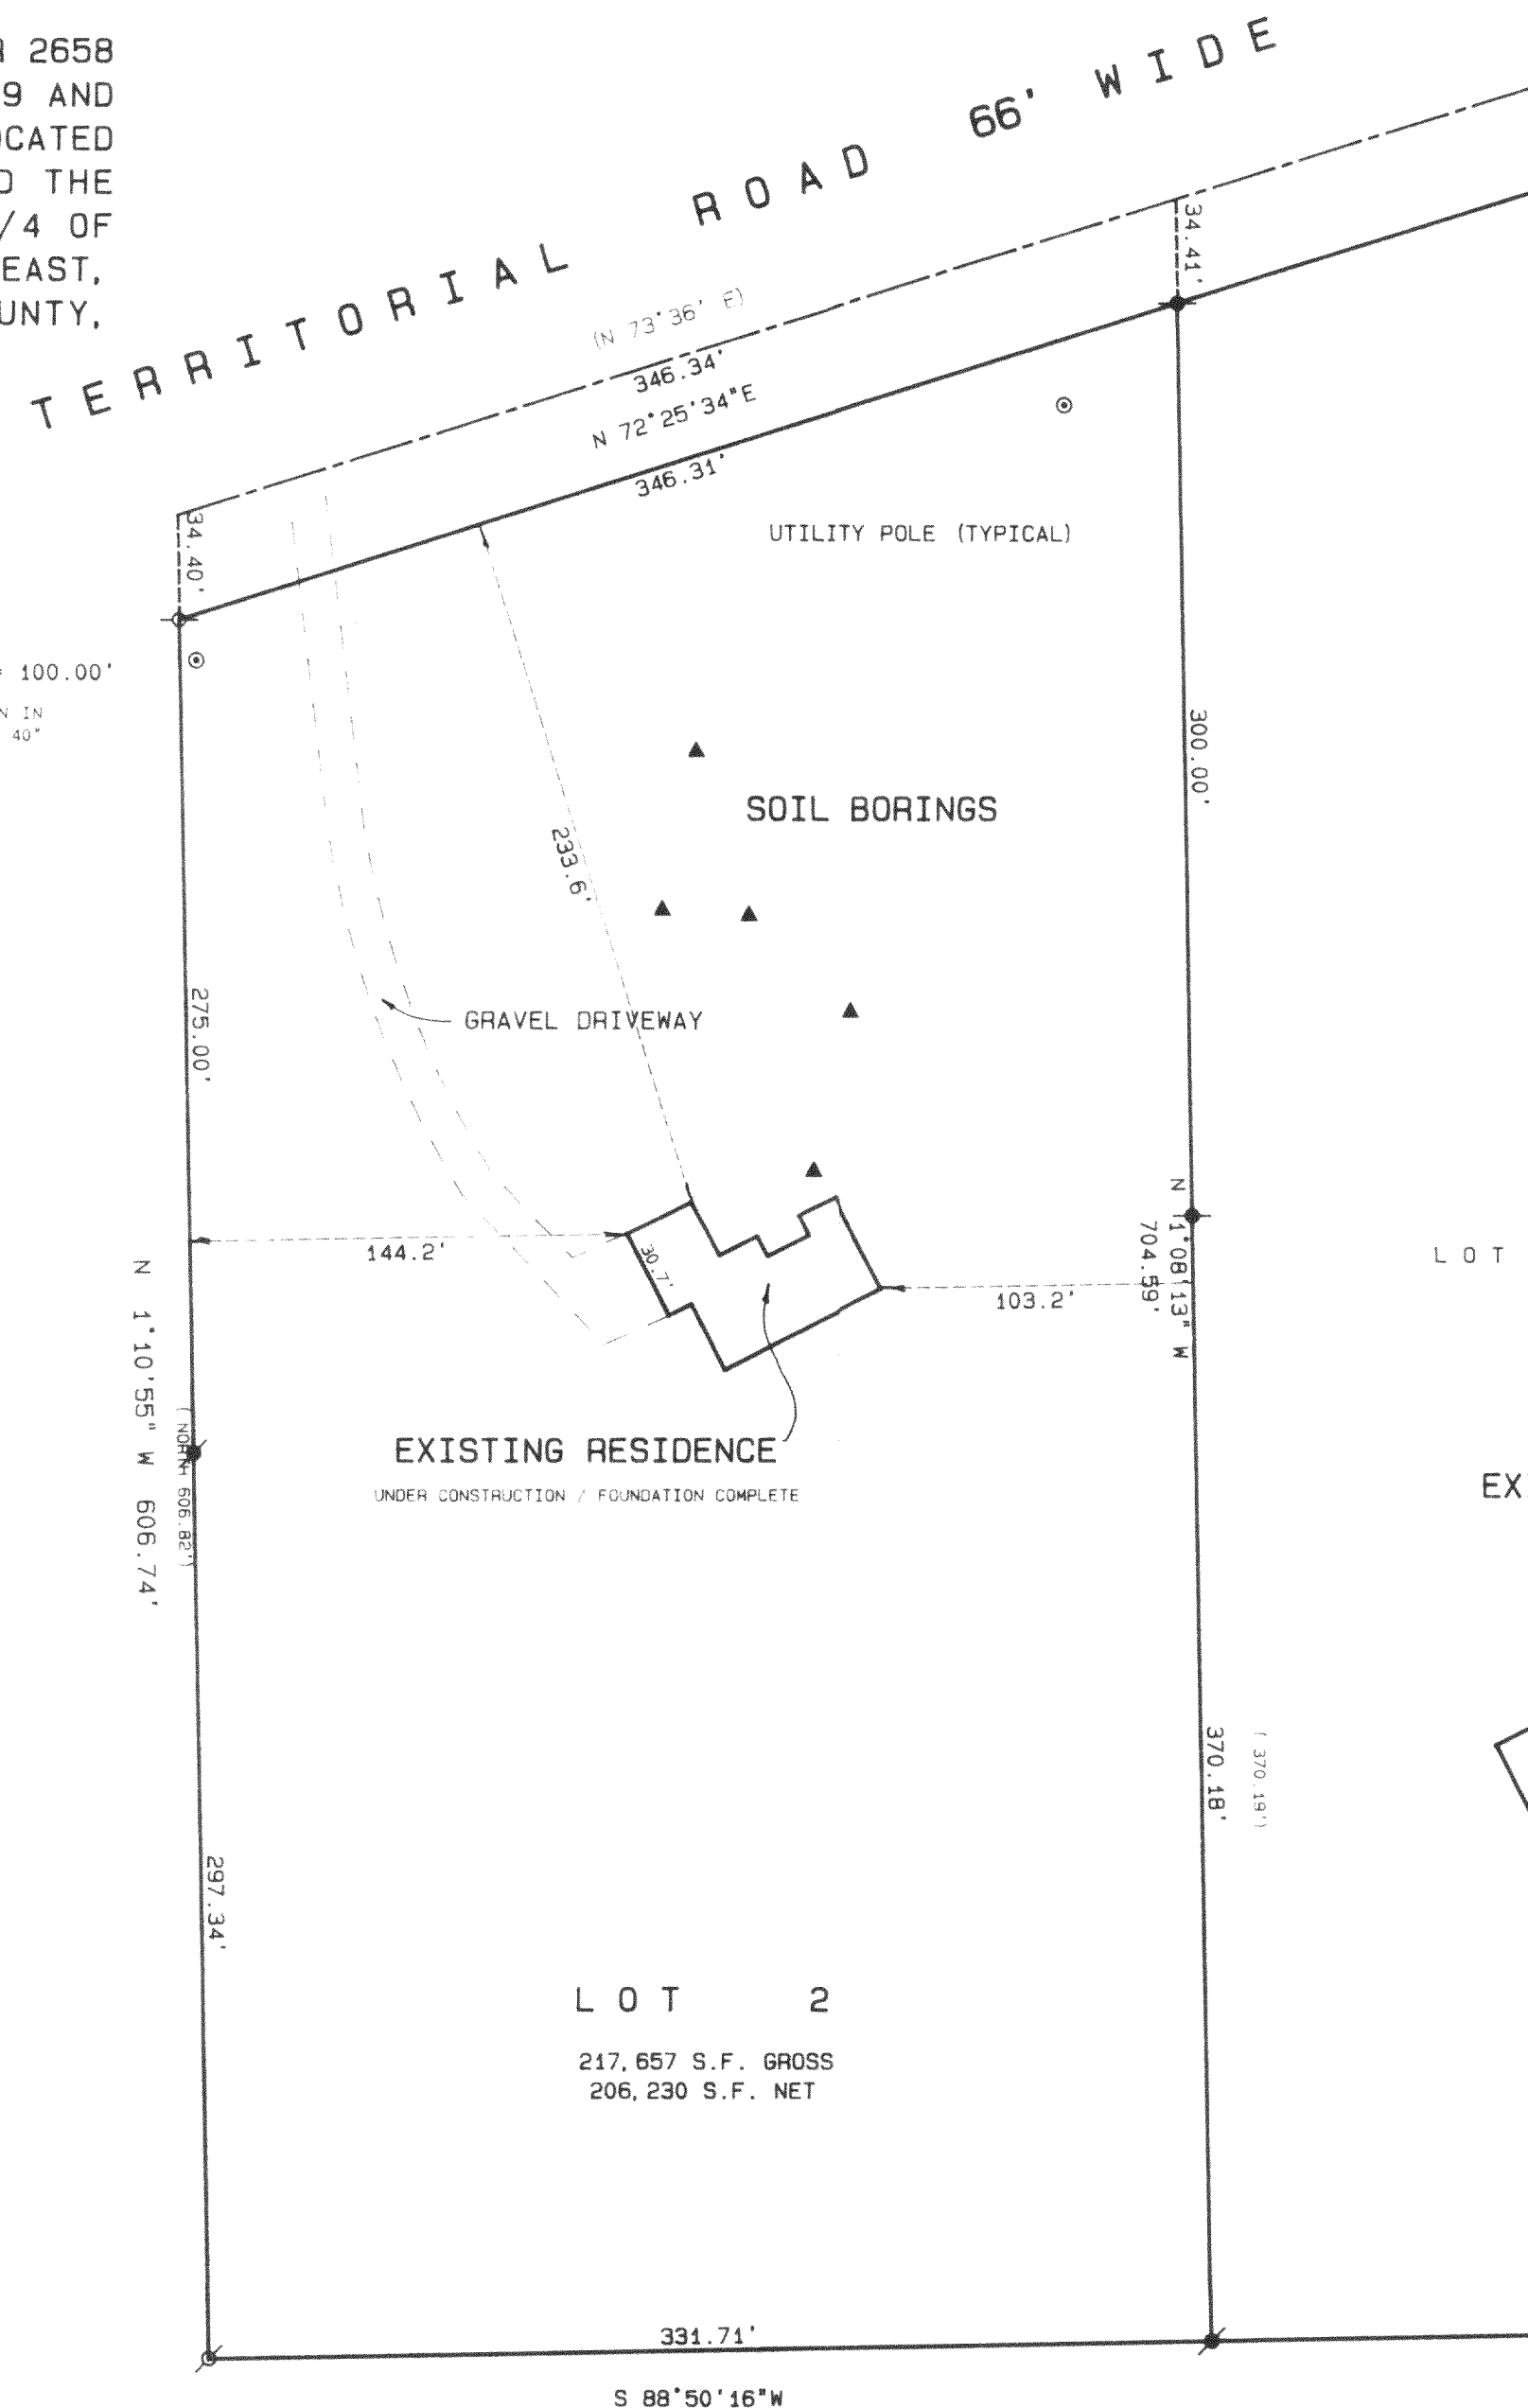


EXISTING RESIDENCE DETAIL

SCALE: 1" = 30'

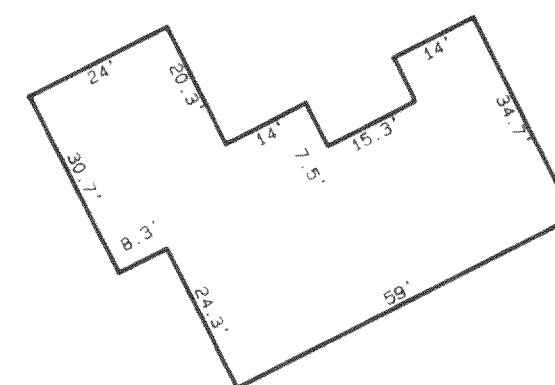


Legend

- FOUND IRON PIPE
- FOUND IRON ROD
- FOUND BRASS CAPPED MONUMENT
- FOUND CONCRETE MONUMENT
- CHISEL CUT IN CONCRETE
- SET IRON ROD, 24" LONG, WEIGHING 1.5 LBS. LINEAL FT., 3/4" DIA.
- SET IRON ROD, 30" LONG, WEIGHING 4.5 LBS. LINEAL FT., 1-11/16" DIA.
- RECORDED AS DIMENSION
- EXISTING FENCE

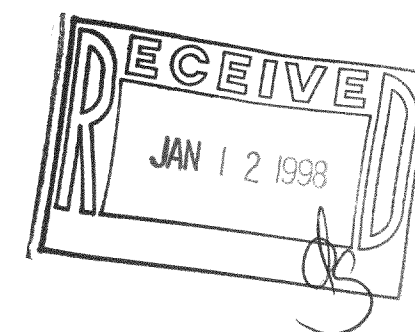

SCALE: 1" = 60 FEET

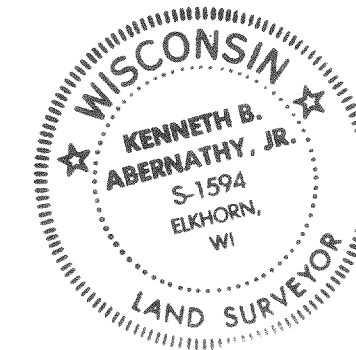

"I hereby certify that the above described property has been surveyed by me or under my direction and that the above map is a true representation thereof and shows the size and location of the property, its exterior boundaries, the location of all visible structures and dimensions of all principal buildings thereon, boundary fences, apparent easements, roadways and visible encroachments, if any."
"This survey is made for the use of the present owners of the property, and also those who purchase, mortgage, or guarantee the title thereto within one year from date hereof."

Kenneth B. Abernathy, Jr.
KENNETH B. ABERNATHY, JR.
WISCONSIN REGISTERED LAND SURVEYOR,
S-1594

Date: 7-31-97 Job No. 95 R1589

REVISED 10/28/97 TO SHOW RESIDENCE "AS BUILT"

GA-2658-2
316-967