
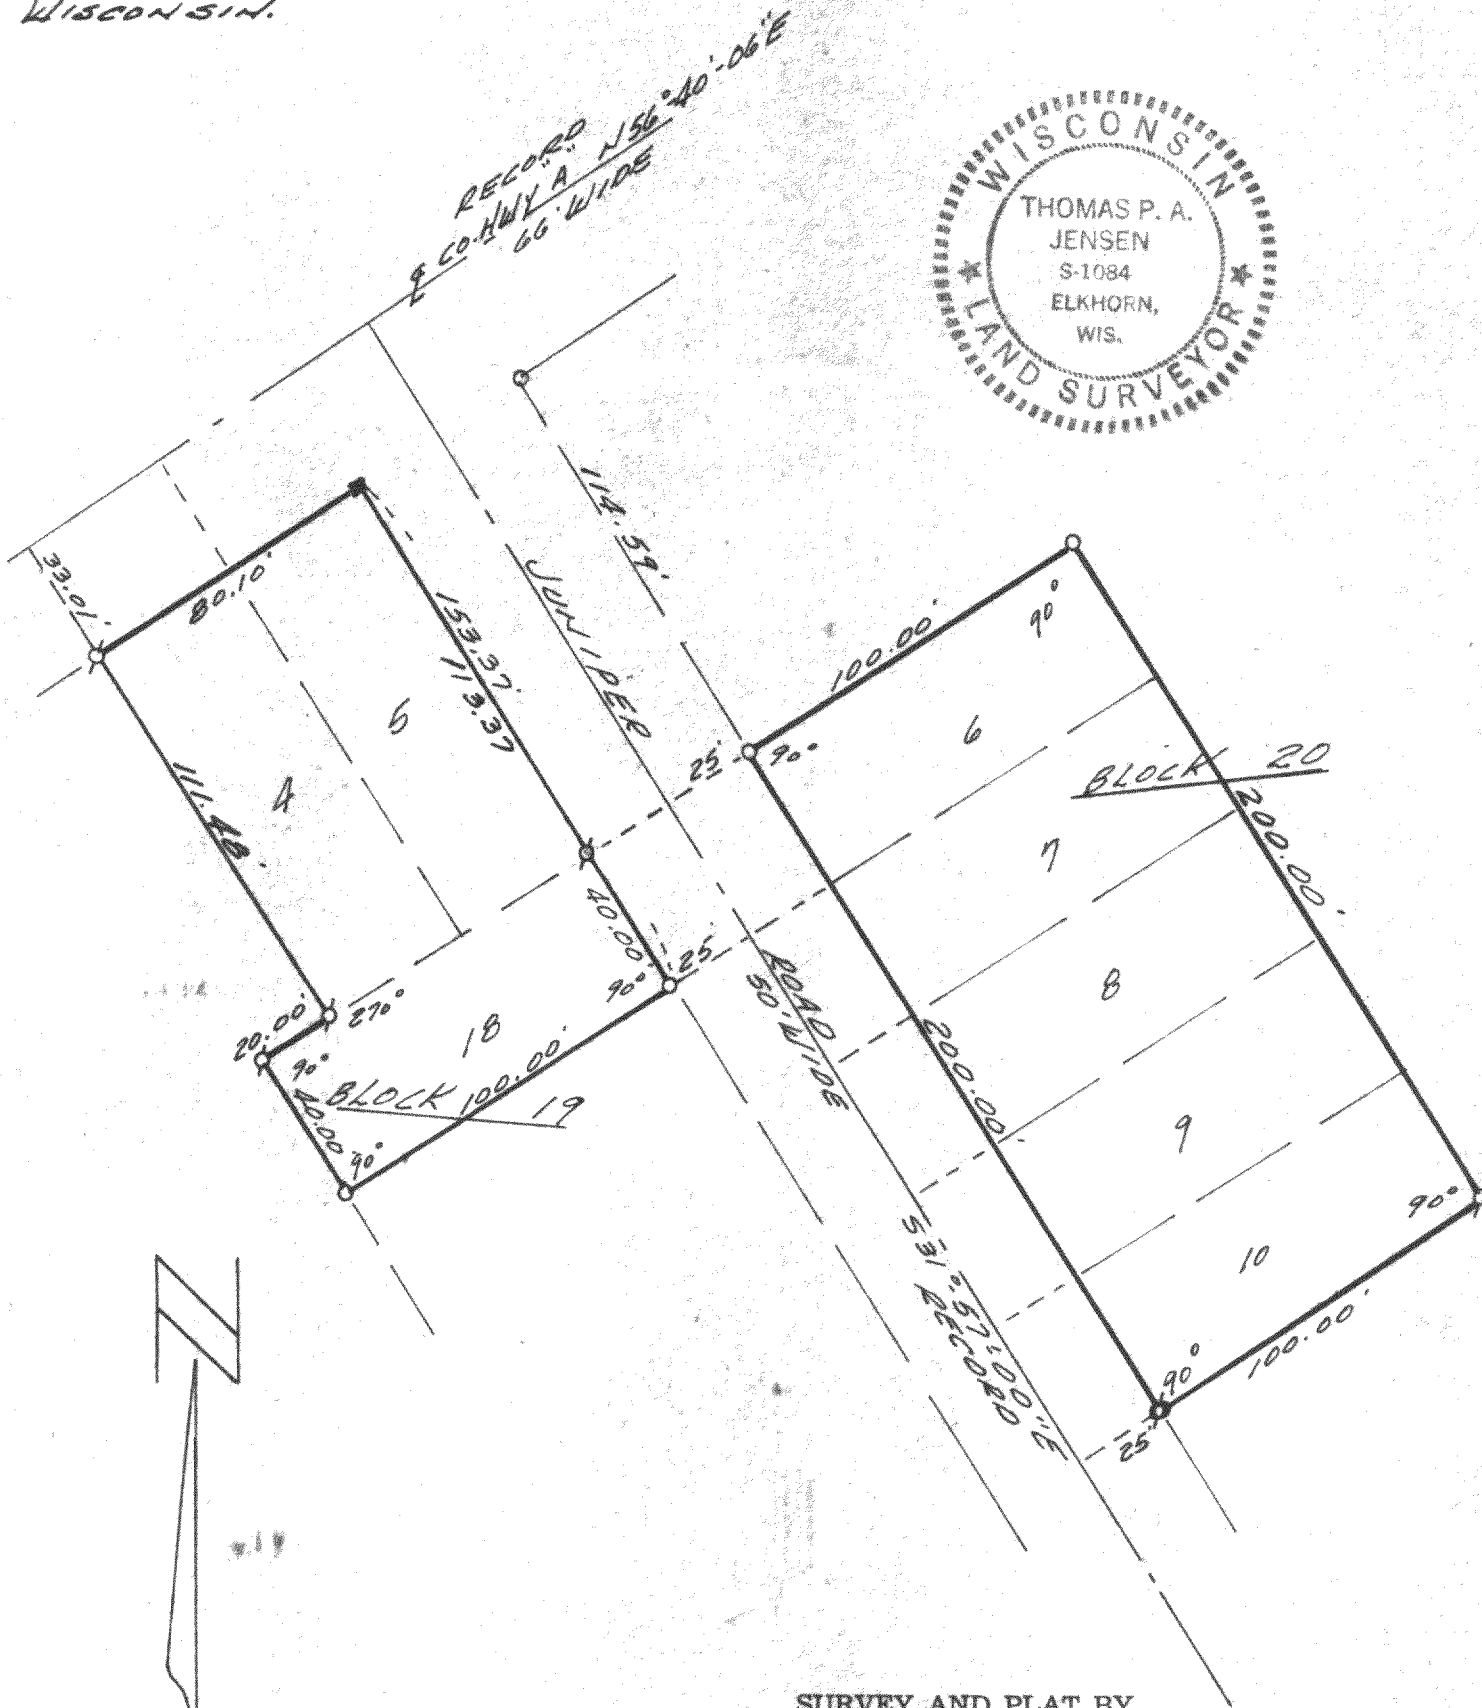


PLAT OF SURVEY

OF
LOTS 4, 5, & 18 BLOCK 19 AND LOTS 6, 7, 8, 9, & 10 BLOCK 20
OF THE 2ND MAP OF INTERLAKEN SUBDIVISION, LOCATED
IN THE S.E. $\frac{1}{4}$ OF SECTION 11, T3N R16E, WALWORTH COUNTY,
WISCONSIN.

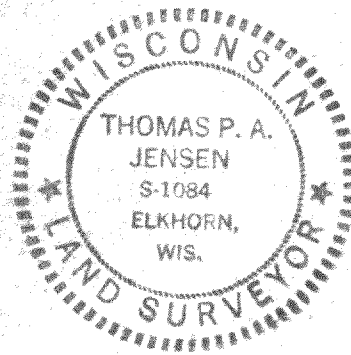

SURVEY AND PLAT BY

JENSEN & JOHNSON, INC.
CIVIL ENGINEERS AND SURVEYORS

Elkhorn, Wisconsin

LEGEND

- — Iron Pipe SET
- — Concrete Monument FOUND
- Scale 1" = 50'
- Ø — IRON PIPE FOUND

WE CERTIFY: That we have surveyed the above described property and that the plat shown hereon is an accurate survey and a true representation thereof and correctly shows the exterior boundary lines and all divisions of said property.

Date SEPT. 19, 1973

Thomas P. A. Jensen

Wisconsin Registered Land Surveyor, No. S-1084

GI-251A-253A
" 254A