


PLAT OF SURVEY

LOT 8 OF GRANVILLE ESTATES

LOCATED IN THE SW 1/4 & SE 1/4 OF THE NE 1/4 OF SECTION 34, TOWN 3 NORTH, RANGE 16 EAST, WALWORTH COUNTY, WISCONSIN

SOUTH LINE OF THE NE 1/4 OF SECTION 34-3-16 BEARS S 88°29'31" W

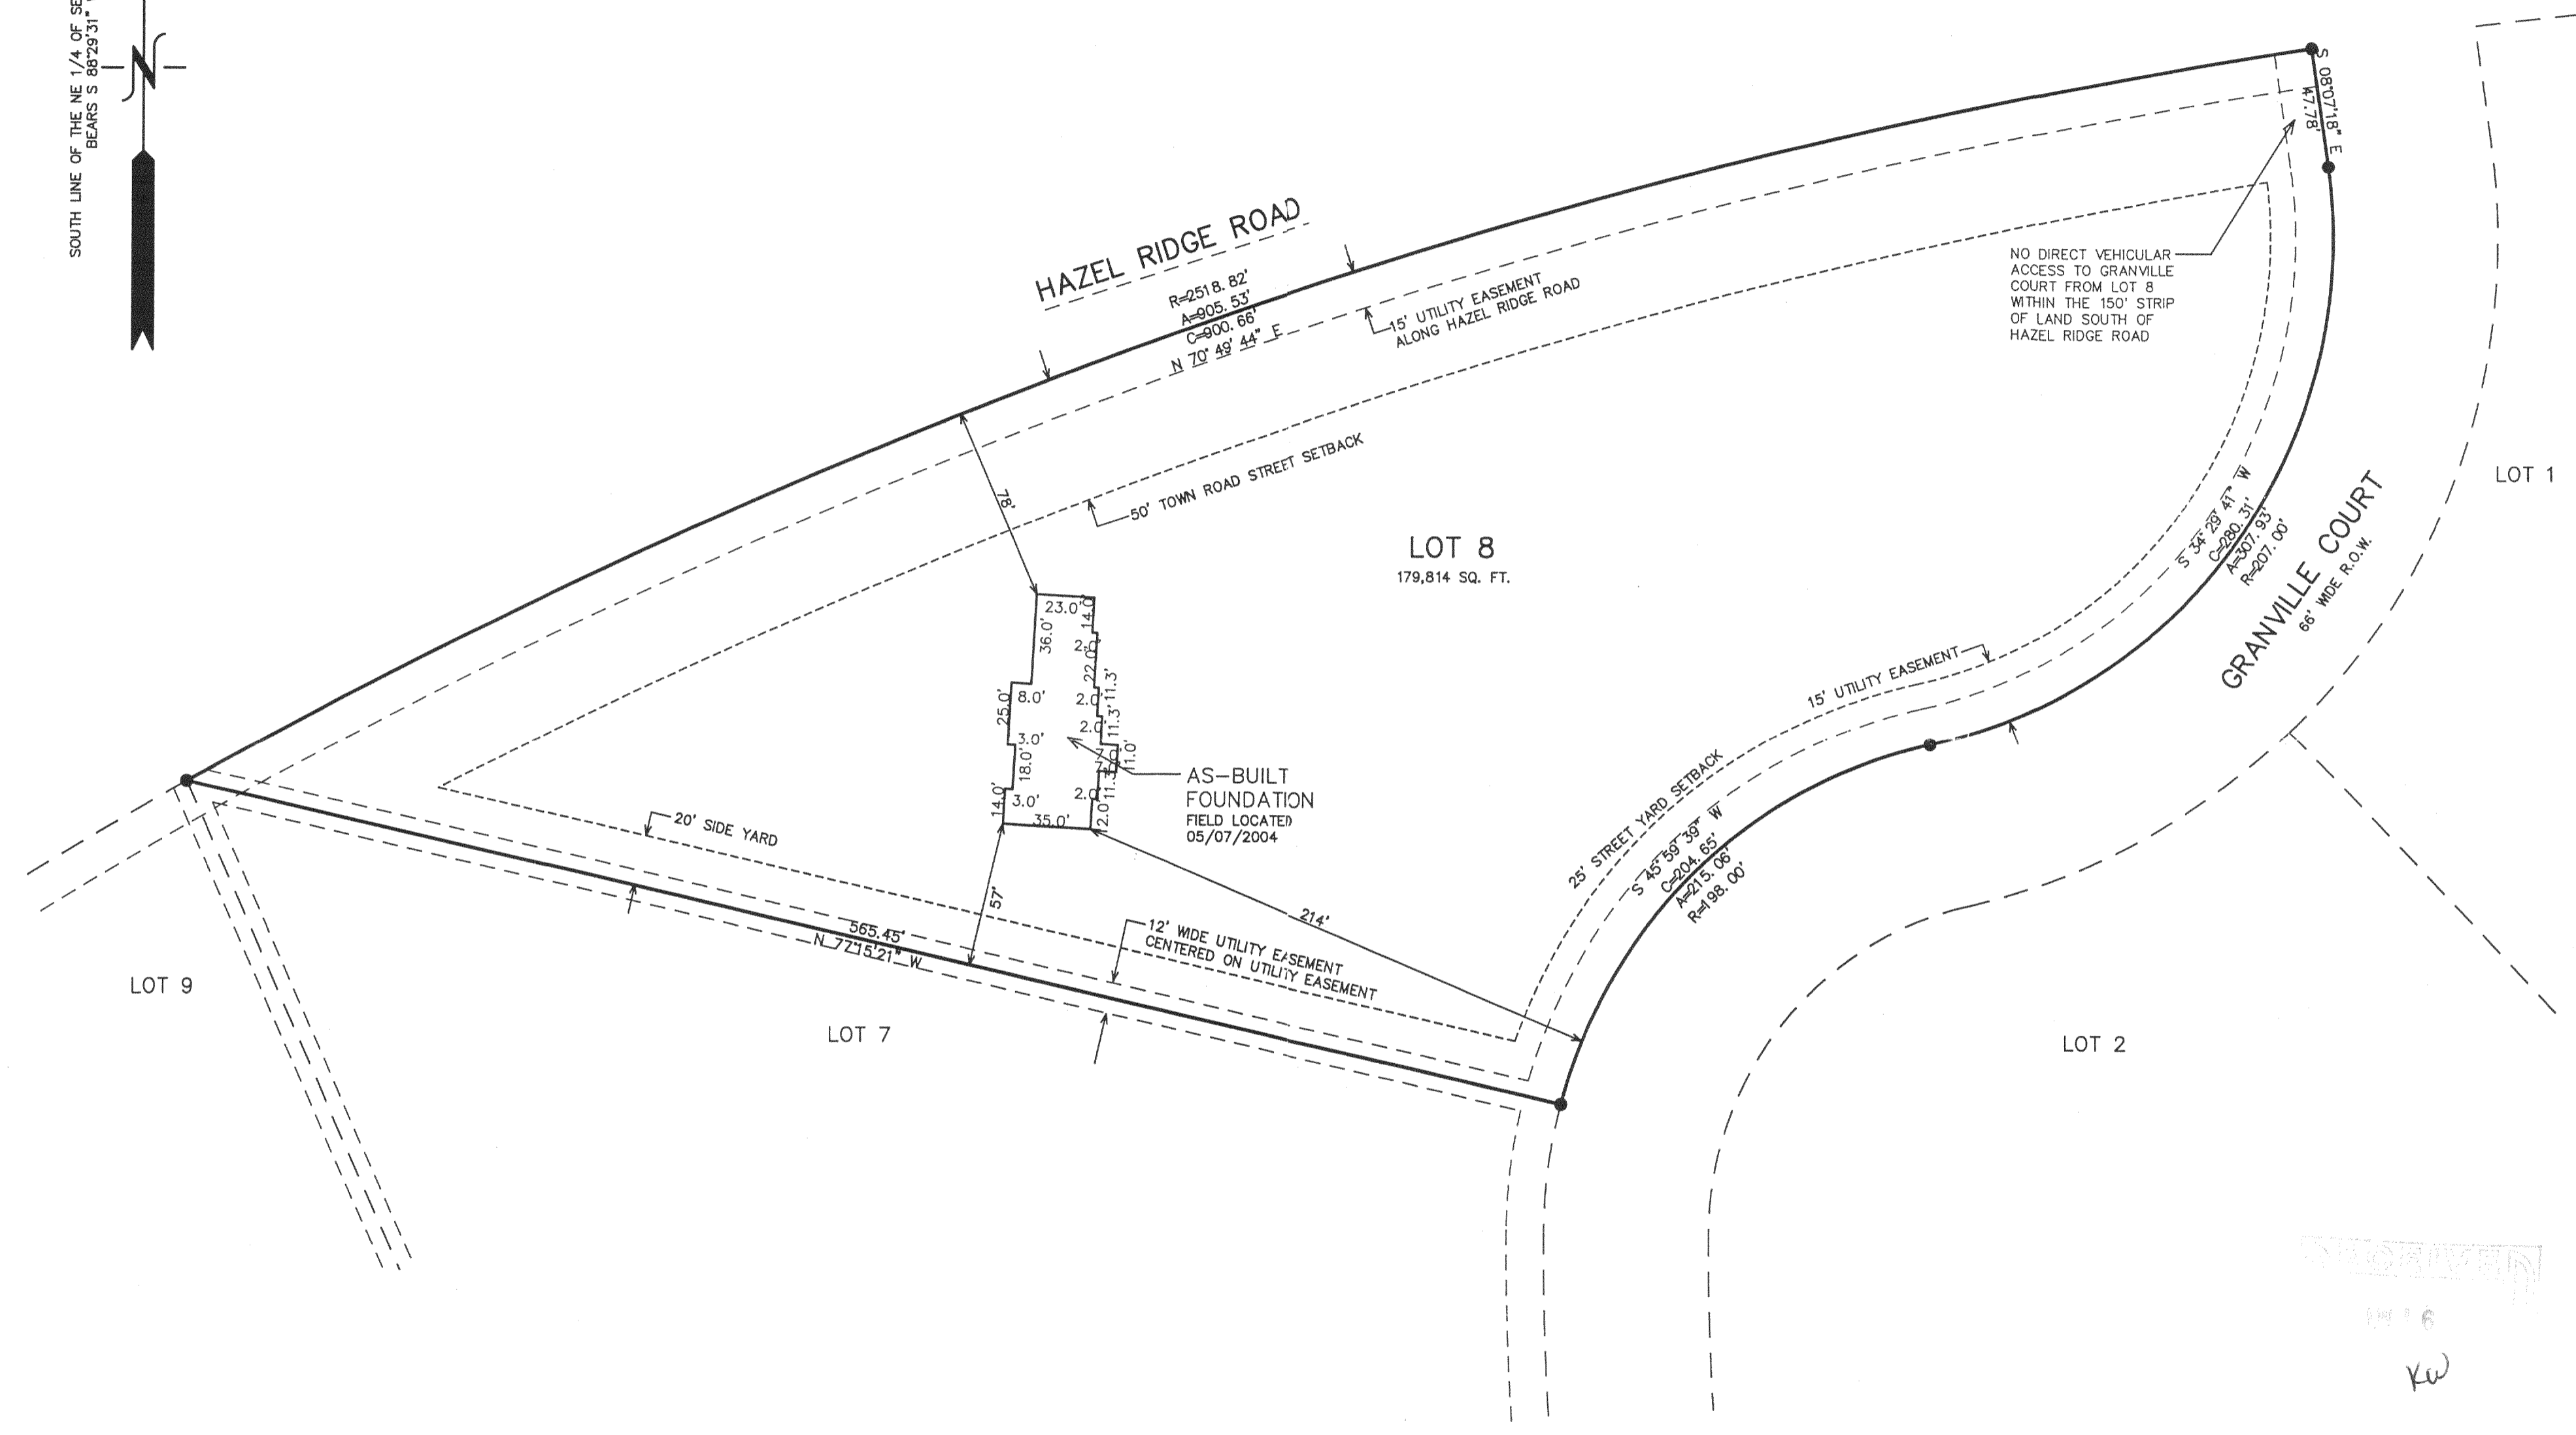

WORK ORDERED BY - ALLAN KLAMM 209 NORTH LINCOLN ELKHORN, WI 53121

FARRIS, HANSEN & ASSOCIATES, INC. ENGINEERING - ARCHITECTURE - SURVEYING 7 RIDGWAY COURT P.O. BOX 437 ELKHORN, WISCONSIN 53121 OFFICE: (262) 723-2098 FAX: (262) 723-5886

REVISIONS 05/10/2004 TO SHOW SIZE AND LOCATION OF AS-BUILT FOUNDATION


PROJECT NO. 4872.08 DATE: 02-09-04 SHEET NO. 1 OF 1

LEGEND ● = FOUND IRON REBAR STAKE (XXX) = RECORDED AS

NOTE: COPIES OF THIS MAP TO WHICH THE FOLLOWING CERTIFICATE WILL APPLY SHOW THE SURVEYOR'S ORIGINAL SEAL AND SIGNATURE IN RED INK. COPIES BY ANY OTHER MEANS MAY HAVE ALTERATIONS WHICH DO NOT REPRESENT THE SURVEYOR'S WORK PRODUCT.

I HEREBY CERTIFY THAT THE ABOVE DESCRIBED PROPERTY HAS BEEN SURVEYED UNDER MY DIRECTION AND THAT THE ABOVE MAP IS A TRUE REPRESENTATION THEREOF AND SHOWS THE SIZE AND LOCATION OF THE PROPERTY AND ITS EXTERIOR BOUNDARIES. THIS SURVEY IS MADE FOR THE USE OF THE PRESENT OWNERS OF THE PROPERTY, AND ALSO THOSE WHO PURCHASE, MORTGAGE, OR GUARANTEE THE TITLE THERETO WITHIN ONE YEAR FROM THE DATE HEREOF.

DATED: FEBRUARY 9, 2004 REVISED 02-23-2004
Peter S. Gordon
PETER S. GORDON R.L.S. 2101

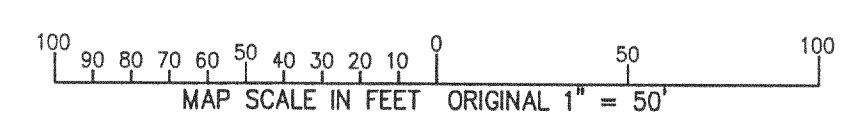

5/10/2004 X:\Projects\4872\DCAD\LOT8

GG R 00008

316-1645