

**LAND-MARK SURVEYING**  
Mark L. Miritz

Wisconsin Registered Land Surveyor S-2582

N9330 Knuteson Drive  
Whitewater, WI 53190  
Phone: (262)495-3284  
FAX : (262) 495-8421  
LAND-MARKSURVEYING.COM


**PLAT OF SURVEY**

LOTS 21, 22 & PART OF LOT 20 OF BLOCK 4 OF INTERLAKEN SUBDIVISION, LOCATED IN SECTION 11, TOWN 3 NORTH, RANGE 16 EAST, TOWN OF SUGAR CREEK, WALWORTH COUNTY, WISCONSIN.

**TAX KEY GI-31**


Lots 20, 21 & 22 of Block 4 of Interlaken Subdivision, located in Section 11, Town 3 North, Range 16 East, Sugar Creek Township, Walworth County, Wisconsin, excepting the following described parcel: Commence at a Found Concrete Monument at the Northeastly right-of-way corner of Lot 21, in said Block; Thence N 68°46'00" W along the Southerly right-of-way of County Trunk Highway "A" 104.34 feet to the POINT OF BEGINNING; THENCE S 00°04'33" W 77.93 feet to a Set Iron Pipe; THENCE N 89°46'49" W 2.50 feet to the Southeast Corner of Lot 19; THENCE N 00°04'33" E 114.28 feet along the East line of said Lot 19 to the centerline of said Highway; THENCE S 68°46'00" E 2.68 feet along said centerline; THENCE S 00°04'33" W 35.39 feet to a SET IRON PIPE and the POINT OF BEGINNING.

RECEIVED  
MAY 12 2005

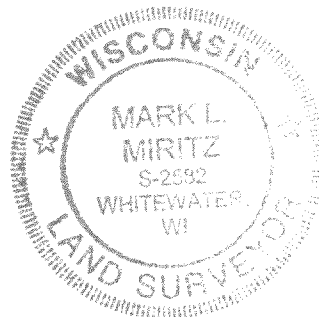


REVISED 4/22/05 TO SHOW FOUNDATION "AS BUILT"

50' WIDE CEDAR ROAD

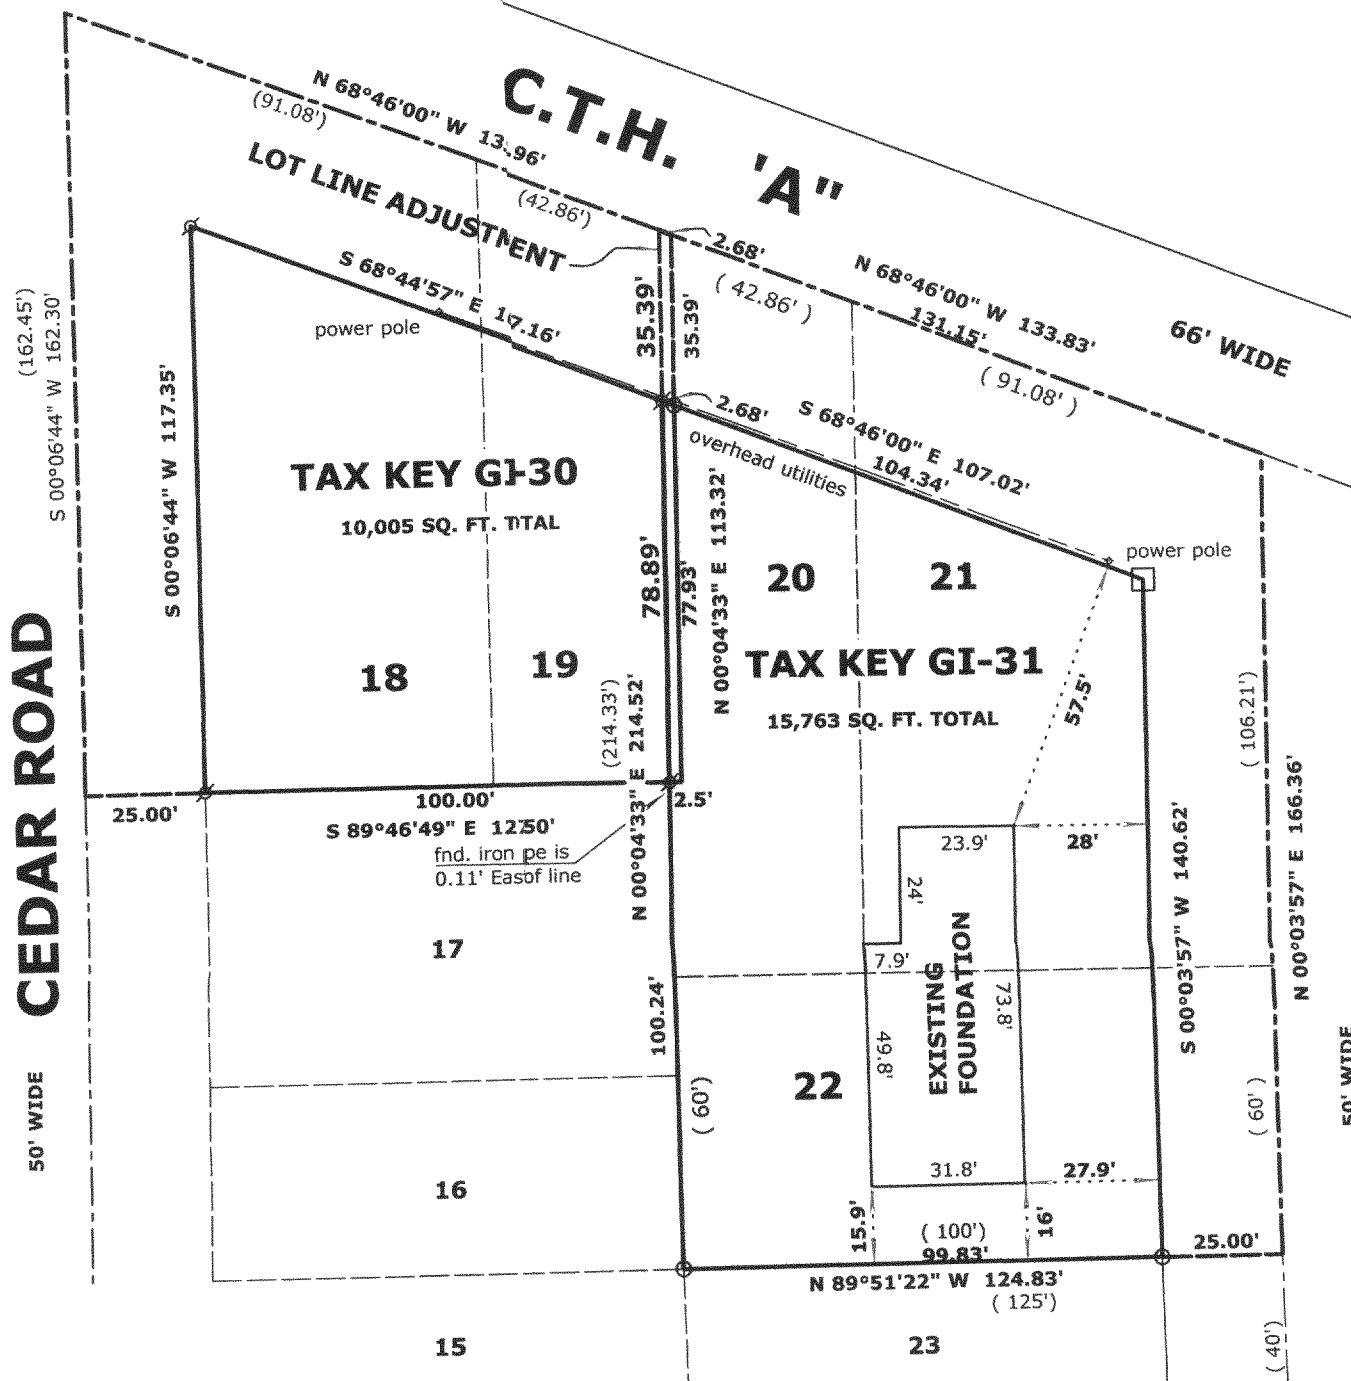

**NOTES:**

ALL PARCEL AREAS ARE EXCLUSIVE OF RIGHT-OF-WAYS.

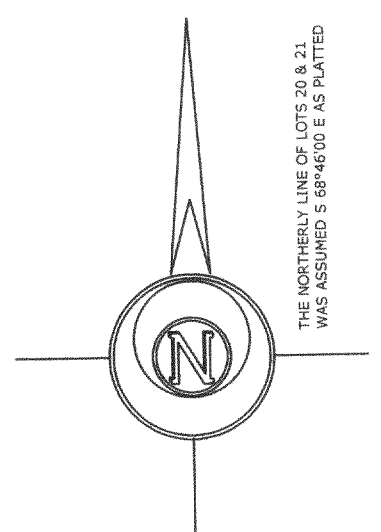

THE NORTHERLY LINE OF LOTS 20 & 21 WAS ASSUMED S 68°46'00" E AS PLATTED

ORDERED BY: CLAUDIA LARSEN  
W4945 CTH ES - 105  
ELKHORN, WI. 53121

**LEGEND**

- FOUND IRON PIPE
- FOUND IRON ROD
- SET WOOD STAKE AT 10' OFFSET OF BUILDING CORNER
- FOUND CONCRETE MONUMENT
- CHISEL CUT IN CONCRETE
- SET IRON PIPE, 24" LONG, WEIGHING 1.33 LBS./LINEAL FT., 1 1/4" DIA.
- ( x x ) RECORDED AS DIMENSION
- X-X EXISTING FENCE

SCALE: 1" = 40 FEET

"I hereby certify that the above described property has been surveyed by me or under my direction and that the above map is a true representation thereof and shows the size and location of the property, its exterior boundaries, the location of all visible structures and dimensions of all principal buildings thereon, boundary fences, apparent easements, roadways and visible encroachments, if any."  
"This survey is made for the use of the present owners of the property, and also those who purchase, mortgage, or guarantee the title thereto within one year from date hereof."

*Mark L. Miritz*  
MARK L. MIRITZ  
WISCONSIN REGISTERED  
LAND SURVEYOR S-2582

DATE: NOV. 27, 2004 JOB NO. 04.1002

316-1733

GI 00031