


PLAT OF SURVEY OF PART OF BLOCK 33, INTERLAKEN
 SUBDIVISION MAPS 3 AND 4, LOCATED IN SECTION 11,
 T3N, R16E, TOWN OF SUGAR CREEK, WALWORTH
 COUNTY, WISCONSIN

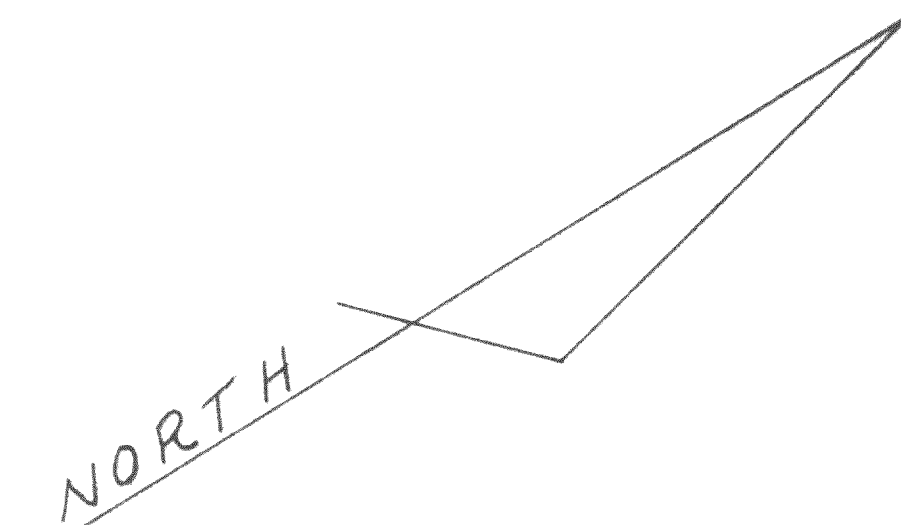

SCALE 1" = 30'

LEGEND

- FOUND IRON PIPE
- SET IRON ROD (1/2" x 24")
- SET IRON PIPE (1" x 24")
- WOOD STAKES

I hereby certify that I have surveyed the above described land and that the plat hereon drawn is a correct representation of said survey.

Thomas P. A. Jensen
 Thomas P. A. Jensen
 Jensen Surveying and Mapping
 Elkhorn, WI. 53121

July 1978

Surveyed for: *Simonson Realty*

61-286 286A, 286B, 287, 281, 292

