


KOLB LAND CONSULTING, INC.

LAND SURVEYING • SUBDIVIDING • LAND PLANNING

LAKE GENEVA, WISCONSIN 53147

WHITEWATER, WISCONSIN 53190

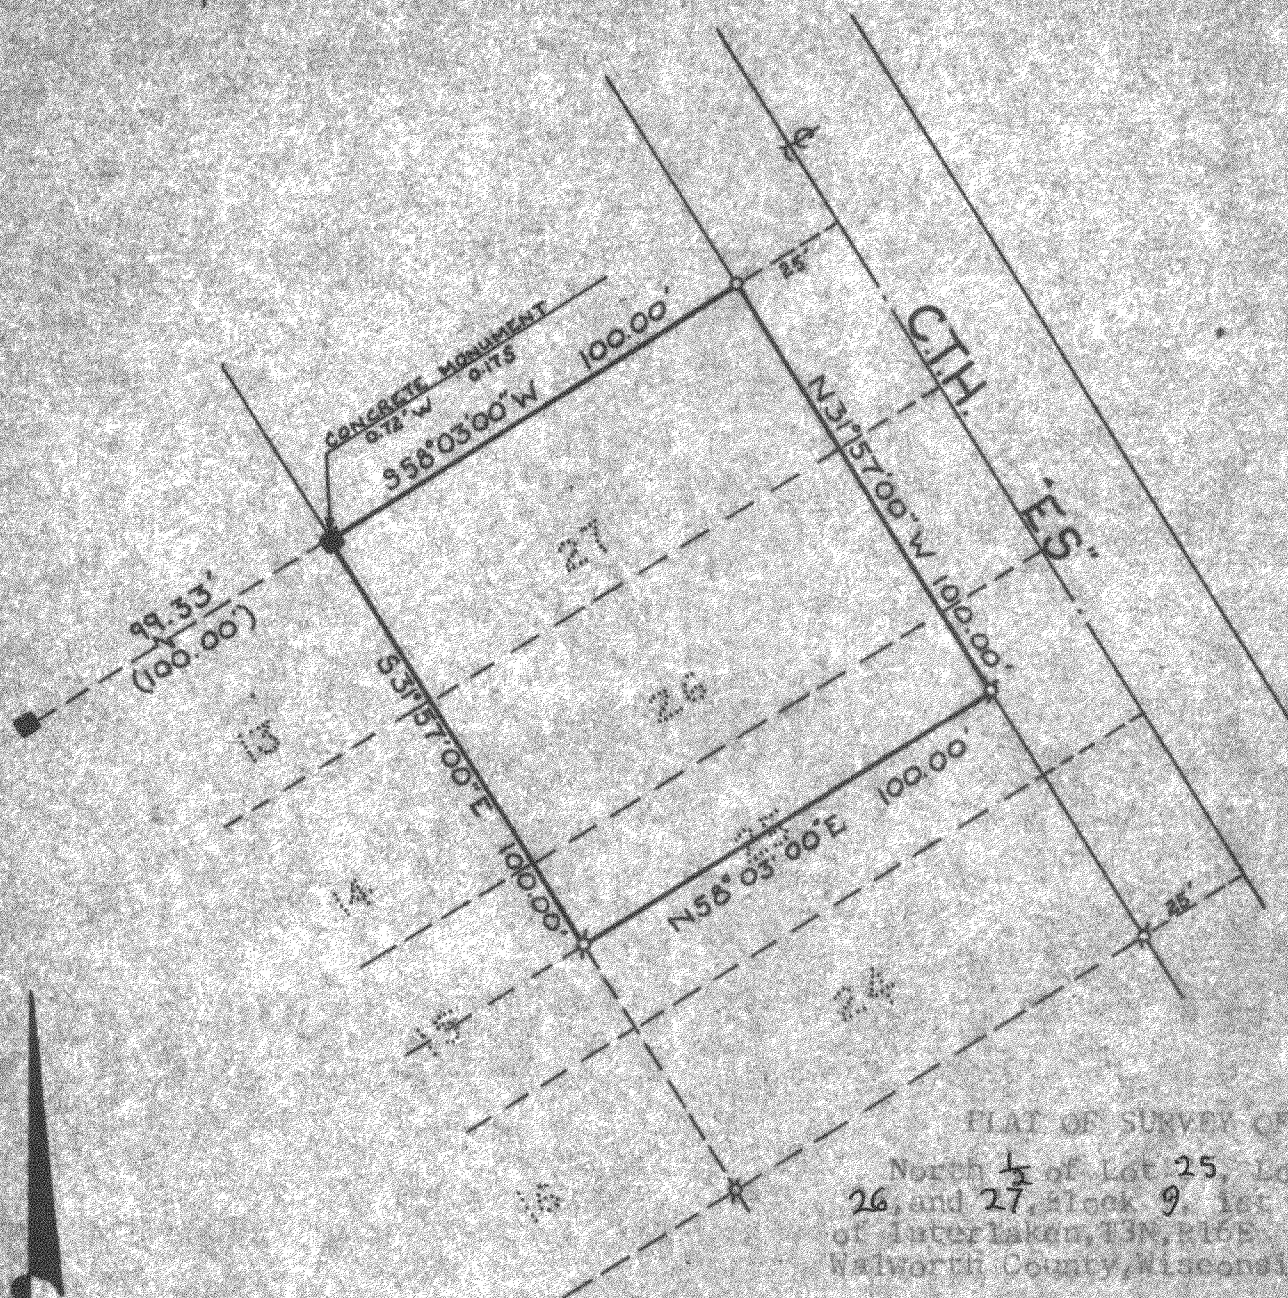

PLAT OF SURVEY OF
North $\frac{1}{2}$ of Lot 25, Lots
26, and 27, Block 9, 1st Map
of Interlaken, T3N, R16E
Walworth County, Wisconsin

Owner: George Mosby
Box 724

Williams Bay, Wisconsin

Note: Bearings are as plotted

I, Eugene A. Blomquist do hereby certify
that I have surveyed the property herein
described according to the official records
and that the plat herein is a correct
representation of the lot lines.

SCALE: 1"=40'

LEGEND

- - FOUND IRON PIPE
- - PLACED IRON PIPE
- - CONCRETE MONUMENT
- () - PLATTED AS

EUGENE A. BLUMQUIST
WISCONSIN REGISTERED LAND SURVEYOR, S-1279
DATE June 11, 1979