

**ABERNATHY and ASSOCIATES**

**Kenneth B. Abernathy Jr.**


**Wisconsin Registered Land Surveyor S-1594**

Rt. 3, Box 273  
Elkhorn, Wisconsin 53121  
Phone: (414) 723-4260 (office)  
(414) 723-4813 (residence)

**PLAT OF SURVEY**

Lot 24 of Block 5 of LAKE WANDAWEGA HIGHLANDS First Addition  
Subdivision, located in Sections 11 and 12, Town 3 North,  
Range 16 East, Walworth County, Wisconsin.

ordered by: ERA Lanham Realty      owner: John M. Davies Trust  
20 S. Washington      Elkhorn, WI. 53121      previous deed vol.265 P.273

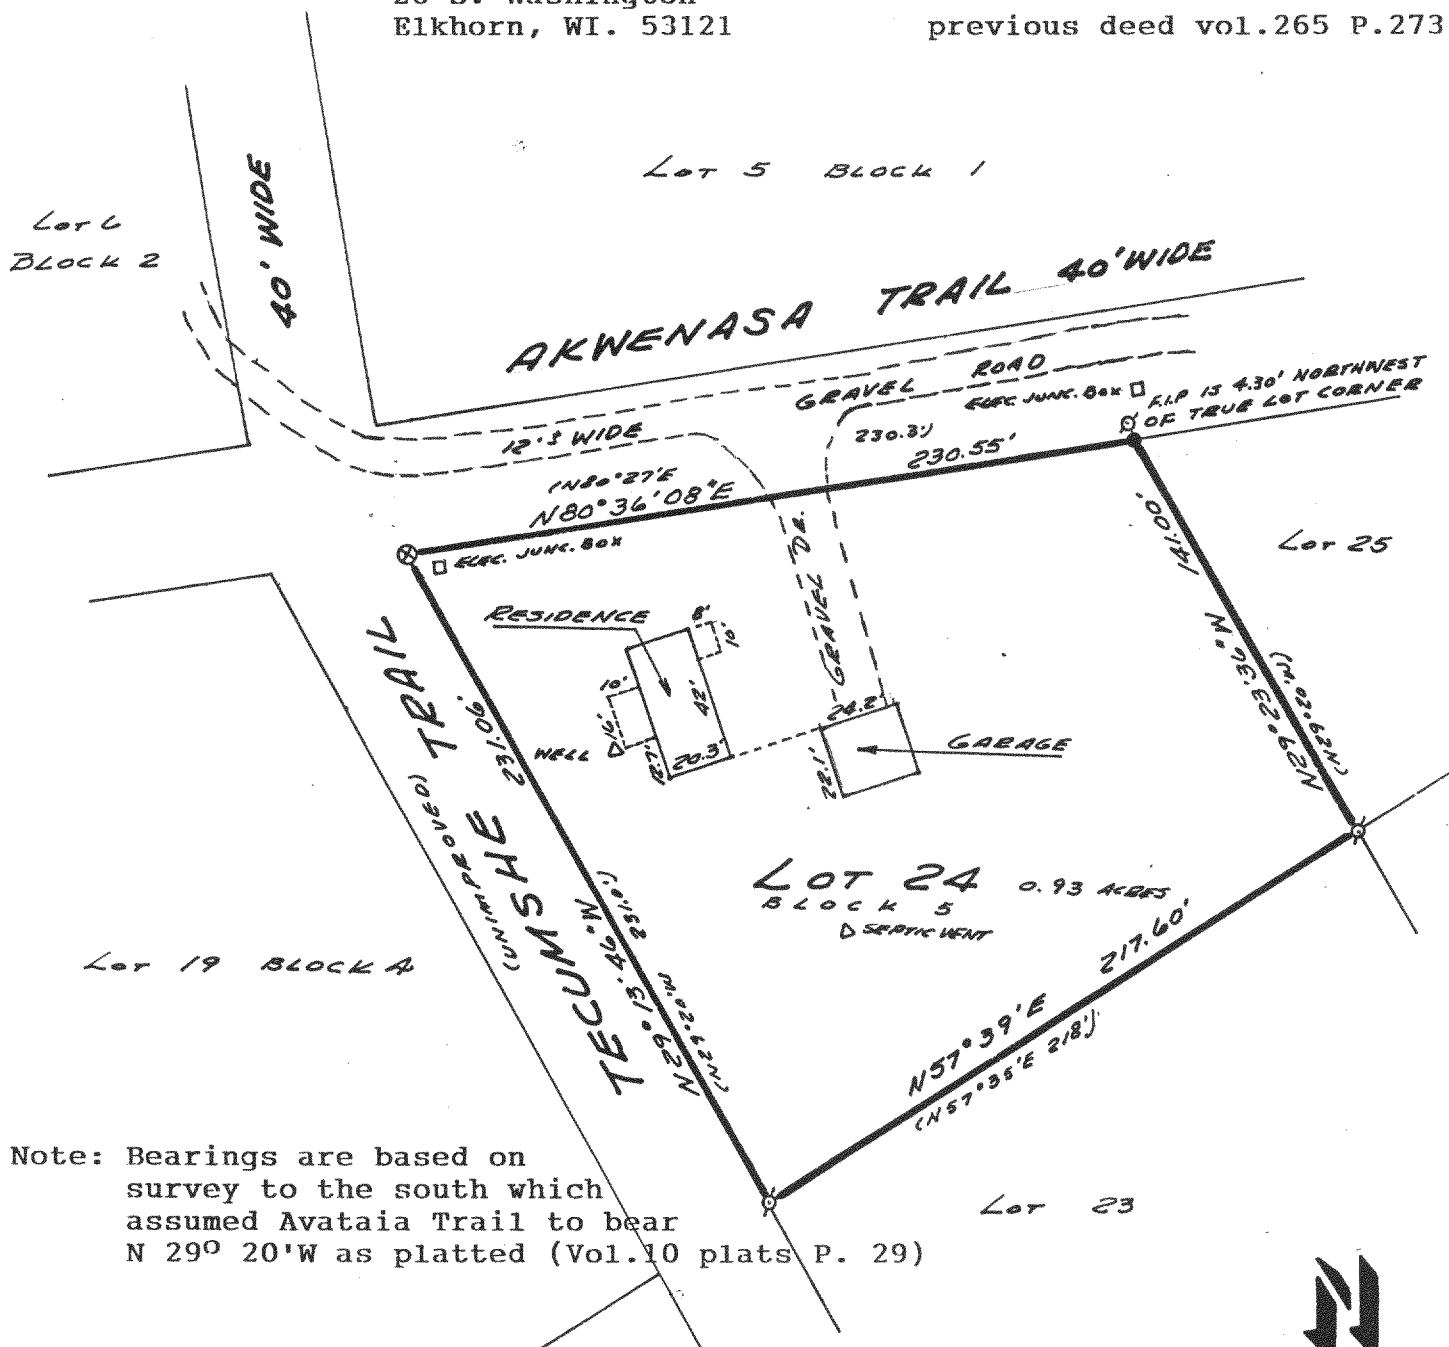


Note: Bearings are based on survey to the south which assumed Avataia Trail to bear N 29° 20' W as platted (Vol.10 plats P. 29)

**Legend**

- FOUND IRON PIPE
- FOUND IRON ROD
- FOUND BRASS CAPPED MONUMENT
- ⊗ FOUND CONCRETE MONUMENT
- + CHISEL CUT IN CONCRETE
- SET IRON ROD, 24" LONG, WEIGHING 1.5 LBS./LINEAL FT., 3/4" DIA.
- SET IRON ROD, 30" LONG, WEIGHING 4.5 LBS./LINEAL FT., 1-11/16" DIA.
- (xx) RECORDED AS DIMENSION
- x-x- EXISTING FENCE


"I hereby certify that I have surveyed the above described property and that the above map is a true representation thereof and shows the size and location of the property, its exterior boundaries, the location of all visible structures and dimensions of all principal buildings thereon, boundary fences, apparent easements, roadways and visible encroachments, if any."

"This survey is made for the use of the present owners of the property, and also those who purchase, mortgage, or guarantee the title thereto within one year from date hereof."

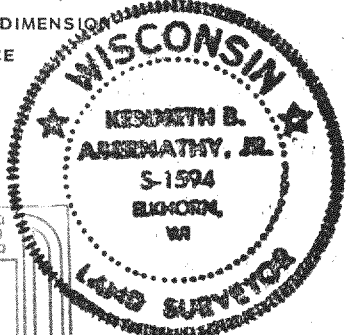

*Kenneth B. Abernathy Jr.*  
KENNETH B. ABERNATHY, JR.  
WISCONSIN REGISTERED LAND SURVEYOR,  
S-1594

Date: June 6, 1988 Job No. 88.603

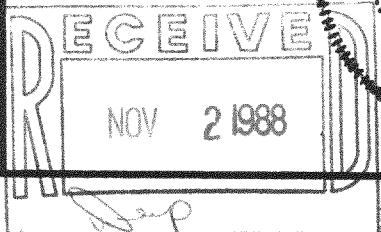

316-422