



60-64

316-94B

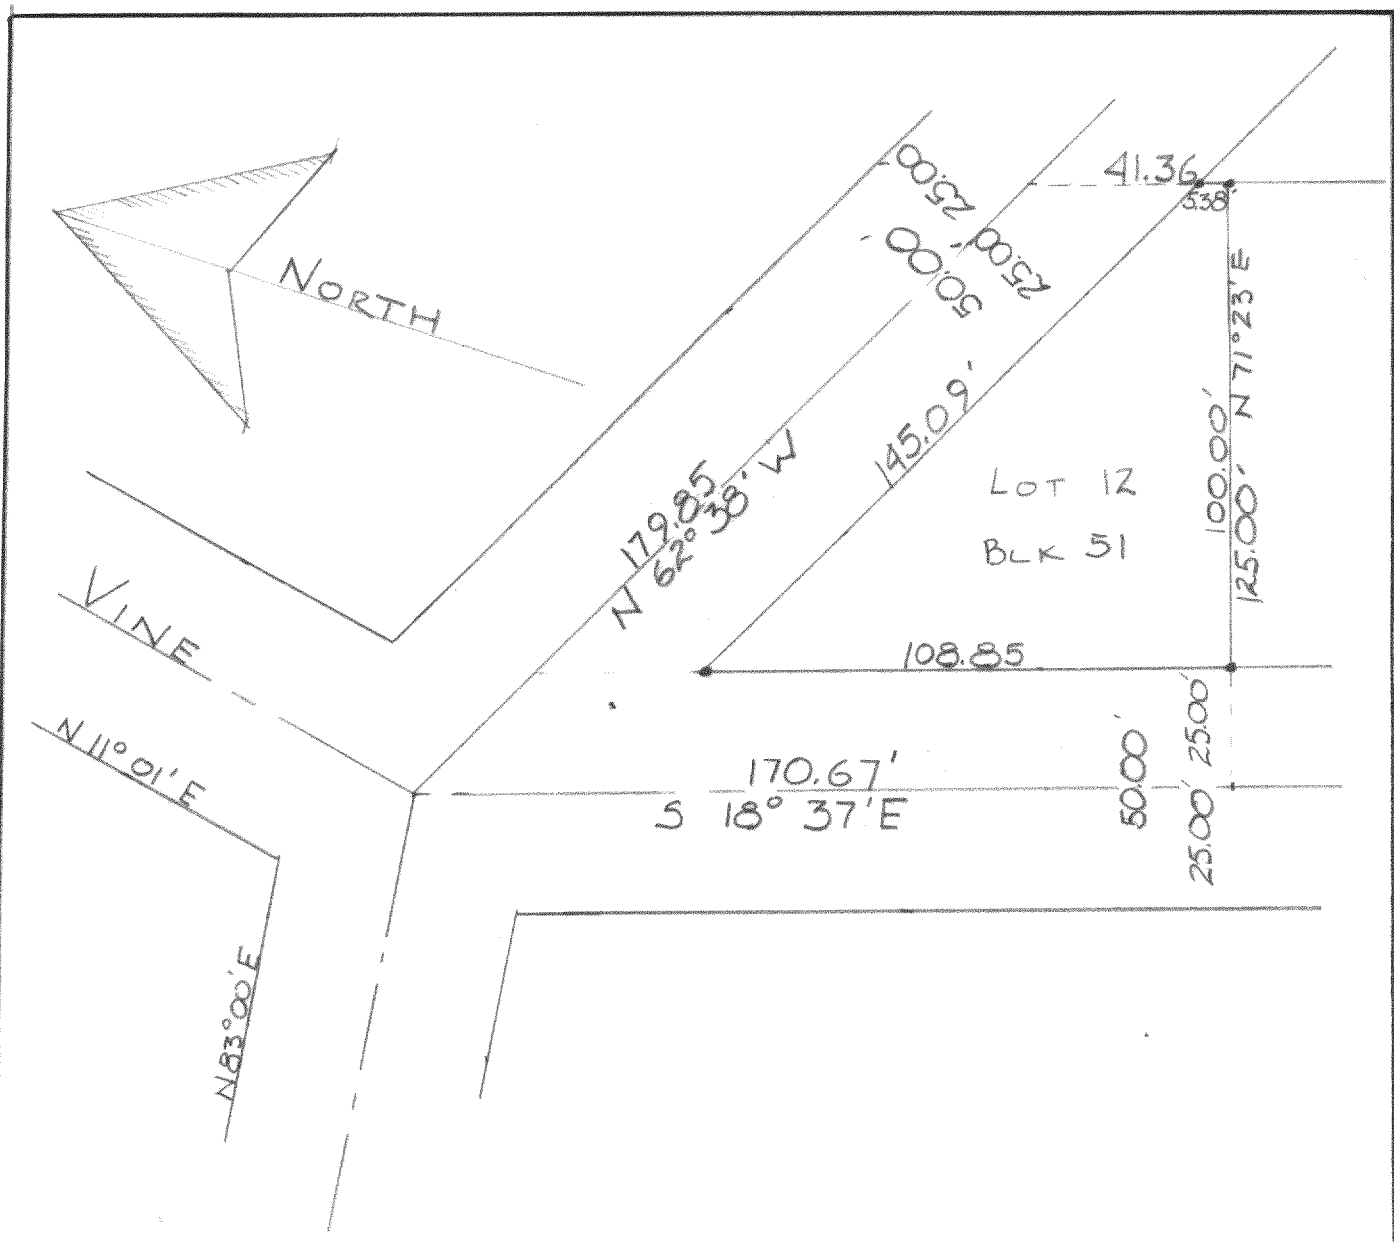

DESCRIPTION: Lot #12 of Block 51 of the 4th Map of Interlaken Subdivision, Town of Sugar Creek, Walworth County, Wisconsin.

Surveyed May the 16th, 1960

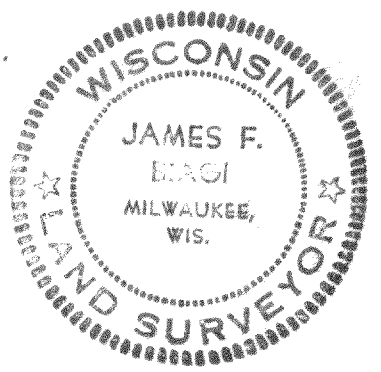

by James F. Biagi  
James F. Biagi Rls 272

316-94B

61-469

316-94B