



ENGINEERING, ARCHITECTURE, SURVEYING
7 RIDGEWAY COURT – P.O. BOX 437, ELKHORN, WISCONSIN, 53121
PHONE: (414) 723-2098 FAX: (414) 723-5886

7 RIDGEWAY COURT - P.O. BOX 437, ELKHORN, WISCONSIN, 53121



PHONE: (414) 723-2098 FAX: (414) 723-5886

LOT 6 & THE N 1/2 OF LOT 7
BLOCK 11 OF INTERLAKEN 1ST MAP

LOCATED IN SECTION 11, TOWN 3 NORTH RANGE 16 EAST
WALWORTH COUNTY, WISCONSIN

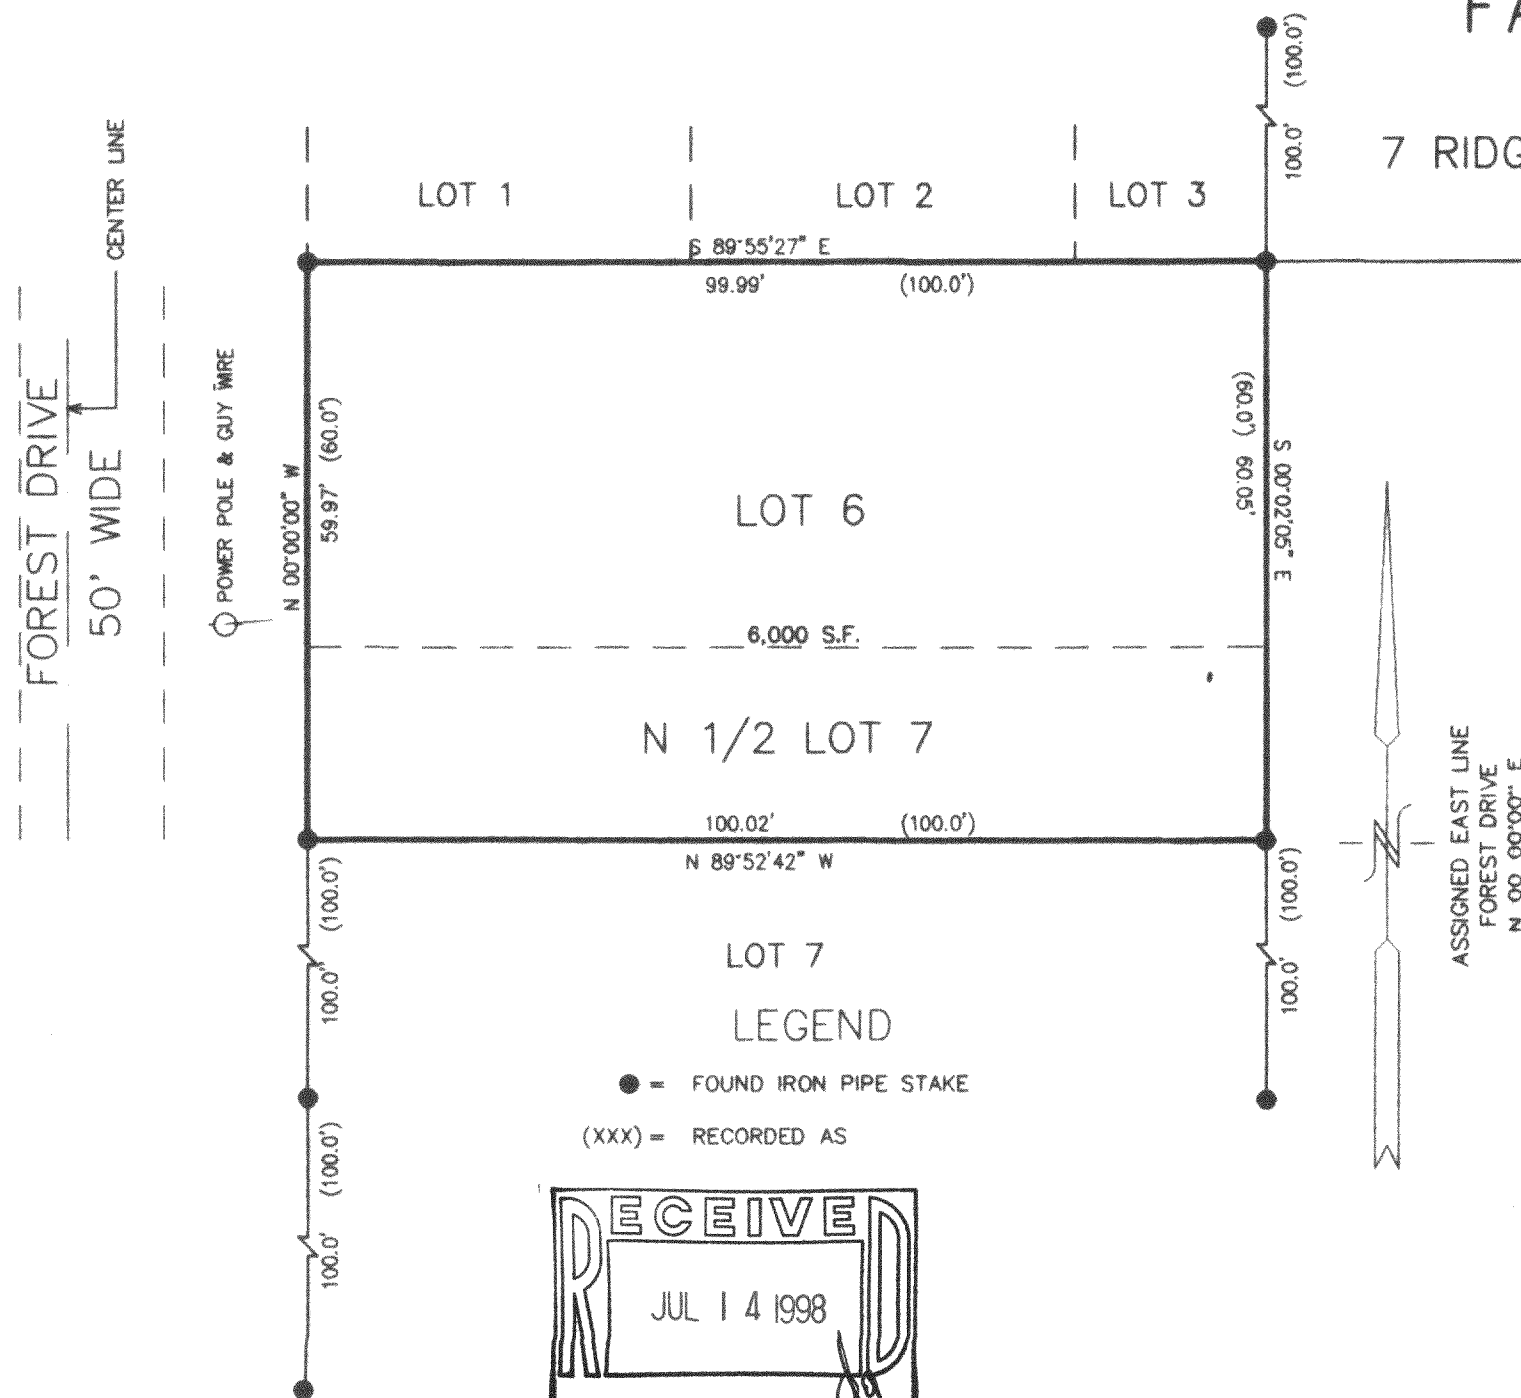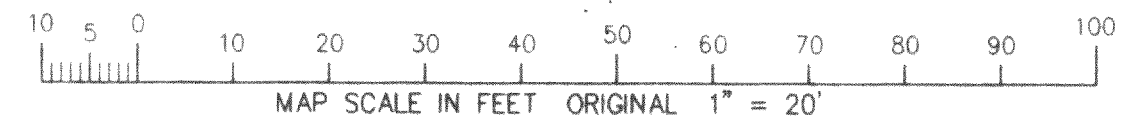

LARRY & SANDY WOLFE
W5490 LAKE SHORE DRIVE
ELKHORN, WI 53121

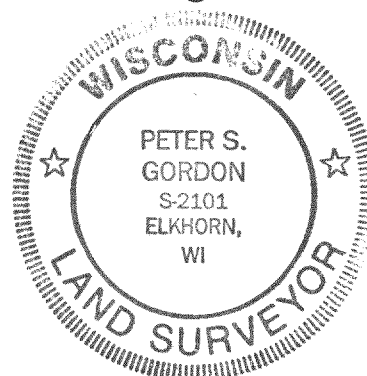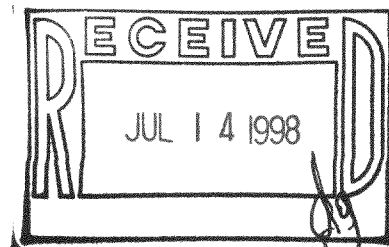

I HEREBY CERTIFY THAT THE ABOVE DESCRIBED PROPERTY HAS BEEN SURVEYED UNDER MY DIRECTION AND THAT THE ABOVE MAP IS A TRUE REPRESENTATION THEREOF AND SHOWS THE SIZE AND LOCATION OF THE PROPERTY AND ITS EXTERIOR BOUNDARIES. THIS SURVEY IS MADE FOR THE USE OF THE PRESENT OWNERS OF THE PROPERTY, AND ALSO THOSE WHO PURCHASE, MORTGAGE, OR GUARANTEE THE TITLE THERETO WITHIN ONE YEAR FROM THE DATE HEREOF.

DATED: 6/23/98


PETER S. GORDON R.L.S. 2101

SHEET 1 OF 1

GI-102

316-1002