


FARRIS, HANSEN & ASSOC. INC.

7 RIDGWAY COURT - P.O. BOX 437
ELKHORN, WISCONSIN 53121
PHONE (414) 723-2098
FAX (414) 723-5886


PLAT OF SURVEY OF S 1/2 LOT 20 AND OF
LOTS 21 & 22 OF BLOCK 5 OF INTERLAKEN, A
SUBDIVISION LOCATED IN SEC 11-3-16
WALWORTH COUNTY, WISCONSIN
TAX KEY # GI 00051

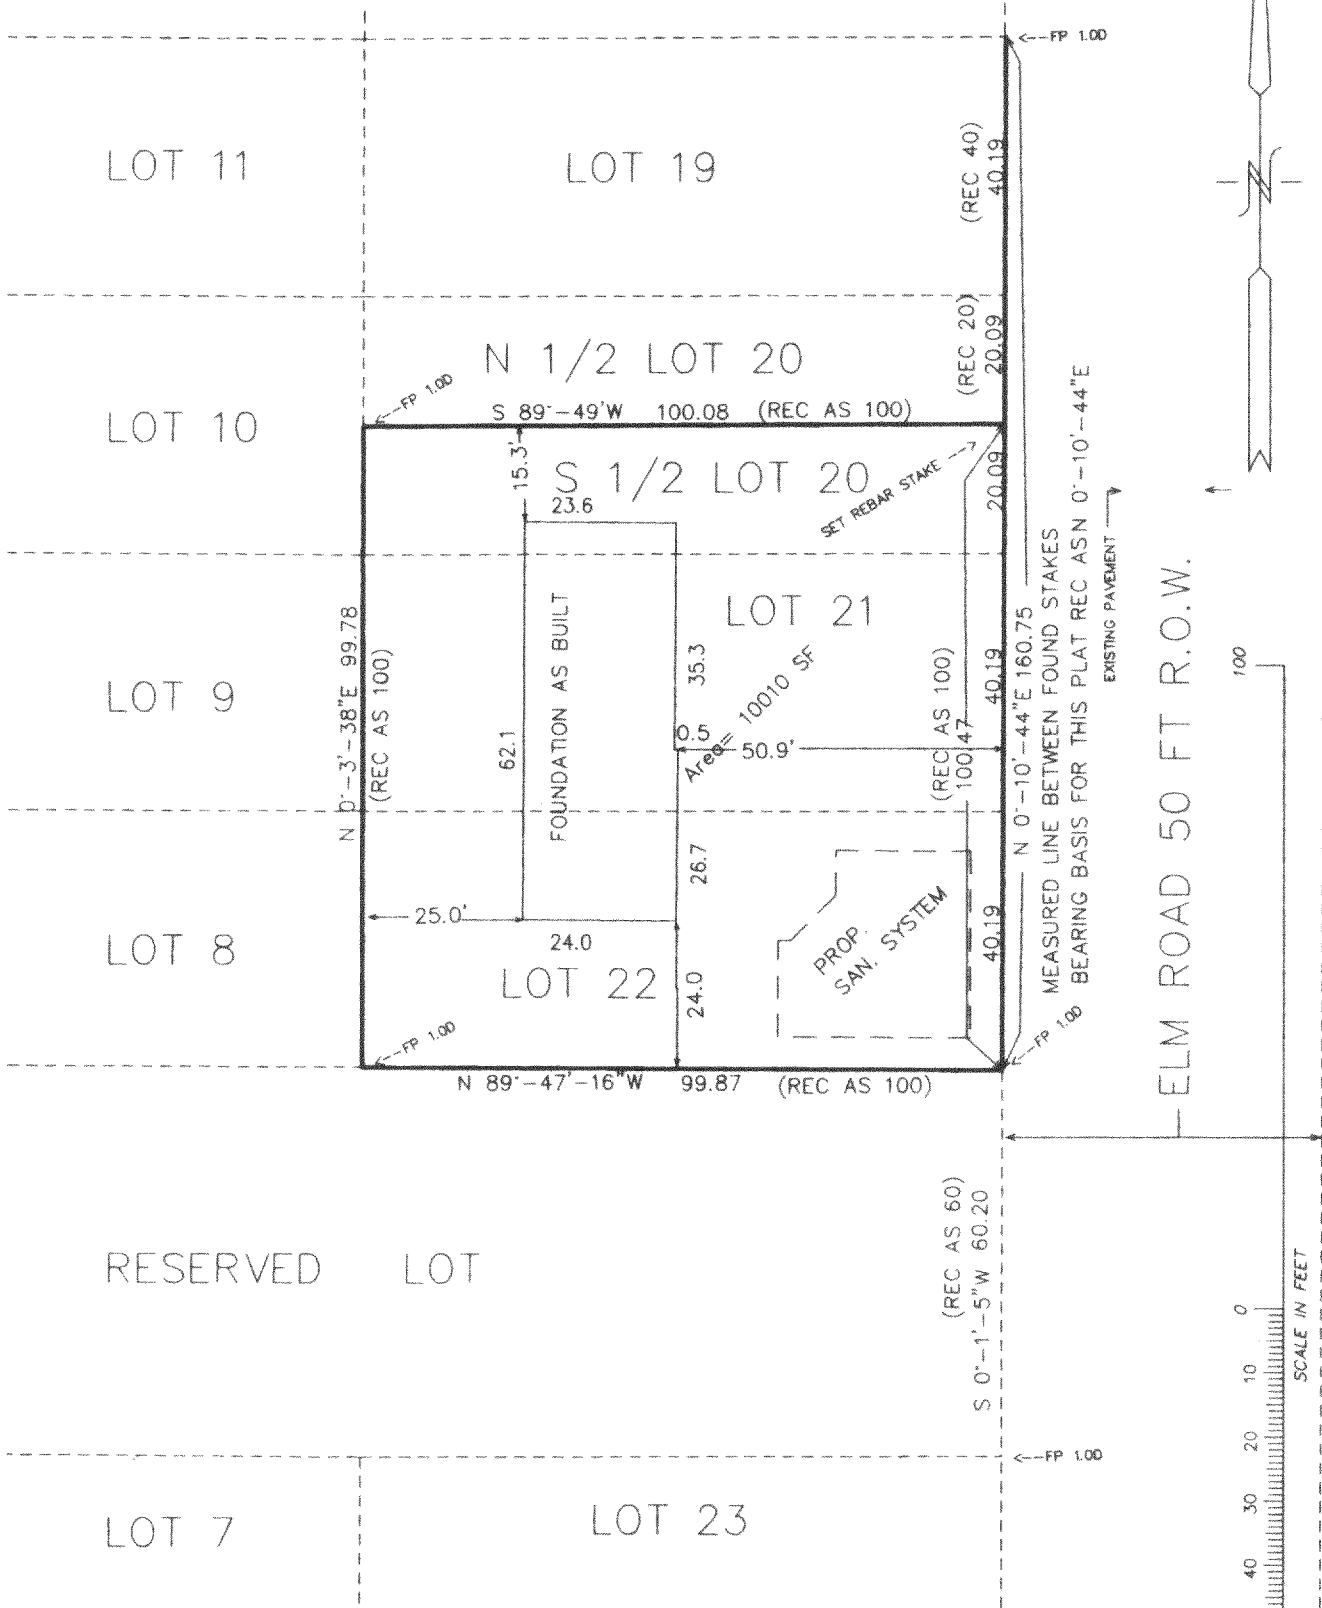

I HEREBY CERTIFY THIS PLAT TO BE A TRUE AND ACCURATE REPRESENTATION OF THE BOUNDARY LINES OF A VACANT PARCEL SURVEYED UNDER MY DIRECTION.


REVISER 7-27-98 TO SHOW AS BUILT FOUNDATION 7/29/97

Peter S. Gordon

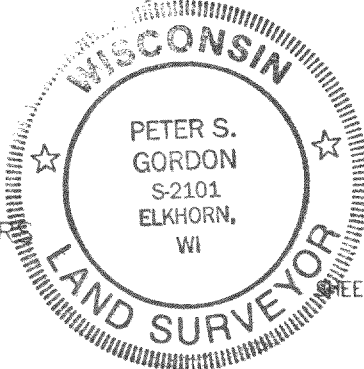

PROJECT 4605.B5 ORDERED BY: JASON ROBER

DATED: 7/21/97

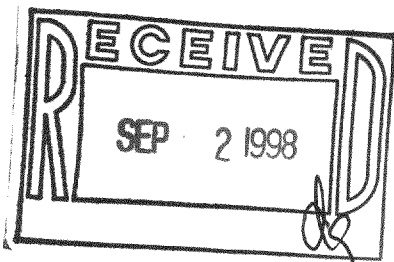

GI-51
316-1011