


FARRIS, HANSEN & ASSOCIATES, INC.  
 ENGINEERING, ARCHITECTURE, SURVEYING  
 7 RIDGWAY COURT - P.O. BOX 437, ELKHORN, WISCONSIN 53121  
 PHONE: (414) 723-2098 FAX: (414) 723-5886

PLAT OF SURVEY  
 LOTS 30, 29, & THE NORTH 1/2 OF LOT 28  
 BLOCK 11 OF INTERLAKEN SUBDIVISION 1st MAP  
 LOCATED IN THE SE 1/4 OF SEC. 11  
 T 3 N, R 16 E, WALWORTH COUNTY, WISCONSIN

WORK ORDERED BY: LARRY WOLF  
 W5490 LAKE SHORE DRIVE  
 ELKHORN, WI. 53121

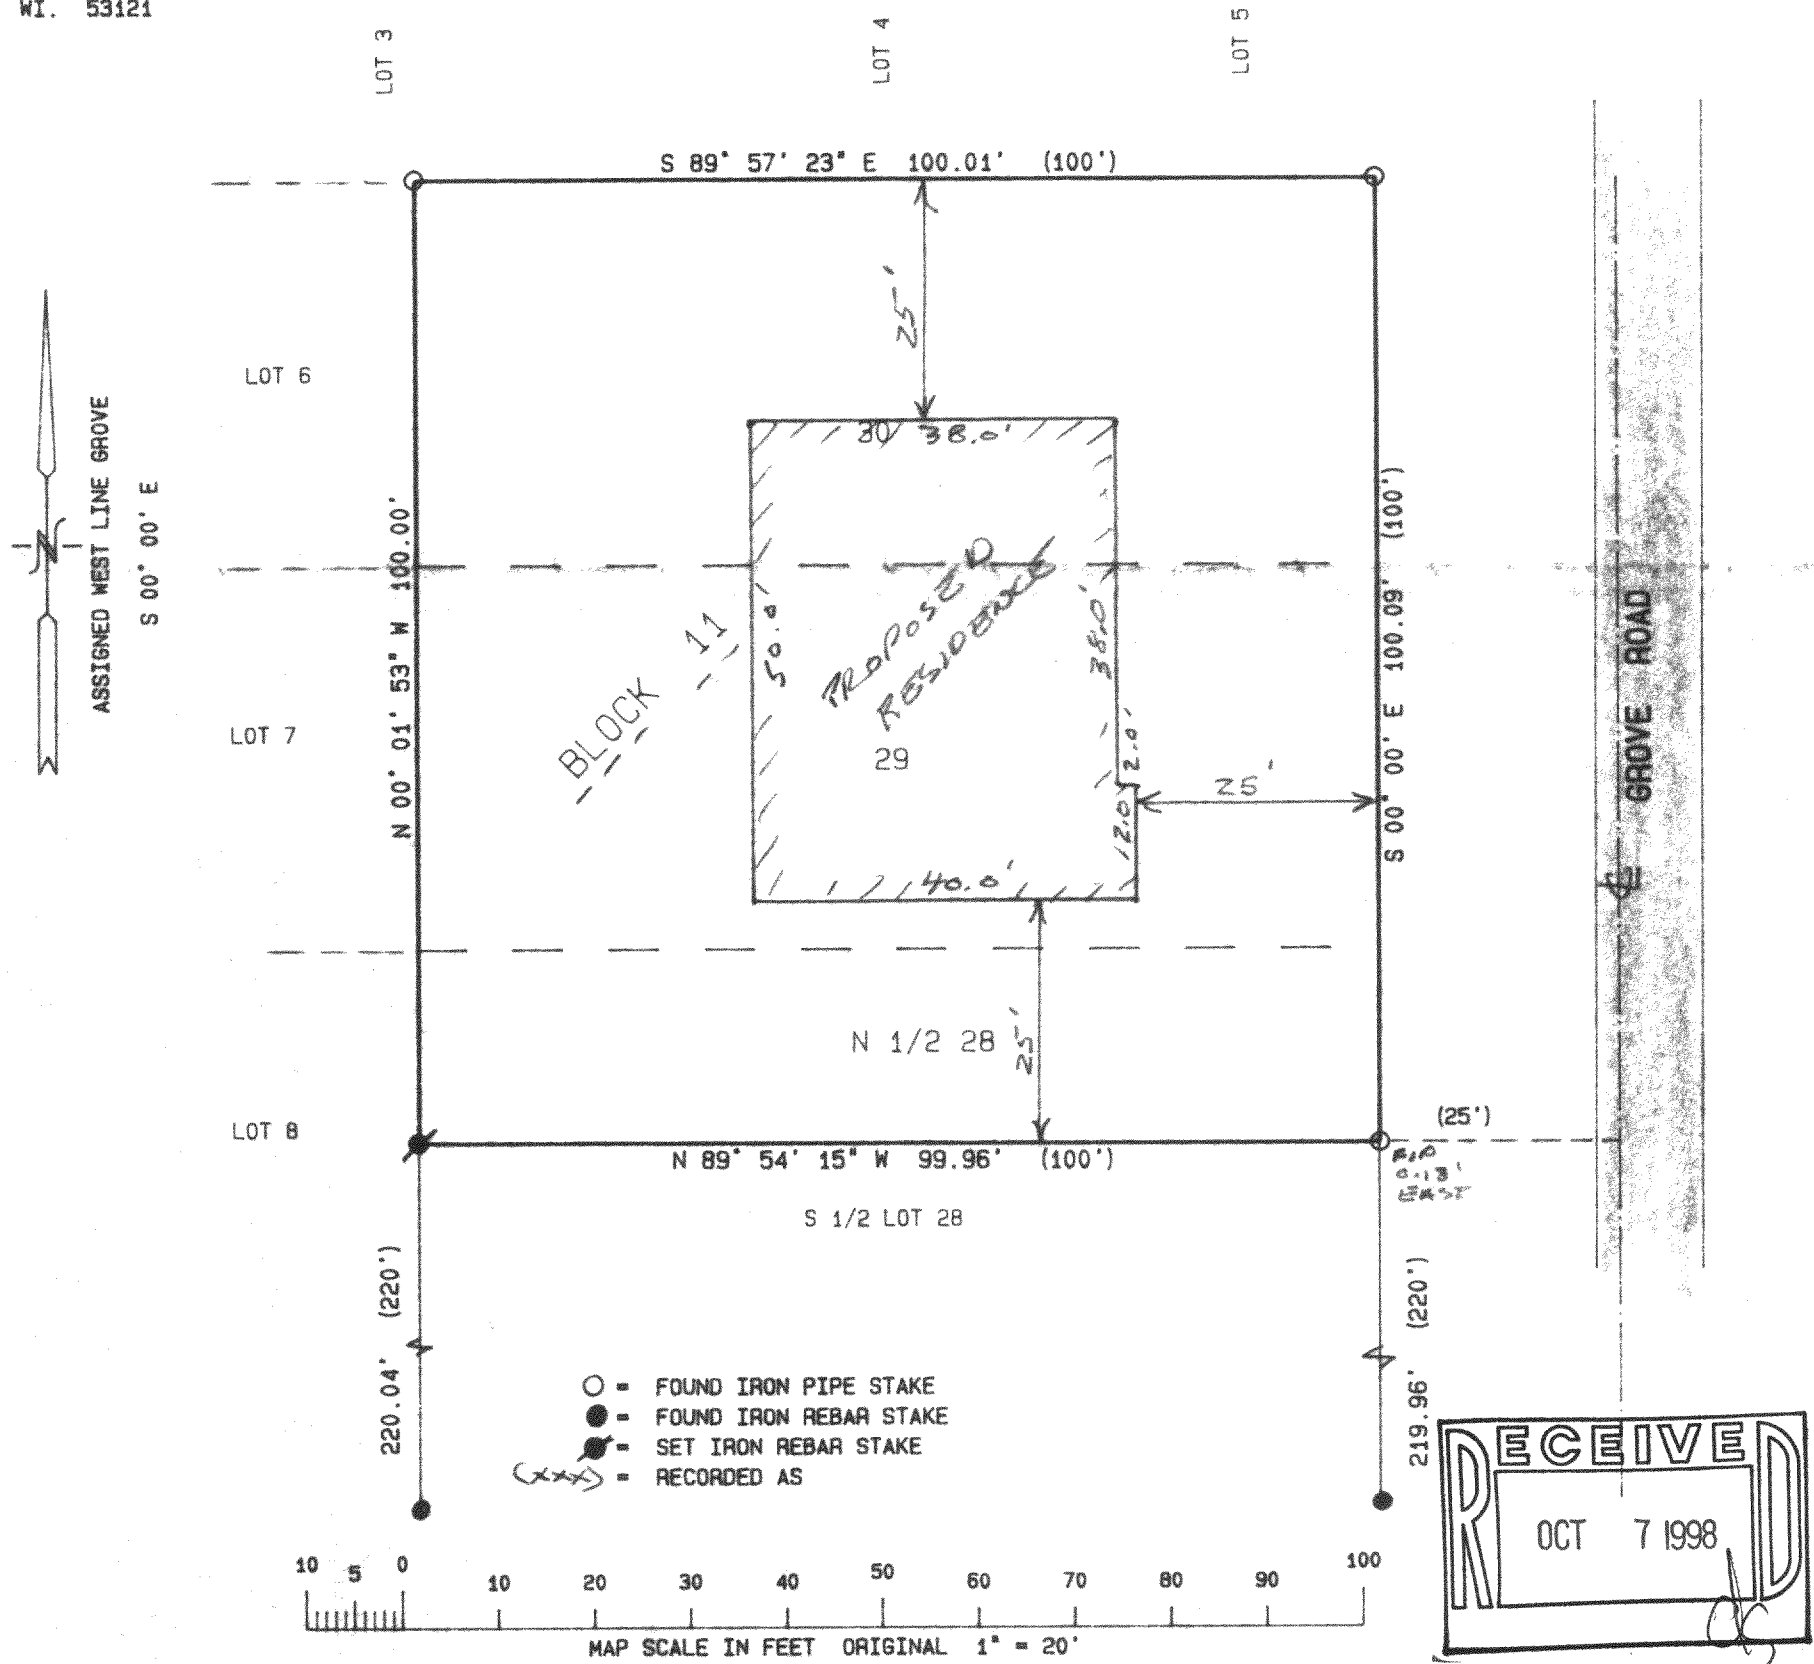


NOTE: COPIES OF THIS MAP TO WHICH THE FOLLOWING CERTIFICATE WILL APPLY ARE BLUE LINE PRINTS SHOWING SURVEYOR'S ORIGINAL SEAL AND SIGNATURE IN BLACK INK. COPIES BY ANY OTHER MEANS MAY HAVE ALTERATIONS WHICH DO NOT REPRESENT THE SURVEYOR'S WORK PRODUCT.

I HEREBY CERTIFY THAT THE ABOVE DESCRIBED PROPERTY HAS BEEN SURVEYED UNDER MY DIRECTION AND THAT THE ABOVE MAP IS A TRUE REPRESENTATION THEREOF AND SHOWS THE SIZE AND LOCATION OF THE PROPERTY AND ITS EXTERIOR BOUNDARIES. THIS SURVEY IS MADE FOR THE USE OF THE PRESENT OWNERS OF THE PROPERTY, AND ALSO THOSE WHO PURCHASE, MORTGAGE, OR GUARANTEE THE TITLE THERETO WITHIN ONE YEAR FROM THE DATE HEREOF.

DATED: 2-28-96  
 REVISED 9-15-98 - TO SHOW PROP. RES.

*Peter S. Gordon*  
 PETER S. GORDON R.L.S. 2101

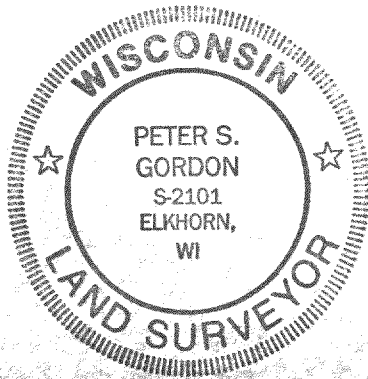

PROJ 4477  
 SHEET 1 OF 1

316-1029  
 6I-102