

FARRIS, HANSEN & ASSOCIATES, INC.

ENGINEERING, ARCHITECTURE, SURVEYING

7 RIDGWAY COURT - P.O.BOX 437, ELKHORN, WISCONSIN 53121


PHONE: (414) 723-2098 FAX: (414) 723-5886

LOTS 30, 29, & THE NORTH 1/2 OF LOT 28

BLOCK 11 OF INTERLAKEN SUBDIVISION 1st MAP
LOCATED IN THE SE 1/4 OF SEC. 11

T 3 N, R 16 E, WALWORTH COUNTY, WISCONSIN

WORK ORDERED BY: LARRY WOLF
W5490 LAKE SHORE DRIVE
ELKHORN, WI. 53121

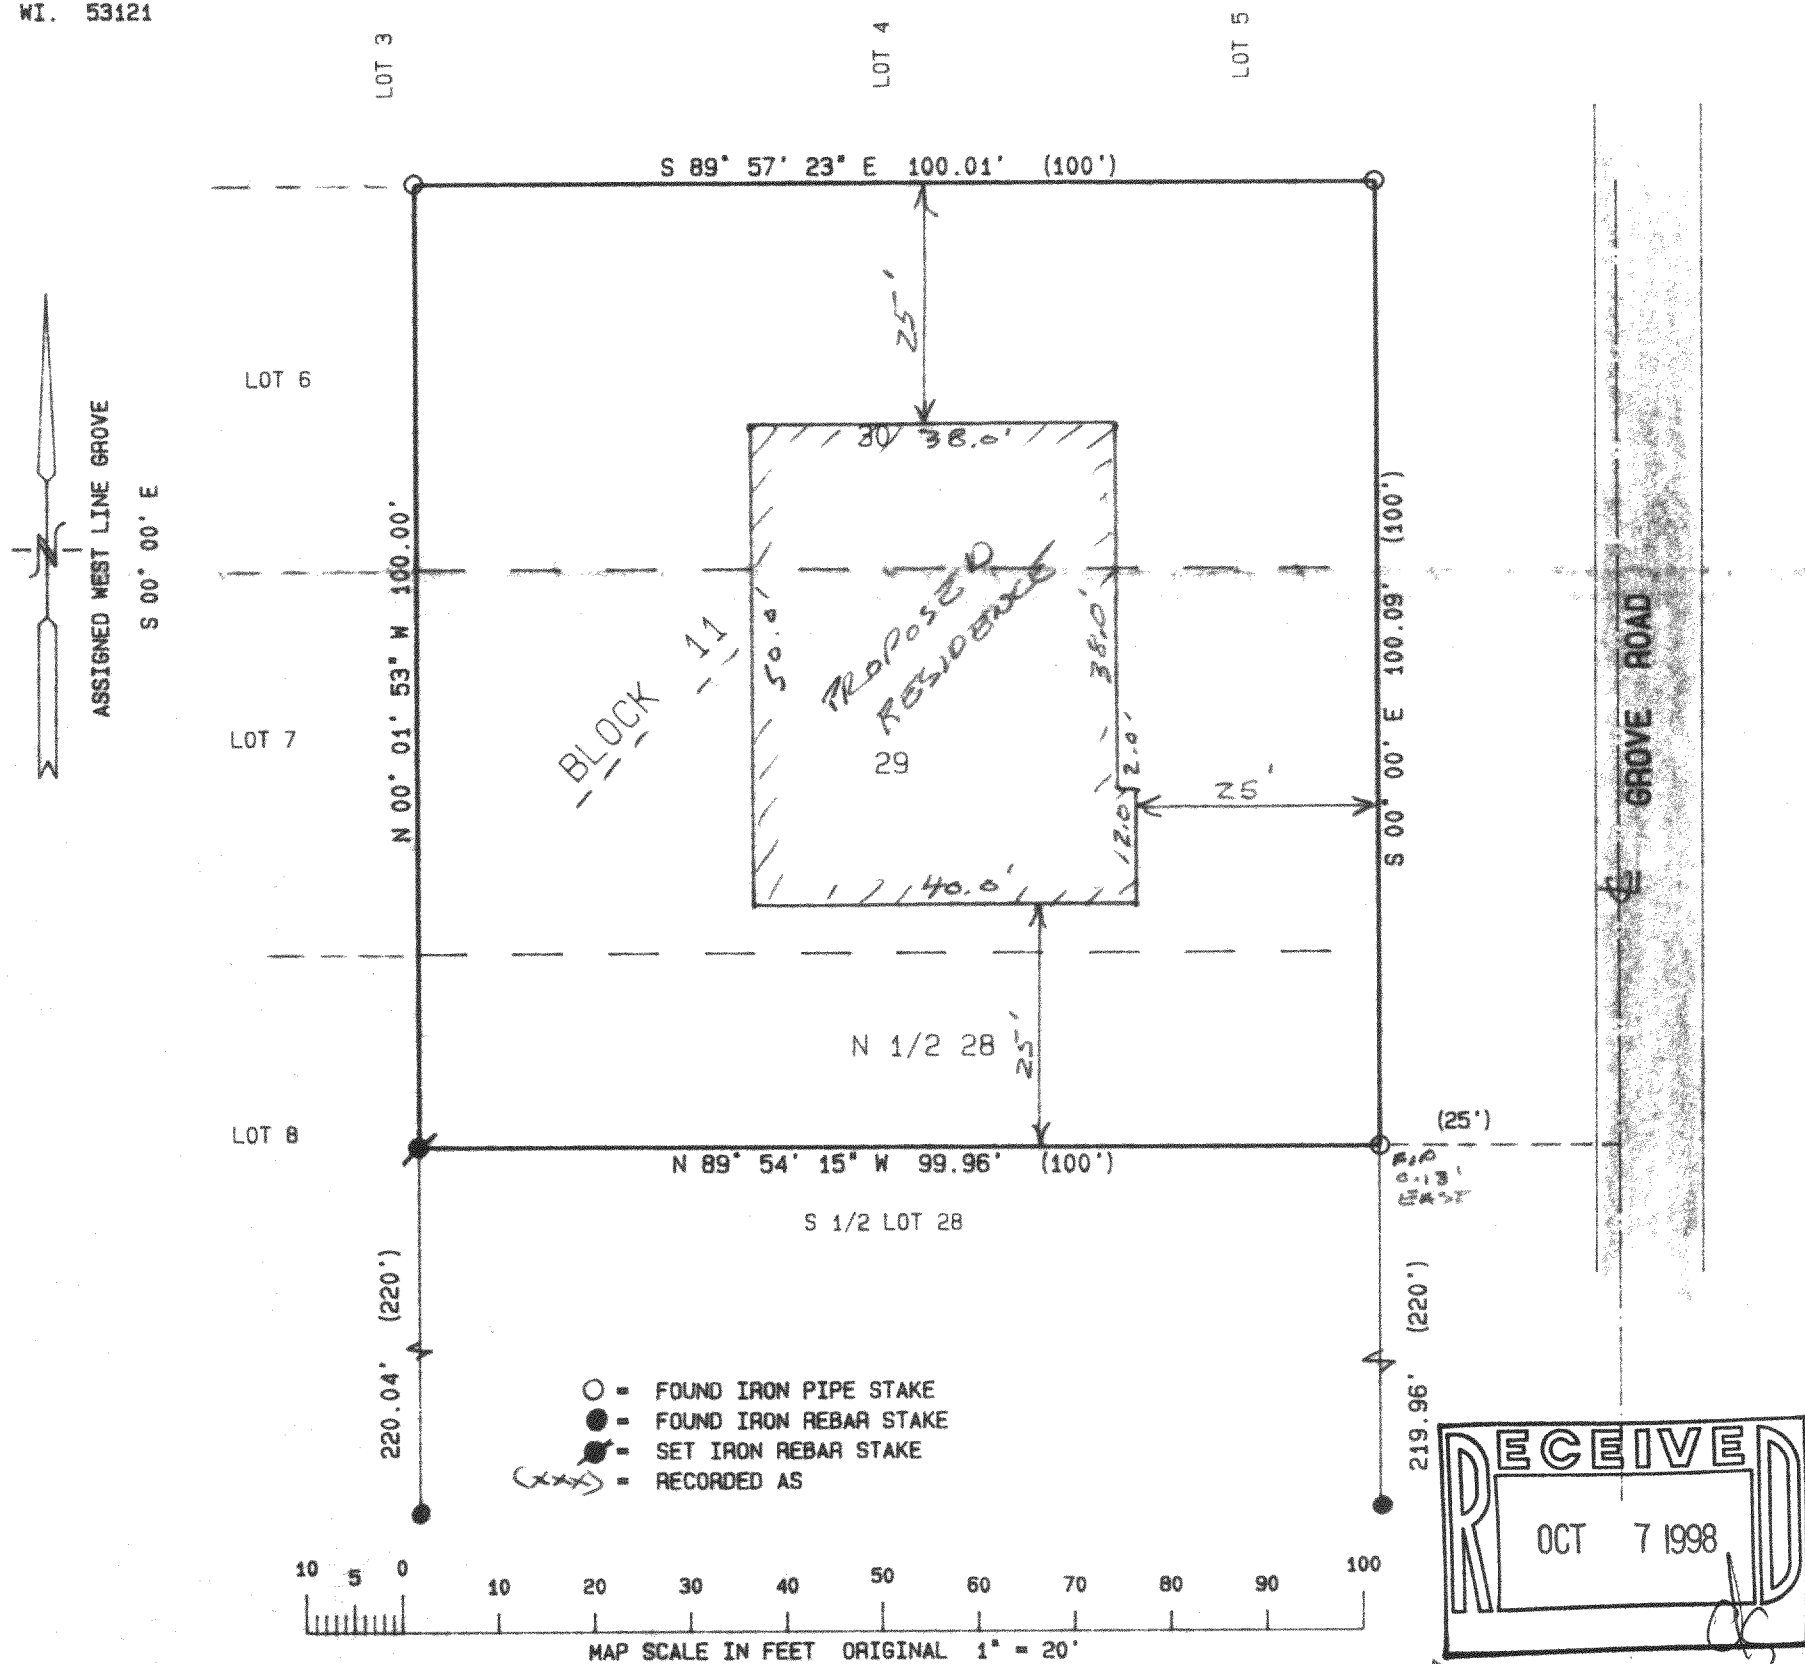


NOTE: COPIES OF THIS MAP TO WHICH THE FOLLOWING CERTIFICATE WILL APPLY ARE BLUE LINE PRINTS SHOWING SURVEYOR'S ORIGINAL SEAL AND SIGNATURE IN BLACK INK. COPIES BY ANY OTHER MEANS MAY HAVE ALTERATIONS WHICH DO NOT REPRESENT THE SURVEYOR'S WORK PRODUCT.

I HEREBY CERTIFY THAT THE ABOVE DESCRIBED PROPERTY HAS BEEN SURVEYED UNDER MY DIRECTION AND THAT THE ABOVE MAP IS A TRUE REPRESENTATION THEREOF AND SHOWS THE SIZE AND LOCATION OF THE PROPERTY AND ITS EXTERIOR BOUNDARIES. THIS SURVEY IS MADE FOR THE USE OF THE PRESENT OWNERS OF THE PROPERTY, AND ALSO THOSE WHO PURCHASE, MORTGAGE, OR GUARANTEE THE TITLE THERETO WITHIN ONE YEAR FROM THE DATE HEREOF.

DATED: 2-28-96

REvised 9-15-98 - To show Prop. RES.

Peter S. Gordon
PETER S. GORDON A.L.S. 2101

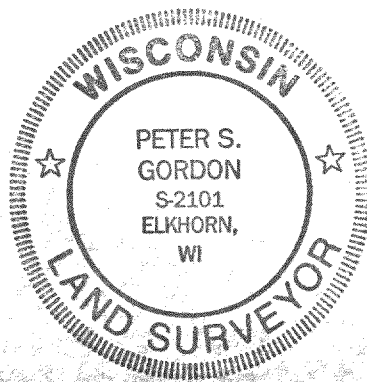

PROJ 4477

SHEET 1 OF 1

316-1029
GI-102