

STATE OF WISCONSIN  
COUNTY OF RACINE



The above-described property has been surveyed under my direction and the above map is a correct representation thereof.

DATED AT: NORTH CAPE, THIS 9TH DAY OF APRIL, 1999.


*P. L. Bailey*  
AMERICAN SURVEYING COMPANY, INC.  
PETE L. BAILEY, RLS NO. 1398  
RECERTIFIED this 12TH day of JULY, 1999.

LEGAL DESCRIPTION:

-LOT 44 OF "LAUDERDALE LAKE ESTATES", A CONDOMINIUM OF A PART OF THE NORTHWEST 1/4 AND THE SOUTHWEST 1/4 OF THE SOUTHWEST 1/4 AND THE SOUTHWEST 1/4 OF THE NORTHEAST 1/4 OF SECTION 1, TOWN 3 NORTH, RANGE 16 EAST, IN TOWN OF TOWN OF SUGAR CREEK, COUNTY OF WALWORTH, STATE OF WISCONSIN.

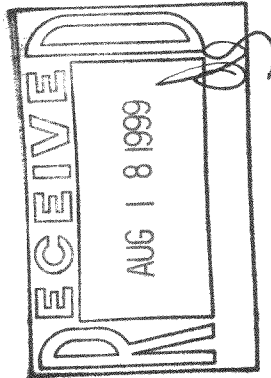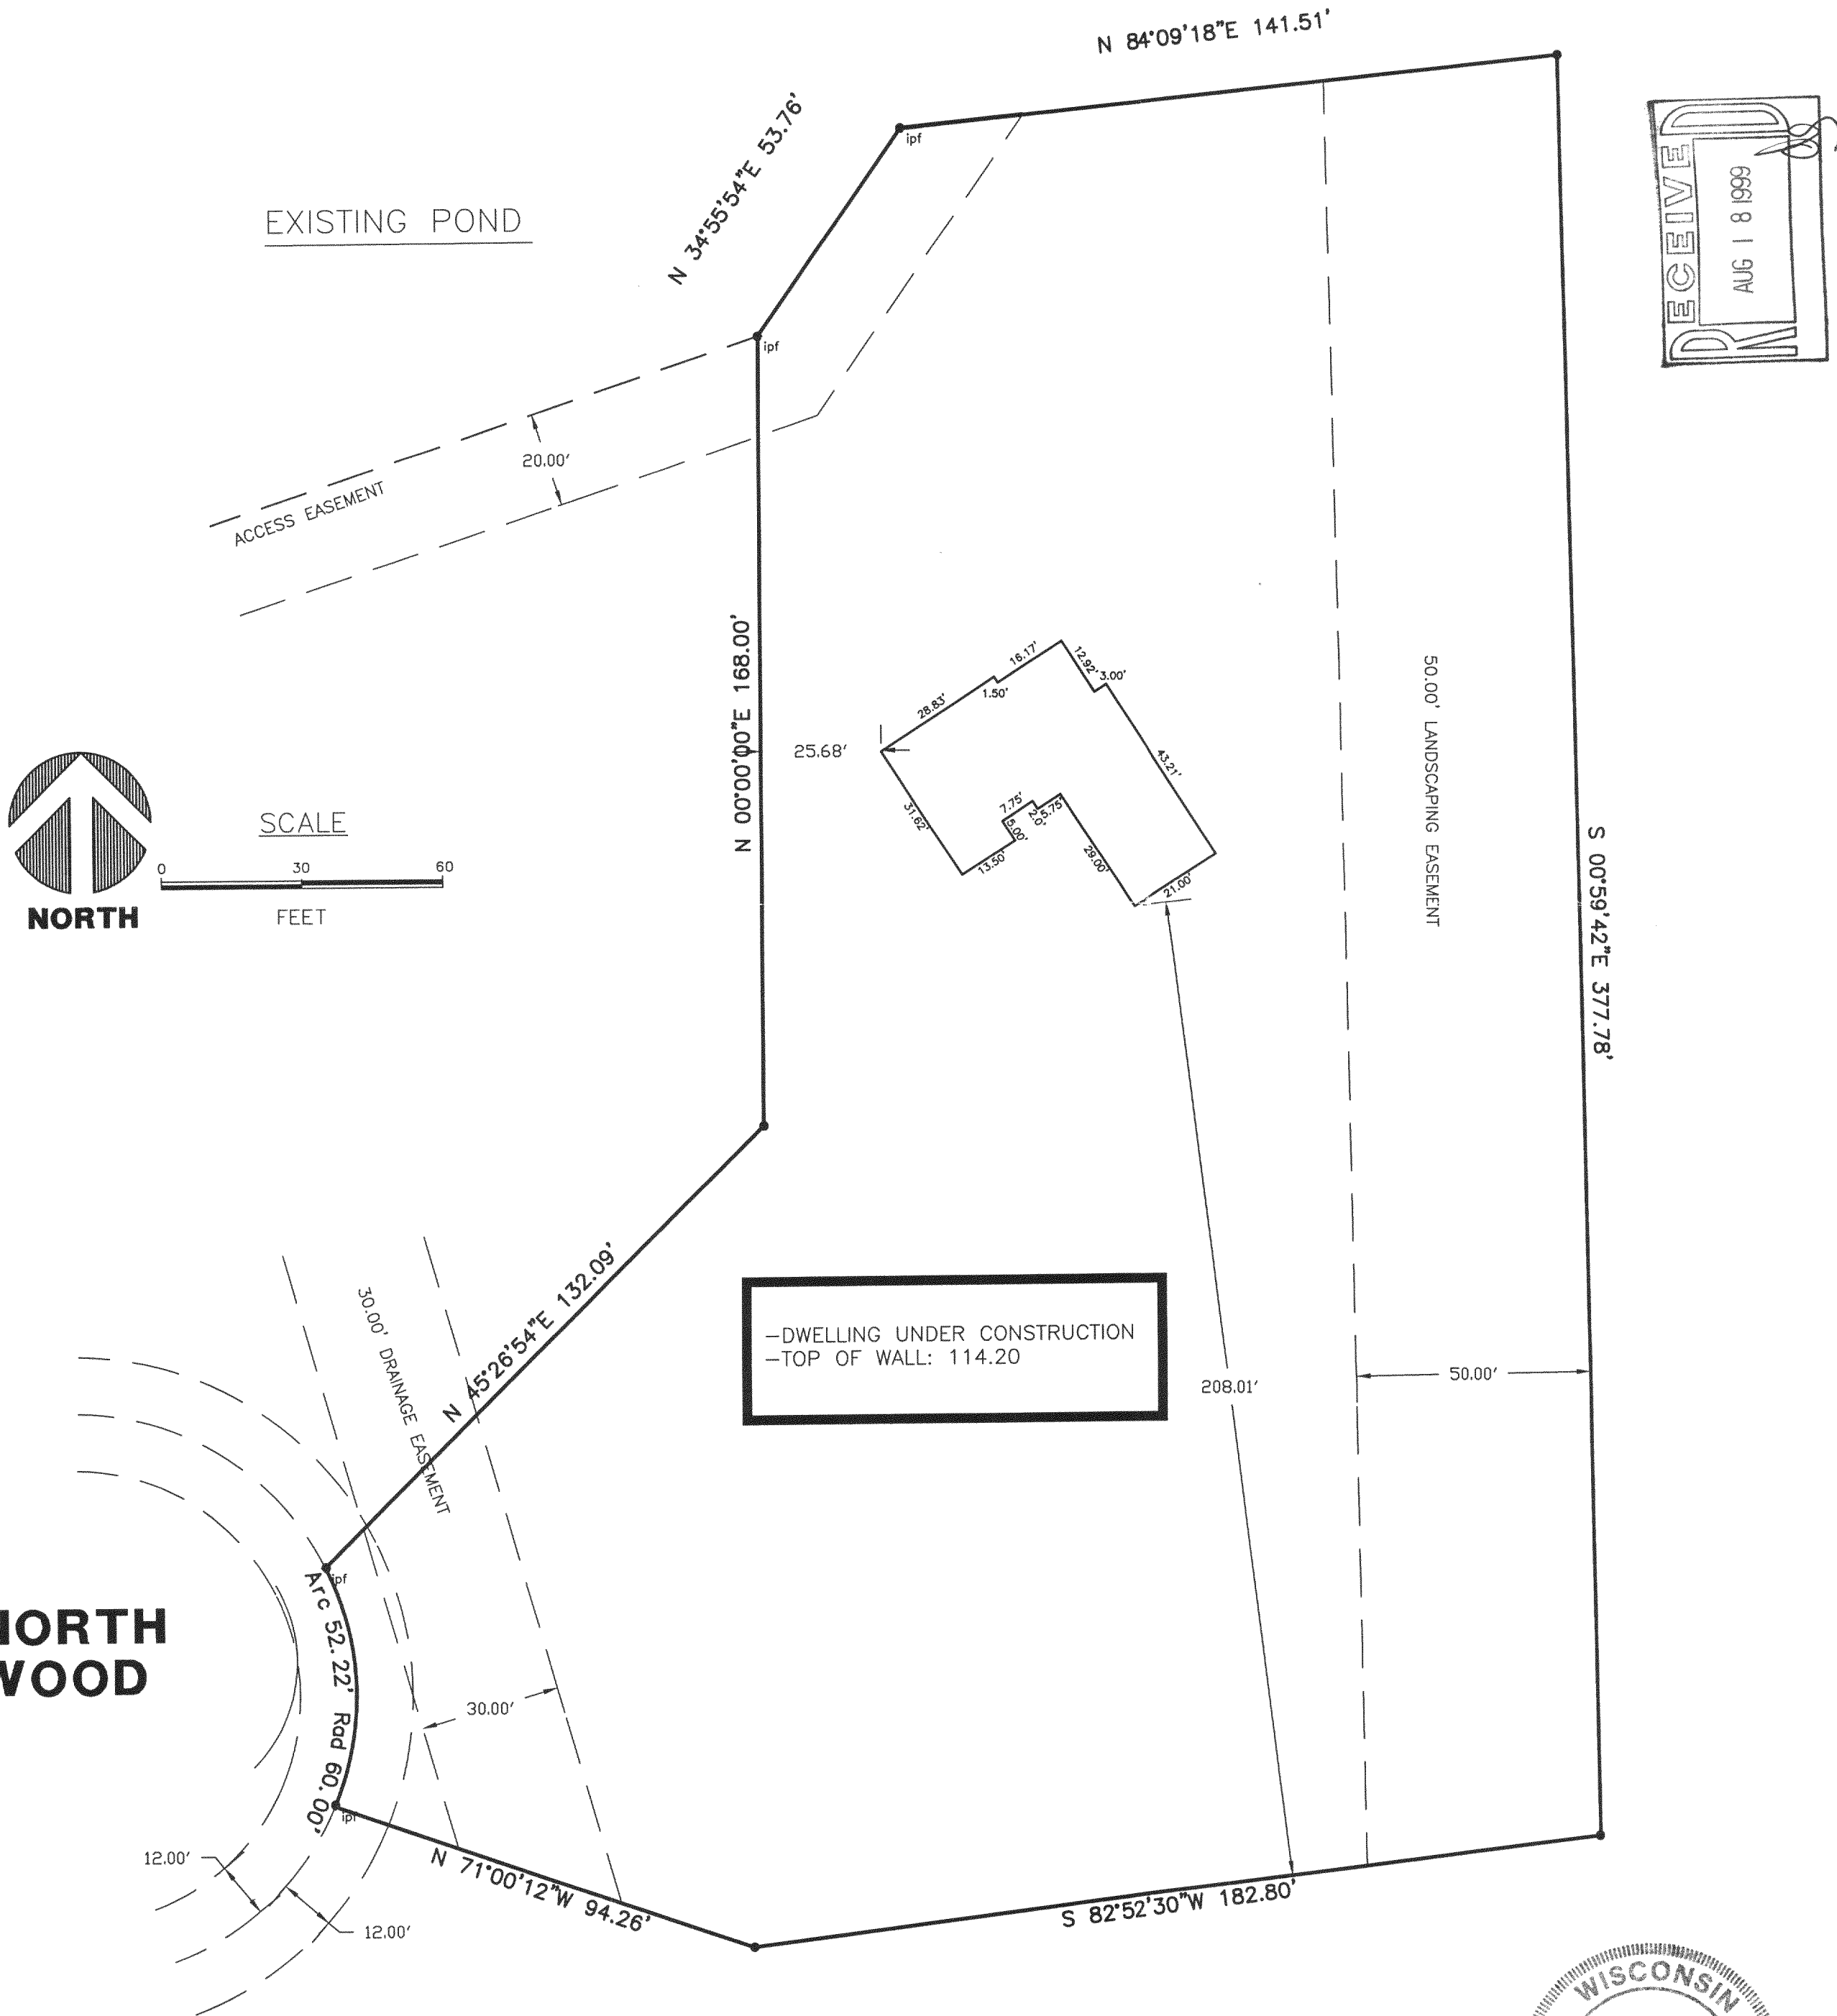

AMERICAN  
SURVEYING  
COMPANY, INC.

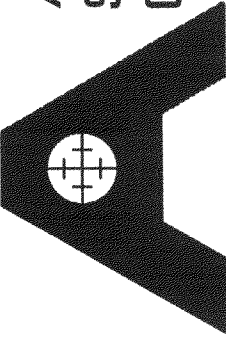

12207 C.T.H. "K" FRANKSVILLE, WISCONSIN 53126  
TEL. (414) 835-4774 FAX: (414) 835-2379

DRAWN BY:	PLB	REVISIONS:	DATE
CHECKED BY:	PLB	07/12/99:	RECERTIFIED
PLOT SCALE:	1 = 30		
DATE:	04/09/99		
JOB NO.:	99065		
DWG. FILE:	JN99080		

TOWN OF SUGAR CREEK

PROJECT:  
PLAT OF SURVEY / STAKE OUT SURVEY

OWNERS, STEVE & KIM KEMP  
PREPARED FOR, PEMBROOKE HOMES, LLC.

Sheet  
1  
of  
1

06LE-21 316-1112