
PLAT OF SURVEY LOT 19 OF SYLVAN TRACE SUBDIVISION

LOCATED IN PART OF SECTION 2, TOWN 3 NORTH RANGE 16 EAST, WALWORTH COUNTY, WISCONSIN

FARRIS, HANSEN & ASSOCIATES, INC.

ENGINEERING, ARCHITECTURE, SURVEYING 7 RIDGEWAY COURT - P.O. BOX 437, ELKHORN, WISCONSIN, 53121 PHONE: (414) 723-2098 FAX: (414) 723-5886

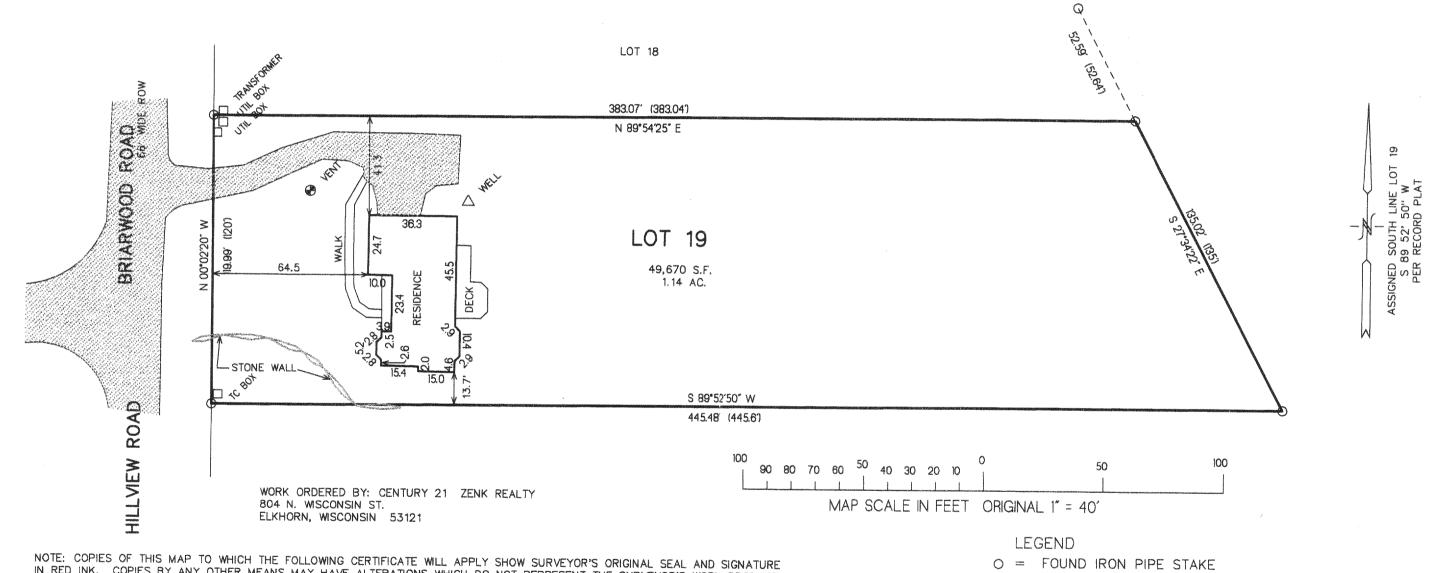

DATED: FEB. 02, 2000

FEB 2 2 2000

IN RED INK. COPIES BY ANY OTHER MEANS MAY HAVE ALTERATIONS WHICH DO NOT REPRESENT THE SURVEYOR'S WORK PRODUCT.

O = FOUND IRON PIPE STAKE (xxx) = RECORDED AS

I HEREBY CERTIFY THAT THE ABOVE DESCRIBED PROPERTY HAS BEEN SURVEYED UNDER MY DIRECTION AND THAT THE ABOVE MAP IS A TRUE REPRESENTATION THEREOF AND SHOWS THE SIZE AND LOCATION OF THE PROPERTY AND ITS EXTERIOR BOUNDARIES. THIS SURVEY IS MADE FOR THE USE OF THE PRESENT OWNERS OF THE PROPERTY, AND ALSO THOSE WHO PURCHASE, MORTGAGE, OR GUARANTEE THE TITLE THERETO WITHIN ONE YEAR FROM THE DATE HEREOF.

PROJECT 4106.99

SHEET 1 OF 1