


CURVE DATA	SYMBOL	DELTA	RADIUS	TAN	LENGTH	LONG CHORD
A	51°01'32"	130.29	62.18	116.03	S 7°01'14" W	112.23
(A)	51°09'00"	(130.289)	(62.354)	(116.314)	(S 6°57'30" W)	(112.489)
B	51°01'32"	105.29	50.25	93.77	S 7°01'14" W	90.70

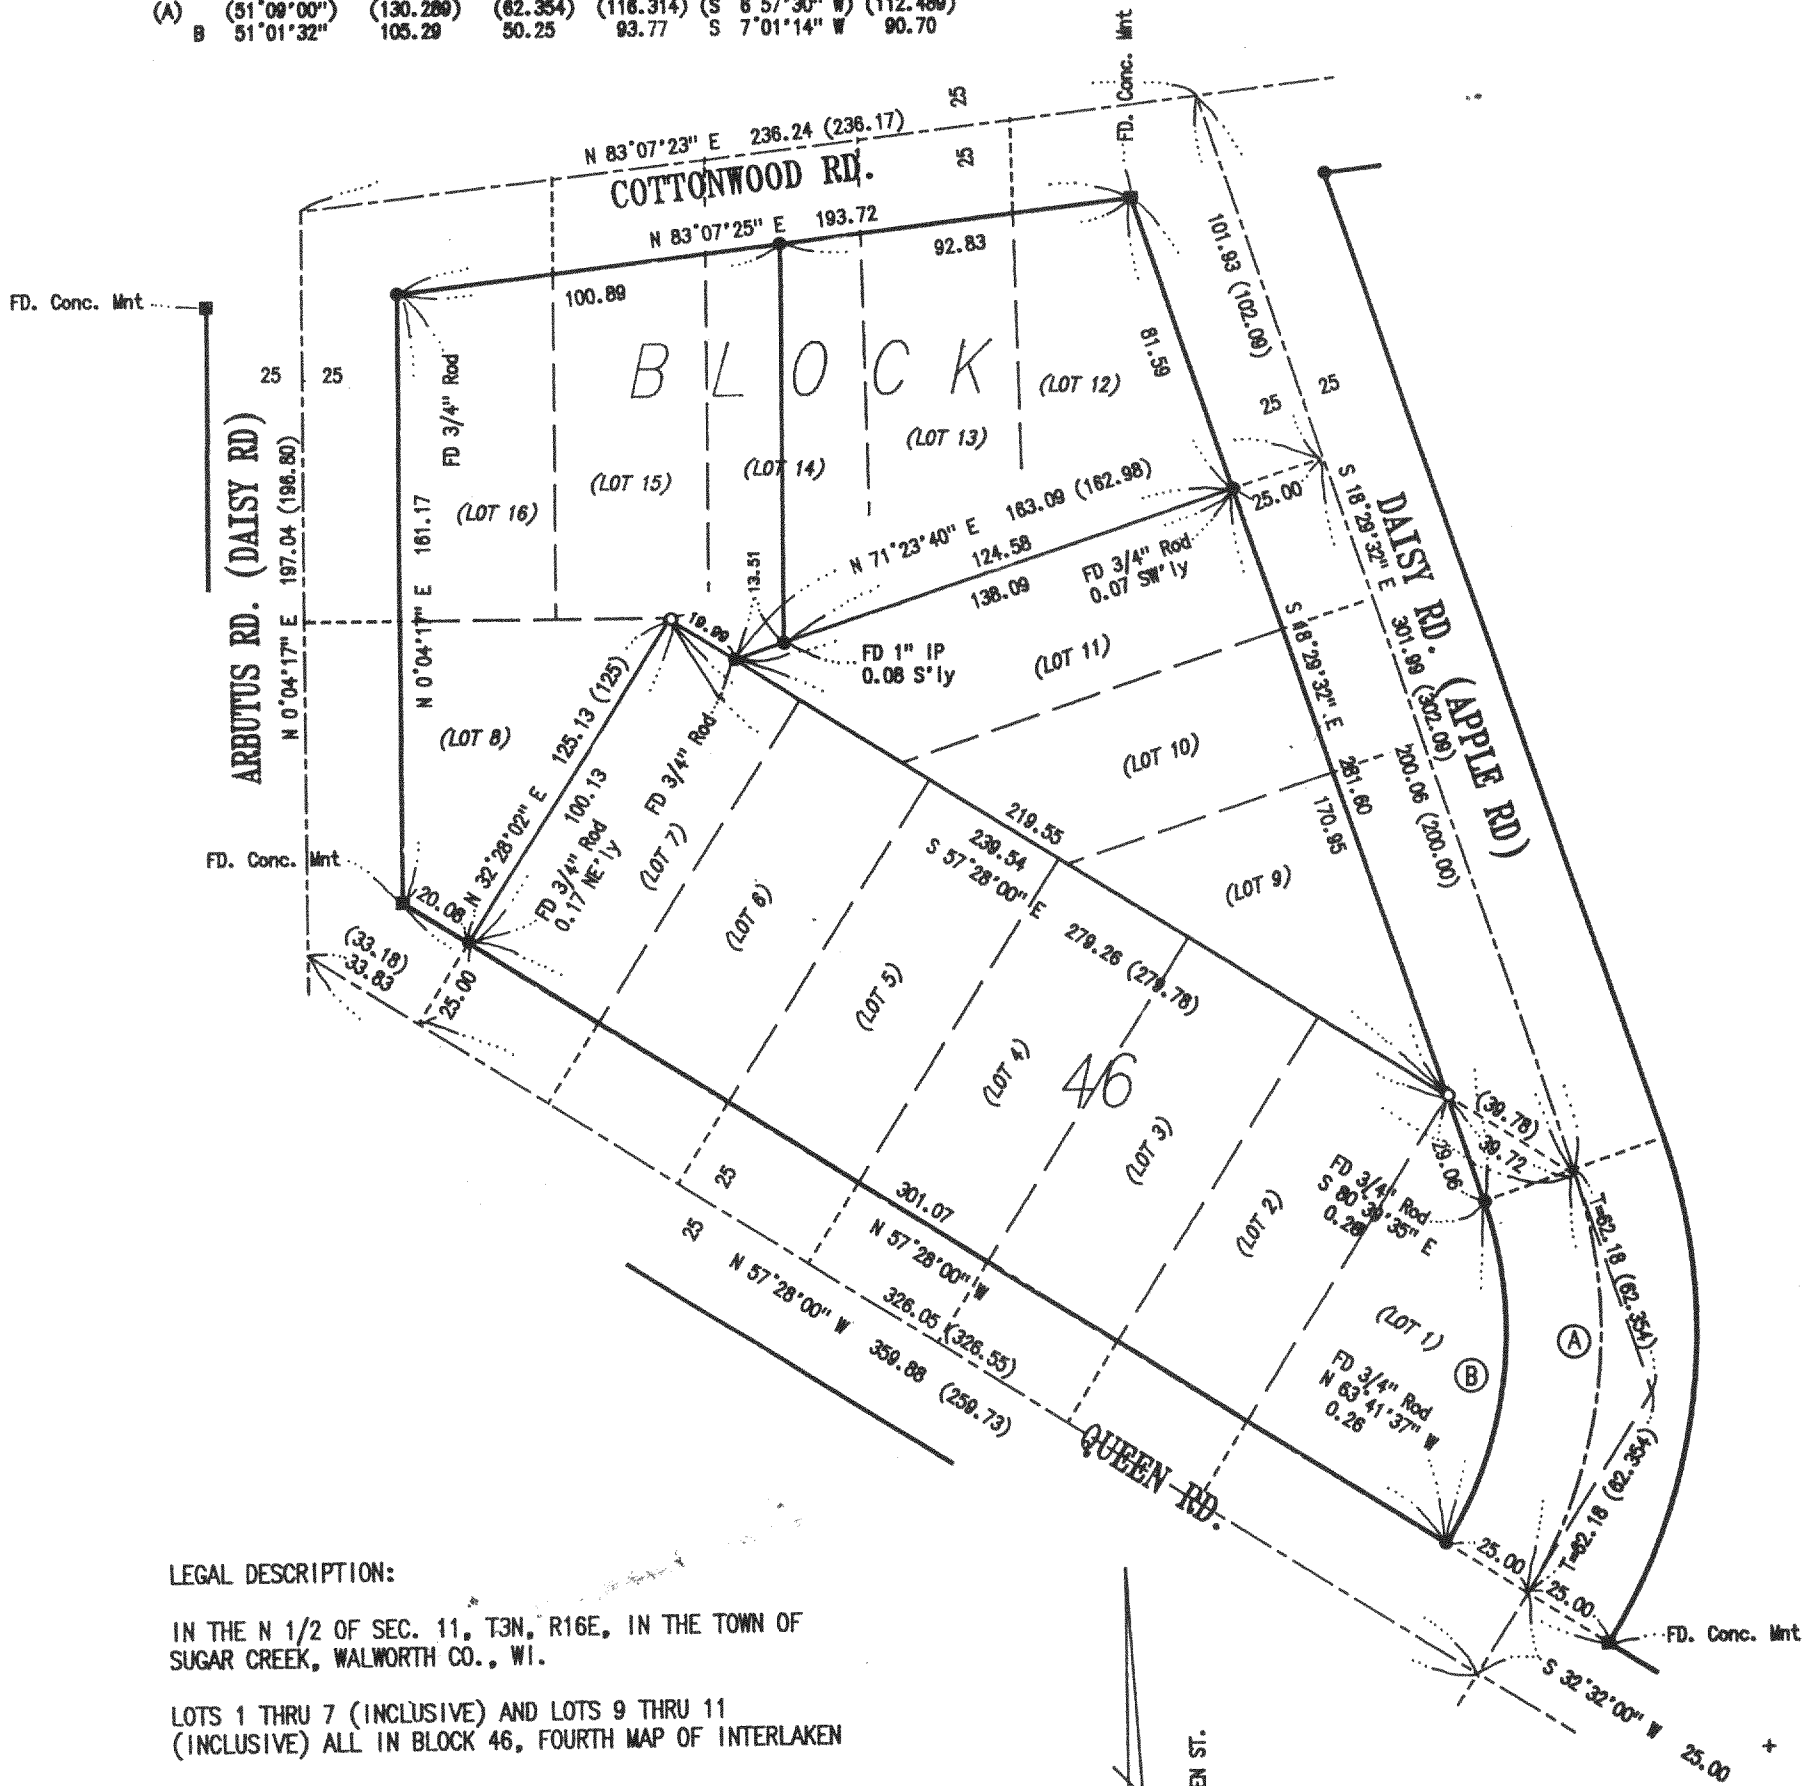

LEGAL DESCRIPTION:

IN THE N 1/2 OF SEC. 11, T3N, R16E, IN THE TOWN OF SUGAR CREEK, WALWORTH CO., WI.

LOTS 1 THRU 7 (INCLUSIVE) AND LOTS 9 THRU 11 (INCLUSIVE) ALL IN BLOCK 46, FOURTH MAP OF INTERLAKEN


SURVEYOR'S CERTIFICATE

I, JAMES K. LANGONE, REGISTERED LAND SURVEYOR, CERTIFY THAT I HAVE SURVEYED THE PROPERTY DESCRIBED HEREON AND THAT THIS PLAT IS A TRUE AND CORRECT REPRESENTATION OF THE BOUNDARIES THEREOF.

DATE: 3/24/00

JAMES K. LANGONE
REGISTERED LAND SURVEYOR S-1347
WHITEWATER
WI
LAND SURVEYOR

BASIS OF BEARINGS:
THE N'LY LINE OF QUEEN ST.
BEING N 57°28'00" W

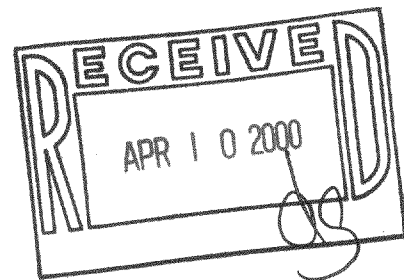

NOTES:

- () -- Indicates Record Data
- Indicates FD. Conc. Mnt.
- Indicates Mnt. FD. as Noted
- Indicates SET 1" Iron Pipe

JAMES K. LANGONE LAND SURVEYS & CIVIL ENGINEERING			
N339 Co. Rd. "N" (Upper)		Whitewater, WI. 53190-2842	(262) 473-4119
SCALE	1" = 50'	APPROVED BY	DRAWN BY JKL
DATE	3/23/00		REVISED
PLAT OF SURVEY POR. BLK. 46, FOURTH MAP OF INTERLAKEN			
CLIENT	MORGAN	DRAWING NUMBER	00-103

GI-422 GI-426
GI-423
GI-424

316-1168