## FARRIS, HANSEN & ASSOCIATES, INC.


ENGINEERING - ARCHITECTURE - SURVEYING
7 RIDGWAY COURT - P.O. BOX 437 - ELKHORN, WISCONSIN 53121
PHONE: (262) 723-2098 FAX: (262) 723-5886

## PLAT OF SURVEY

LOTS 6, 7, & 8 OF BLOCK 118 OF LAKE WANDAWEGA SUBDIVISION

LOCATED IN THE SW 1/4 OF SECTION 1, TOWN 3 NORTH, RANGE 16
FAST, WALWORTH COUNTY, WISCONSIN

- WORK ORDERED BY -MARY ANN JOHNSON 3617 N. CHRISTIANA CHICAGO, IL. 60618

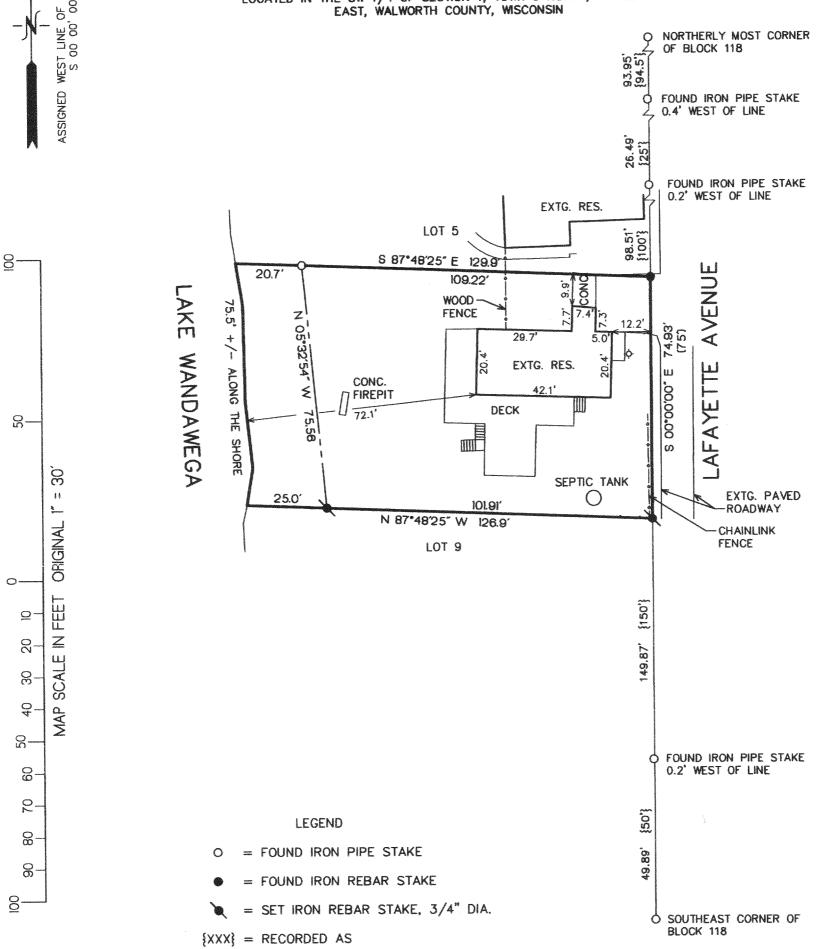

NOTE: COPIES OF THIS MAP TO WHICH THE FOLLOWING CERTIFICATE WILL APPLY SHOW THE SURVEYOR'S ORIGINAL SEAL AND SIGNATURE IN RED INK. COPIES BY ANY OTHER MEANS MAY HAVE ALTERATIONS WHICH DO NOT REPRESENT THE SURVEYOR'S WORK PRODUCT.

I HEREBY CERTIFY THAT THE ABOVE DESCRIBED PROPERTY HAS BEEN SURVEYED UNDER MY DIRECTION AND THAT THE ABOVE MAP IS A TRUE REPRESENTATION THEREOF AND SHOWS THE SIZE AND LOCATION OF THE PROPERTY AND ITS EXTERIOR BOUNDARIES. THIS SURVEY IS MADE FOR THE USE OF THE PRESENT OWNERS OF THE PROPERTY, AND ALSO THOSE WHO PURCHASE, MORTGAGE, OR GUARANTEE THE TITLE THERETO WITHIN ONE YEAR FROM THE DATE HEREOF.

DATED: 5.22. 2000

PETER S. GORDON R.L.S. 2101

DEGEIVED JUL 13 2000

PETER S.
GORDON
ASSA101
ELICHORN,
WI

STATISTICAL
STAT

PROJECT: 5588 DATE: 05/22/2000 SHEET 1 OF 1

GLW-360

MAY 2 2 200