

STATE OF WISCONSIN
COUNTY OF RACINE




The above-described property has been surveyed under my direction and the above map is a correct representation thereof.

DATED AT: NORTH CAPE, THIS 12TH DAY OF JUNE, 2000.


Pete L. Bailey
AMERICAN SURVEYING COMPANY, INC.
PETE L. BAILEY, RLS NO. 1398
RECERTIFIED this _____ day of _____, 2000.

LEGAL DESCRIPTION:

UNIT 70 OF "LAUDERDALE LAKES CONDOMINIUM" BEING A PART OF THE NORTHWEST 1/4 OF THE SOUTHEAST 1/4 OF SECTION 1, TOWN 3 NORTH, RANGE 16 EAST, IN THE TOWN OF SUGAR CREEK, COUNTY OF WALWORTH, STATE OF WISCONSIN.

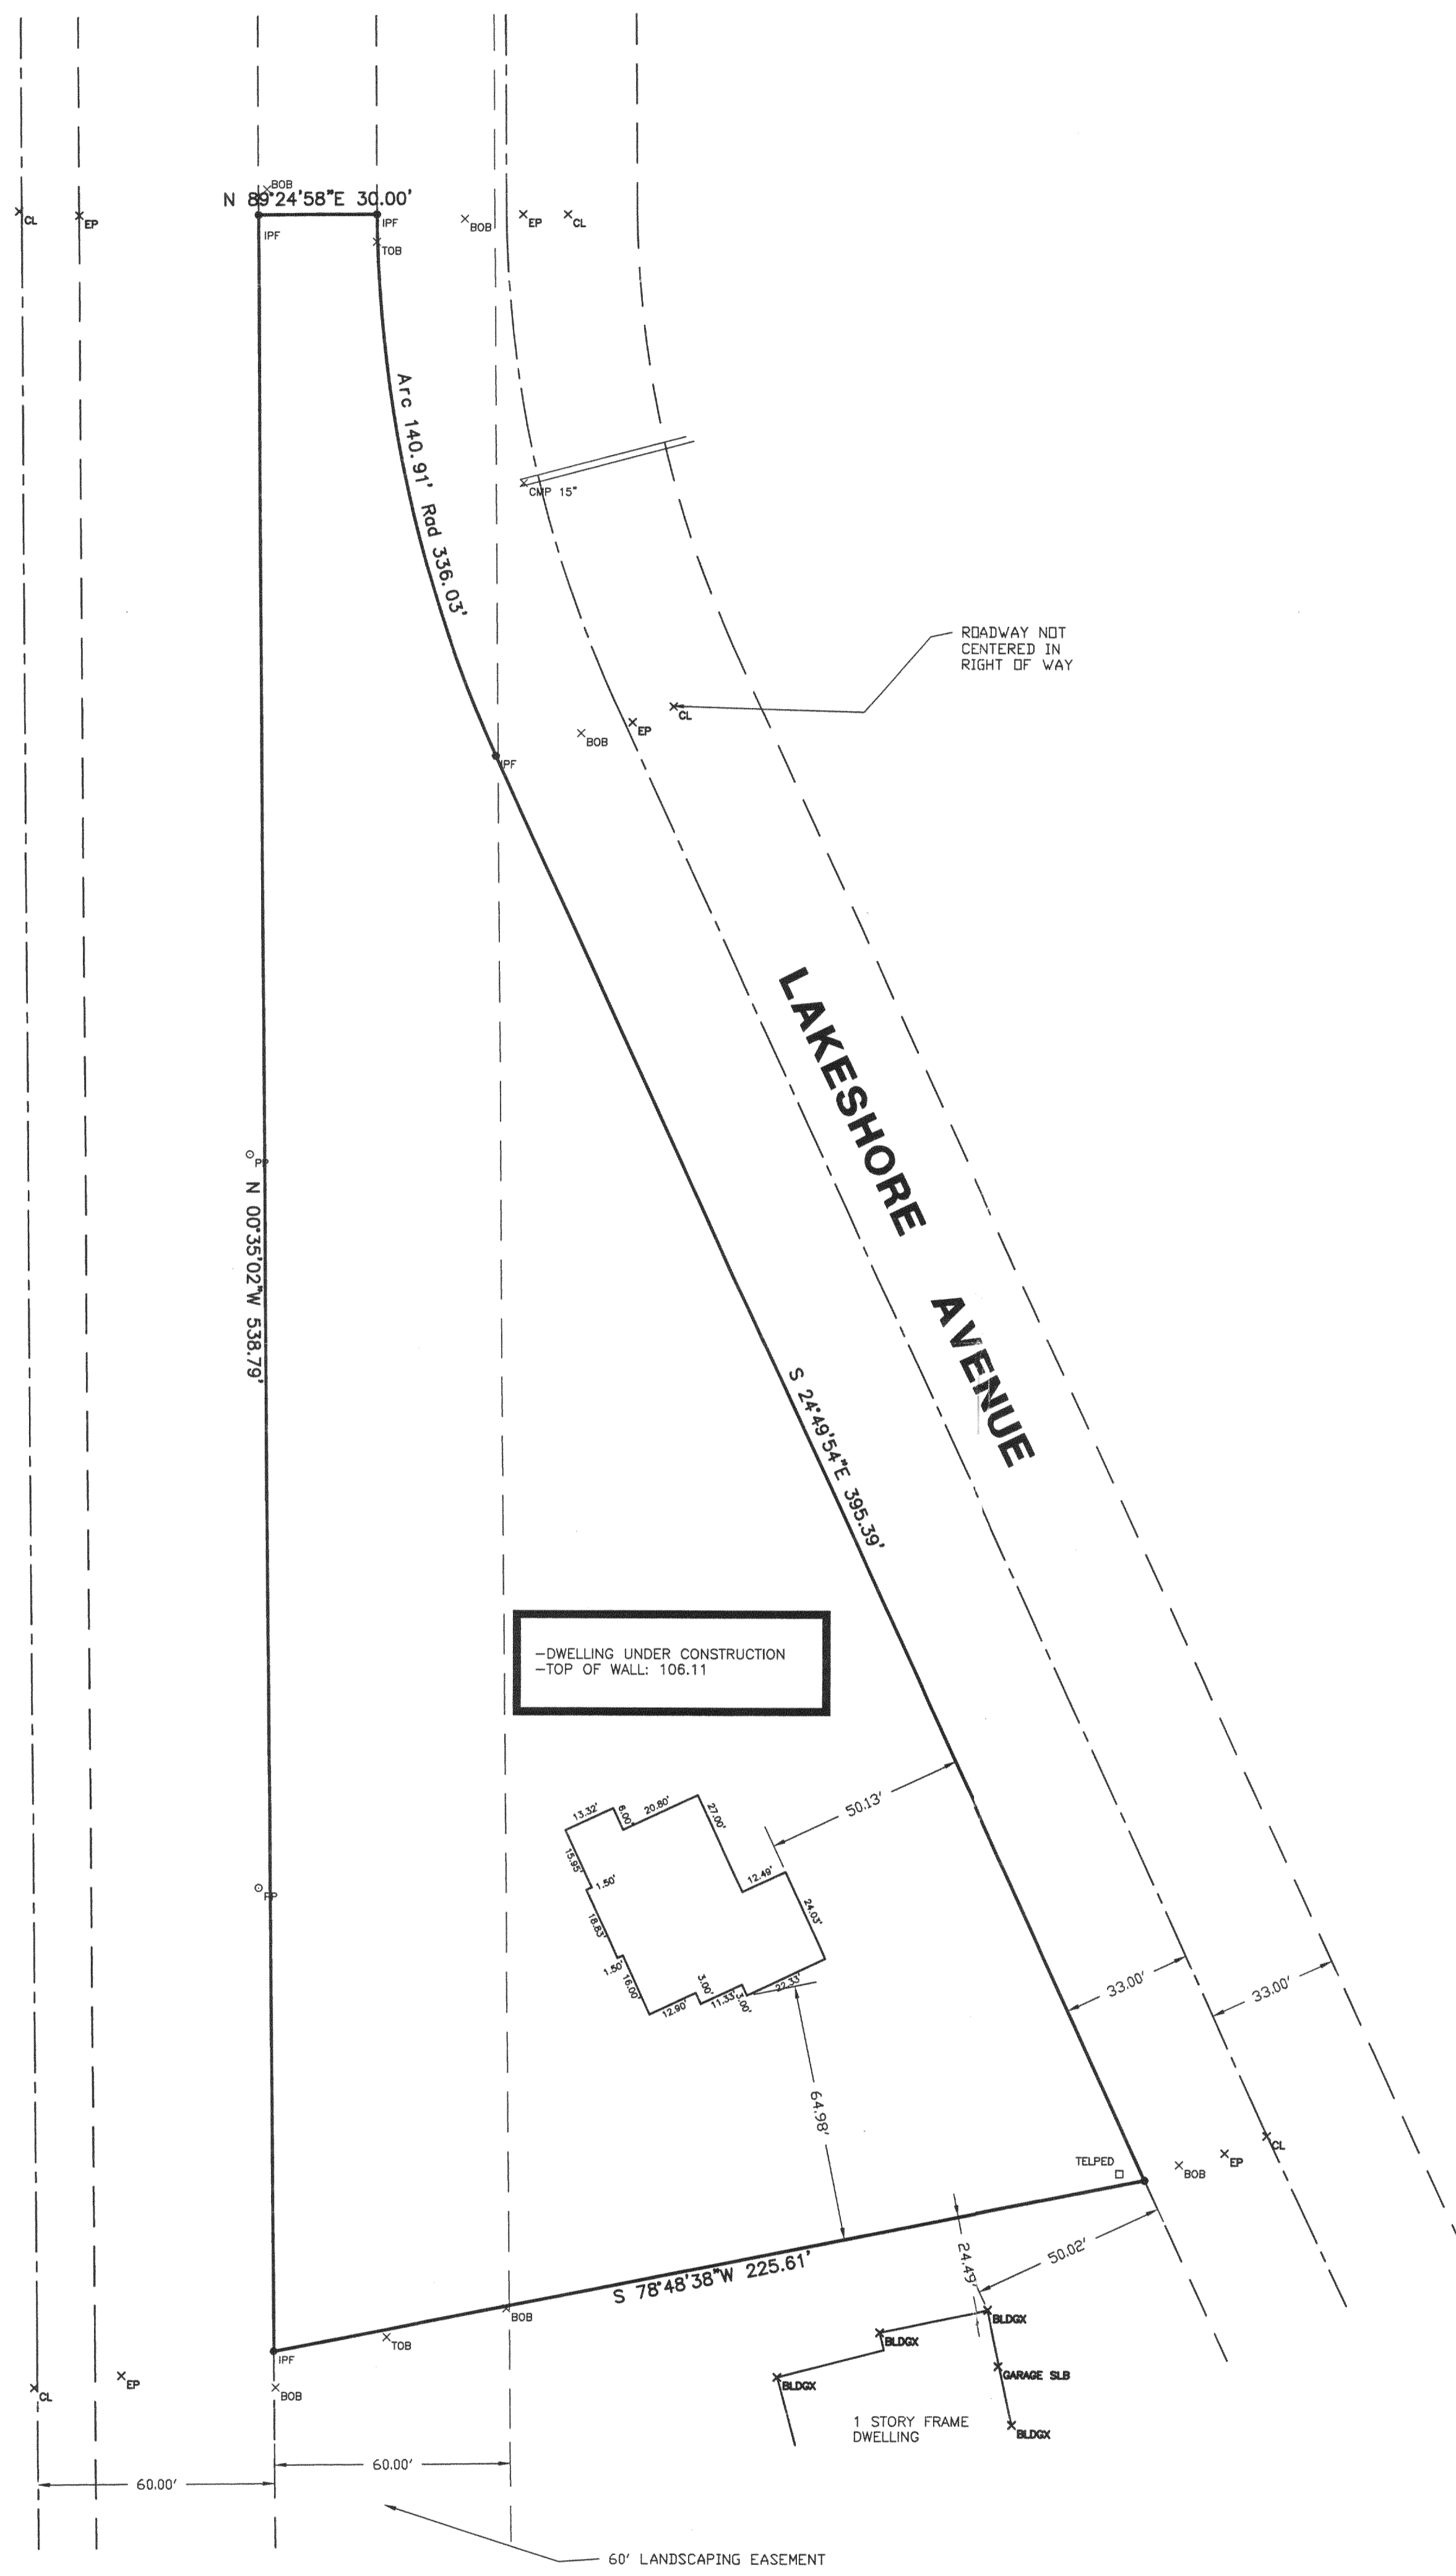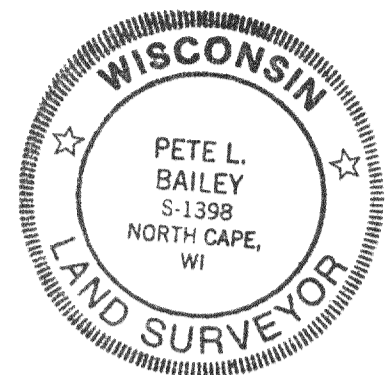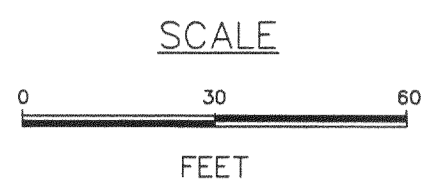

S.T.H. 67

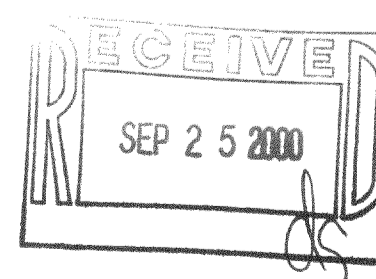

TOWN OF SUGAR CREEK

PROJECT:
PLAT OF SURVEY/STAKE OUT SURVEY
PREPARED FOR: PEMBROOKE HOMES, LLC

DRAWN BY: PLB	REVISIONS: DATE
CHECKED BY: PLB	06/16/00: TURN ON LAYER
PLOT SCALE: 1 = 30	
DATE: 06/12/2000	
JOB NO.: 2000129	
DWG. FILE: JN200135	



AMERICAN SURVEYING COMPANY, INC.
12207 C.T.H. "K" FRANKSVILLE, WISCONSIN 53126
TEL. (262) 835-4774 FAX: (262) 835-2379

Sheet
1 of 1