



PLAT OF SURVEY

OF

J.K. SURVEYING
JEFFREY L. KIMPS R.L.S.
7561 336TH AVE.
BURLINGTON WI 53105
414-537-4274

LOTS 29,30 AND 31, EXCEPT THE SOUTH 20.00 FEET OF LOT 31, BLOCK 2, INTERLAKEN,
TOWN OF SUGAR CREEK, WALWORTH COUNTY, WISCONSIN.

PREPARED FOR : RJ AMANN BUILDERS LLC
PO BOX 643
LAKE GENEVA, WI 53147

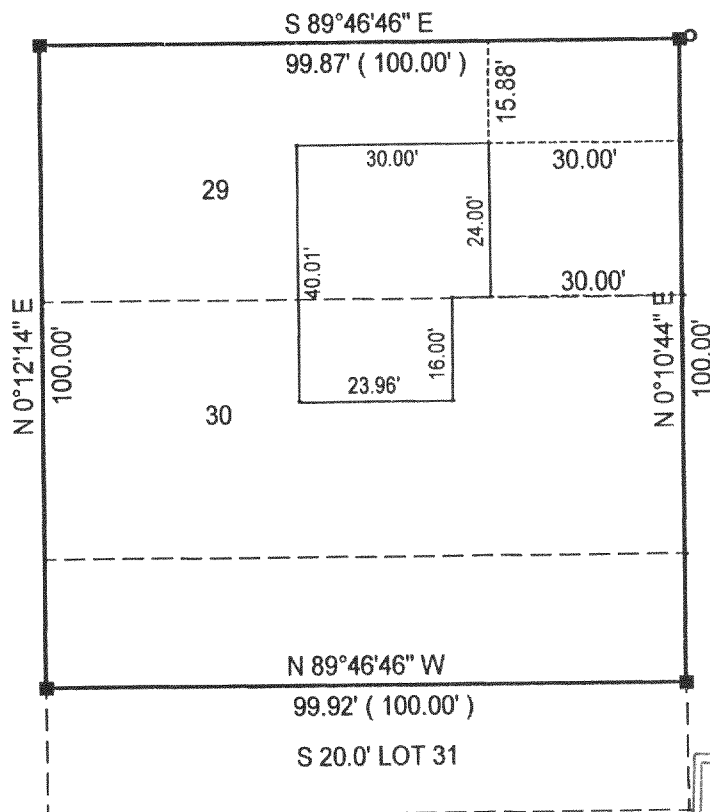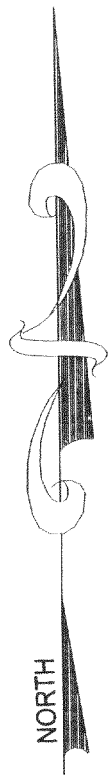

- () = recorded as
- = set iron bar
- = found iron bar
- = found iron pipe
- = set iron pipe

JOB# 00-232E

SCALE: 1"=30'

TAX KEY #

FOUNDATION AS BUILT 9-27-2000 J.L.K.



COMPARE LEGAL DESCRIPTION ABOVE AND DRAWING WITH DEED, FOR BUILDING RESTRICTIONS AND EASEMENTS NOT SHOWN, REFER TO DEED, ABSTRACT SOURCES AND LOCAL MUNICIPAL CODES. NOTIFY THE SURVEYOR IMMEDIATELY OF ANY DISCREPANCY.

"I hereby certify that I have surveyed the above described property and that the above map is a true representation thereof and shows the size and location of all visible structures, apparent easements and encroachments if any."

This survey is made for the present owners of the property, and those who purchase, mortgage, or guarantee the title thereto, within one year from the date hereof.

DATED THIS 1 TH DAY OF JUNE 20 00

JEFFREY L. KIMPS S-2436-008

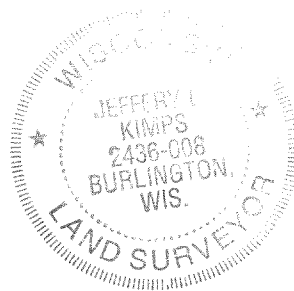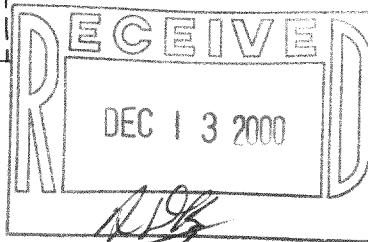

61-8A