
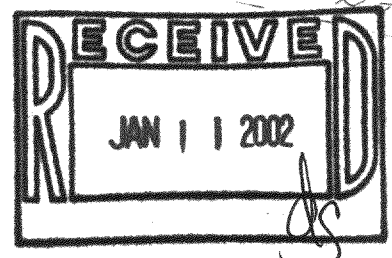


"RECERTIFICATION"
Plat of Survey


Survey For: WOLTER BROS. BUILDERS
 Location: LAKESHORE AVE.

DEAVERS

Description: UNIT 11 LAUDERDALE LAKES ESTATES, CONDOMINIUM, ADDENDUM NO. 1, located in part of the S.E. 1/4 and S.W. 1/4 of the N.E. 1/4 and part of the N.W. 1/4 of the S.E. 1/4 of Section 1, Town 3 North, Range 16 East, Town of Sugar Creek, Walworth County, Wisconsin.

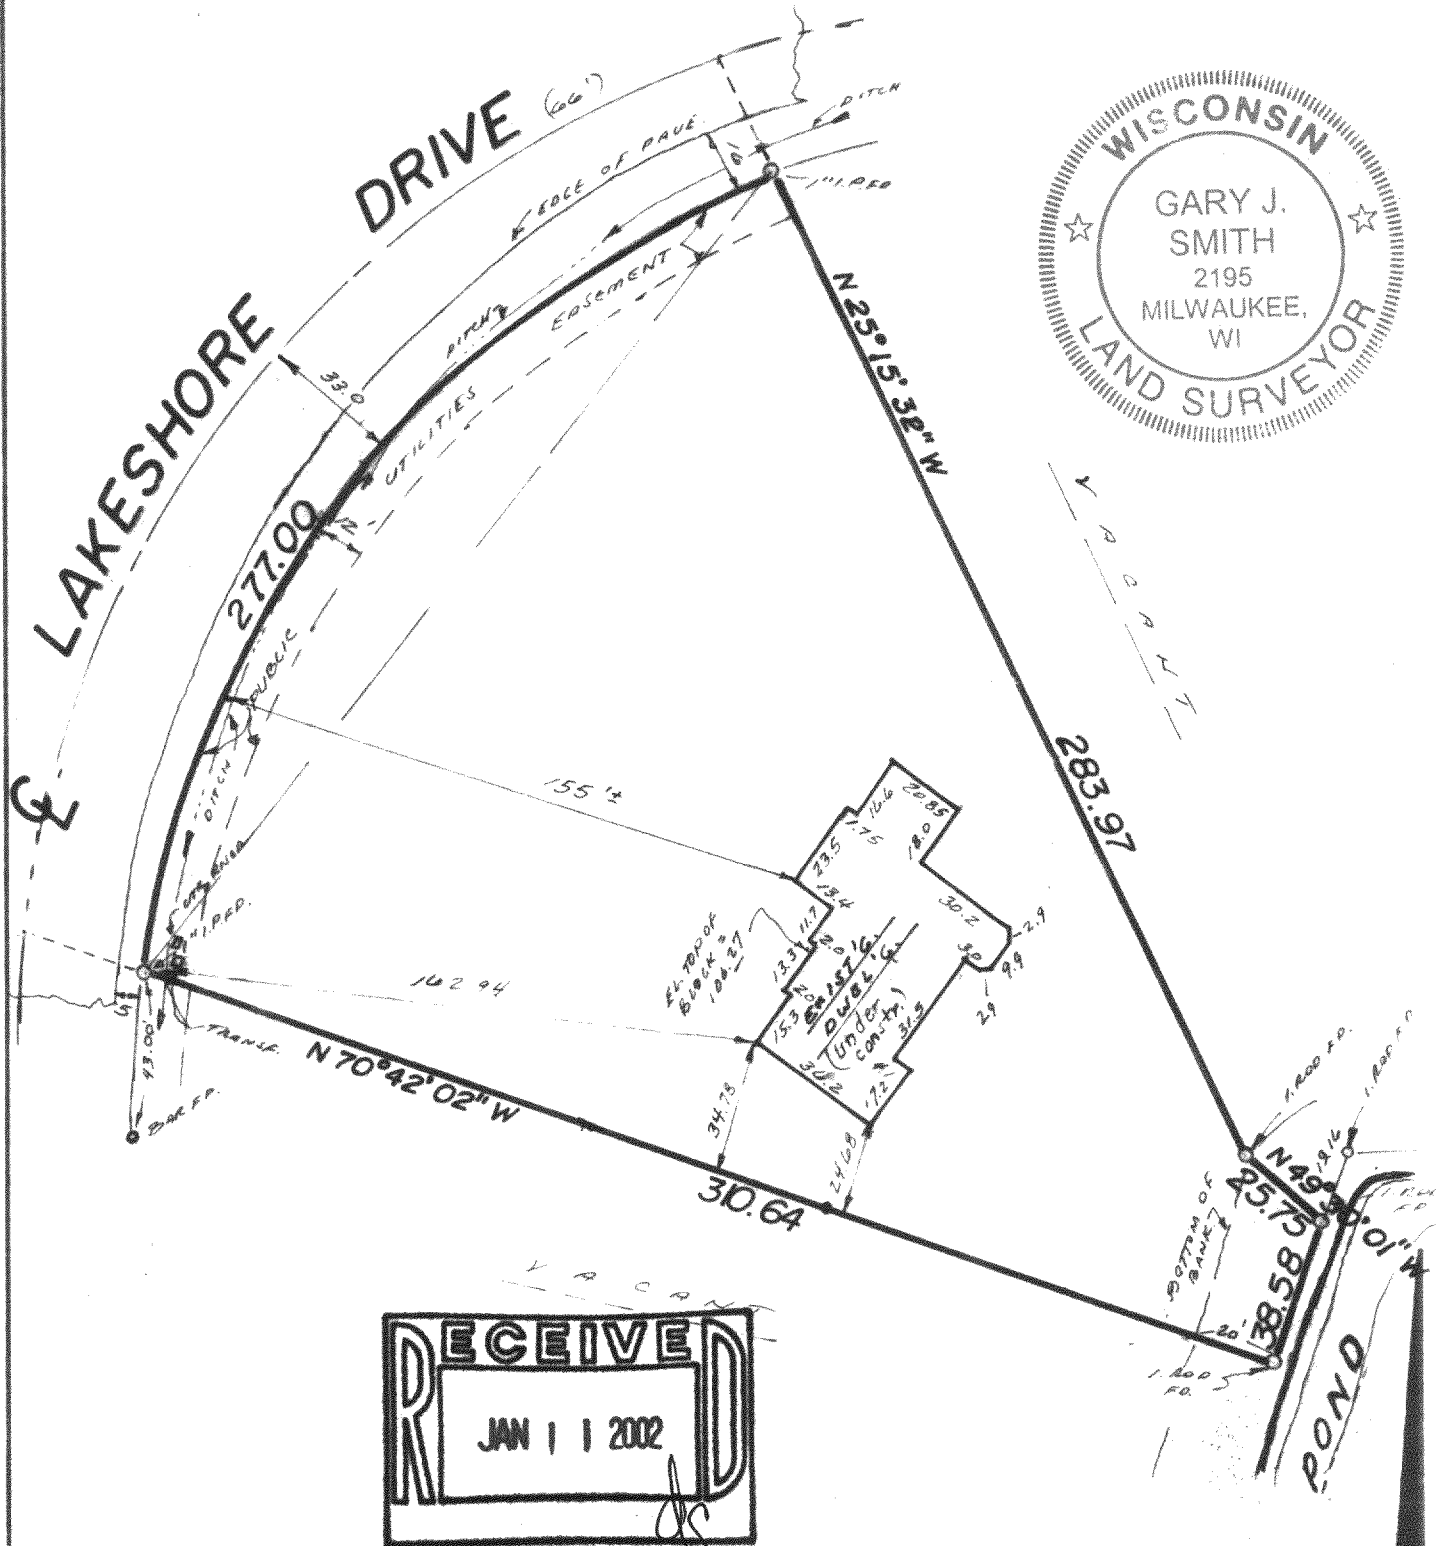

CURVE DATA
 $\Delta = 59^{\circ}26'30''$
 RAD. = 267.00
 CHD. = 264.74
 BAC. = N. $38^{\circ}21'52''$ E.

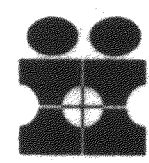

INTERLINE SURVEY SERVICES, INC.
 11221 W. FOREST HOME AVE
 FRANKLIN, WISCONSIN 53132
 PHONE 425-2060

SURVEY CERTIFICATE

Scale: 1" = 50'

State of Wisconsin) ss
 Milwaukee County

We, Interline Survey Services, Inc., certify that we have surveyed the above described property and the above map is a true representation thereof, and shows the size and location of the property, its exterior boundaries, the location and dimensions of all visible structures thereon, fences, apparent easements and roadways and visible encroachments, if any.

This survey is made for the exclusive use of the present owners of the Property, and also those who purchase, mortgage, or guarantee the title thereto, within one (1) year from date hereof.

Gary J. Smith
 Wisconsin Registered Land Surveyor

Date: 8/14/01
 Job No.: 28367

NO14879

611E1-71 316-1342



Plat of Survey

Survey For: WOLTER BROS. BUILDERS
Location: LAKESHORE AVE.


DEAVERS

Description: UNIT 11 LAUDERDALE LAKES ESTATES, CONDOMINIUM, ADDENDUM NO. 1, located in part of the S.E. 1/4 and S.W. 1/4 of the N.E. 1/4 and part of the N.W. 1/4 of the S.E. 1/4 of Section 1, Town 3 North, Range 16 East, Town of Sugar Creek, Walworth County, Wisconsin.


SUGGESTED FINISHED
YARD GRADE = 105.5
(12 CAS.)
LOWER LEVEL = 97.8

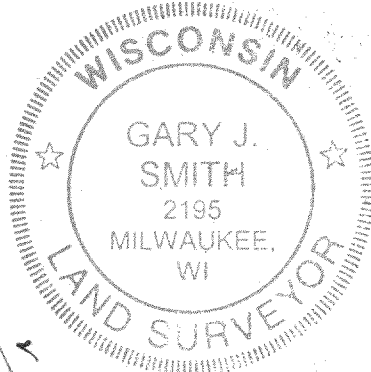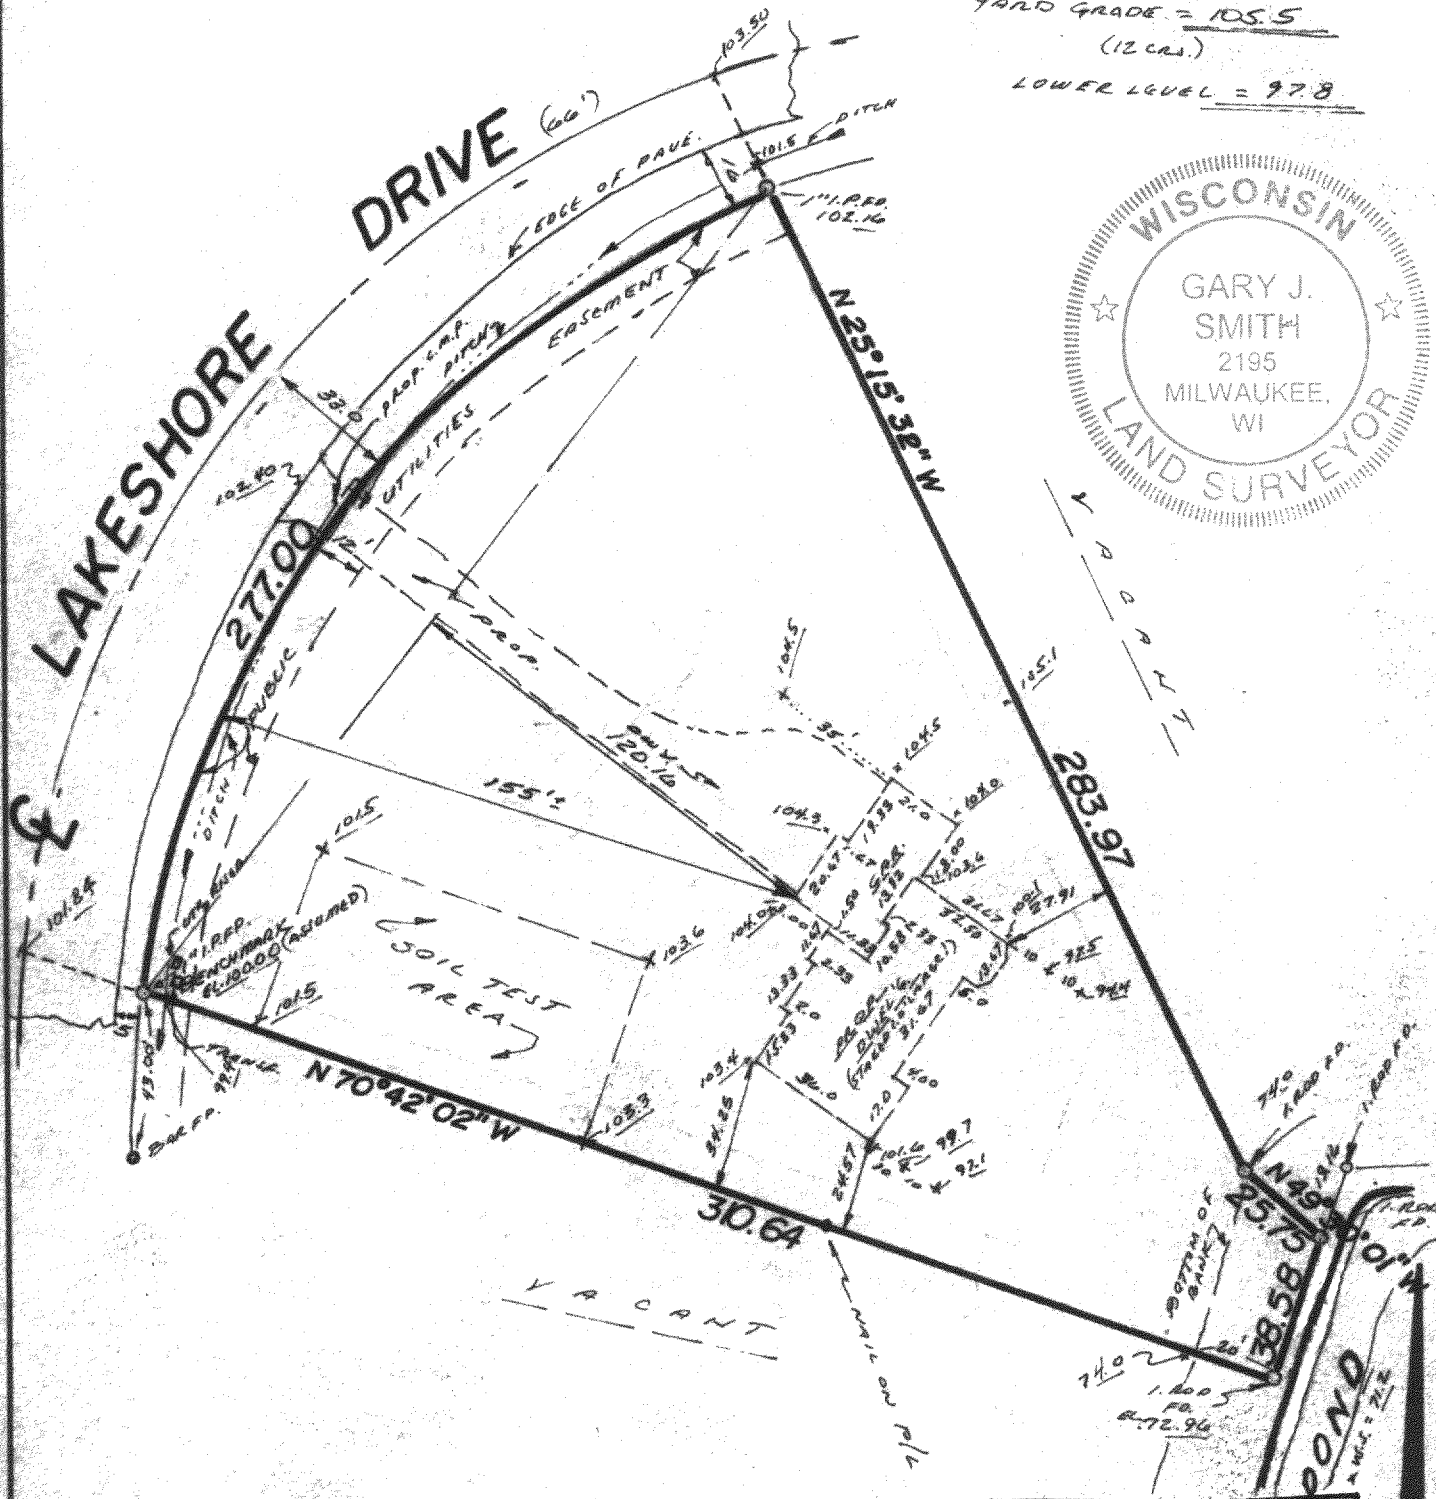

CURVE DATA
 $\Delta = 59^{\circ}26'30''$
 RAD. = 267.00
 CHD. = 264.74
 BRG. = N. 38° 21' 52" E.

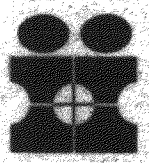

INTERLINE SURVEY SERVICES, INC.
 11221 W. FOREST HOME AVE
 FRANKLIN, WISCONSIN 53132
 PHONE 425-2060

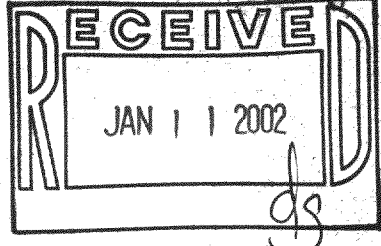

Scale: 1" = 50'

State of Wisconsin) ss
Milwaukee County

SURVEY CERTIFICATE

We, Interline Survey Services, Inc., certify that we have surveyed the above described property and the above map is a true representation thereof, and shows the size and location of the property, its exterior boundaries, the location and dimensions of all visible structures thereon, fences, apparent easements and roadways and visible encroachments, if any.

This survey is made for the exclusive use of the present owners of the Property, and also those who purchase, mortgage, or guarantee the title thereto, within one (1) year from date hereof.

Gary J. Smith
 Wisconsin Registered Land Surveyor

Date: 5/16/01
 Job No.: 28208