
PREPARED FOR: MICHAEL & ROANNE BEETS C/O COLDWELL BANKERS PRIMUS 226 BROAD STREET LAKE GENEVA WI 53147

PLAT OF SURVEY

I.K. SURVEYING INC. N3705 WILLOWBEND LANE LAKE GENEVA, WI, 53147 262-248-3697

LOTS 17 - 19 AND 42 - 45, BLOCK N, NORTH LAKE BEACH TRACT NO. 2. LOCATED IN TOWN 3 NORTH, RANGE 16 EAST, WALWORTH COUNTY, WISCONSIN.



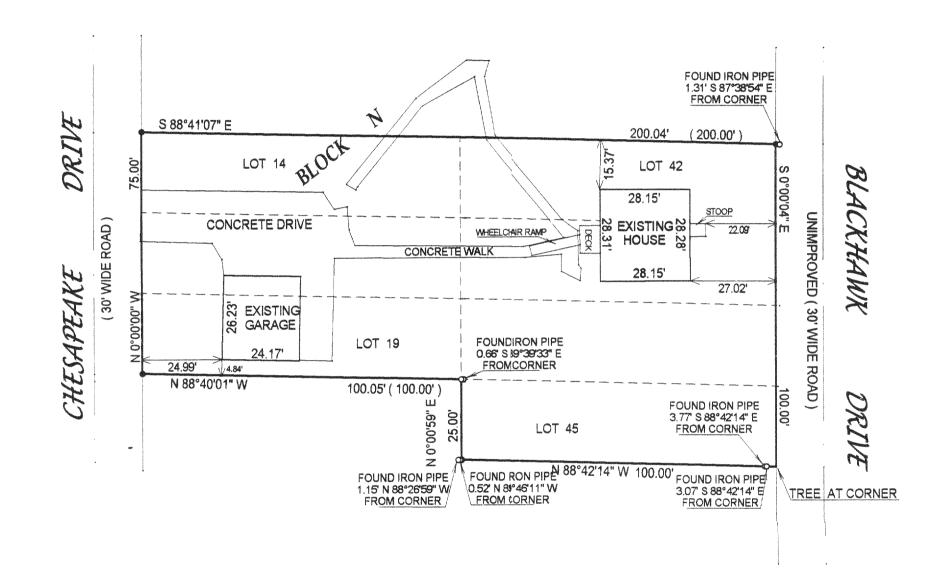



JOHN KROTT S - 2258 Wisconsin Registered Land Surveyor

(original if signed in red)

COMPARE LEGAL DESCRIPTION ABOVE AND DRAWING WITH DEED. FOR BUILDING RESTRICTIONS AND EASEMENTS NOT SHOWN, REFER TO DEED, ABSTRACT SOURCES AND LOCAL MUNICIPAL CODES. NOTIFY THE SURVEYOR IMMEDIATELY OF ANY DISCREPANCY. = set iron bar

"I hereby certify that I have surveyed the above described property and that the above map is a true representation thereof and shows the size and JOB #02-180 location of all visible structures, apparent easements and encroachments

> This survey is made for the present owners of the property, and those who purchase, mortgage, or guarantee the title thereto, within one year from the date hereof. DATED THIS THE 1ST DAY OF MAY 2002.

SCALE 1" = 30'

()= recorded as

= found iron bar

= found iron pipe

= set iron pipe

TAX/ID # GNLB200189&197

NOTE: BEARINGS ARE ASSUMED