

GI-268B1

Plat of Survey


A parcel of land described in a Warranty Deed recorded in Vol. 390 on Page 622 as Document No. 140986 as shown below:

Lots 14, 15, 16 and 17 of Block 26 excepting: Commencing at the SE corner of Block 26; thence N 29°56'11" West 152.05 feet to the place of beginning; thence continue N 29°56'11" West 25.00 feet; thence S 60°03'49" West 100.00 feet; thence S 2°13'45" West 29.53 feet; thence N 60°03'49" East 115.52 feet to the place of beginning all in Interlaken Subdivision located in the Township of Sugar Creek, Walworth County, Wisconsin.


A parcel of land described in a Warranty Deed recorded as Document No. 483312 as shown below:

A parcel of land located in Lot 13 of Block 26 of Interlaken 3rd Map, a subdivision located in the Northeast 1/4 of Section 11, Town 3 North, Range 16 East, Town of Sugar Creek, Walworth County, Wisconsin, described as follows: Commence at the Southeast Corner of said Block 26; thence North 87°46'15" West, along the North line of Rosewood Road, 178.71 feet to an iron pipe at the Southeast Corner of said Lot 13 and the Point of Beginning; thence continue North 87°46'15" West, along said North line, 19.00 feet to an iron rod; thence North 17°49'54" West 48.16 feet to an iron rod; thence North 80°10'26" East 42.00 feet to an iron pipe on the East line of said Lot 13; thence South 2°17'35" West, along said East line, 67.53 feet to the Point of Beginning.



Surveyed for: **Dave Stohl**
N6727 University Road
Elkhorn, Wisconsin, 53121

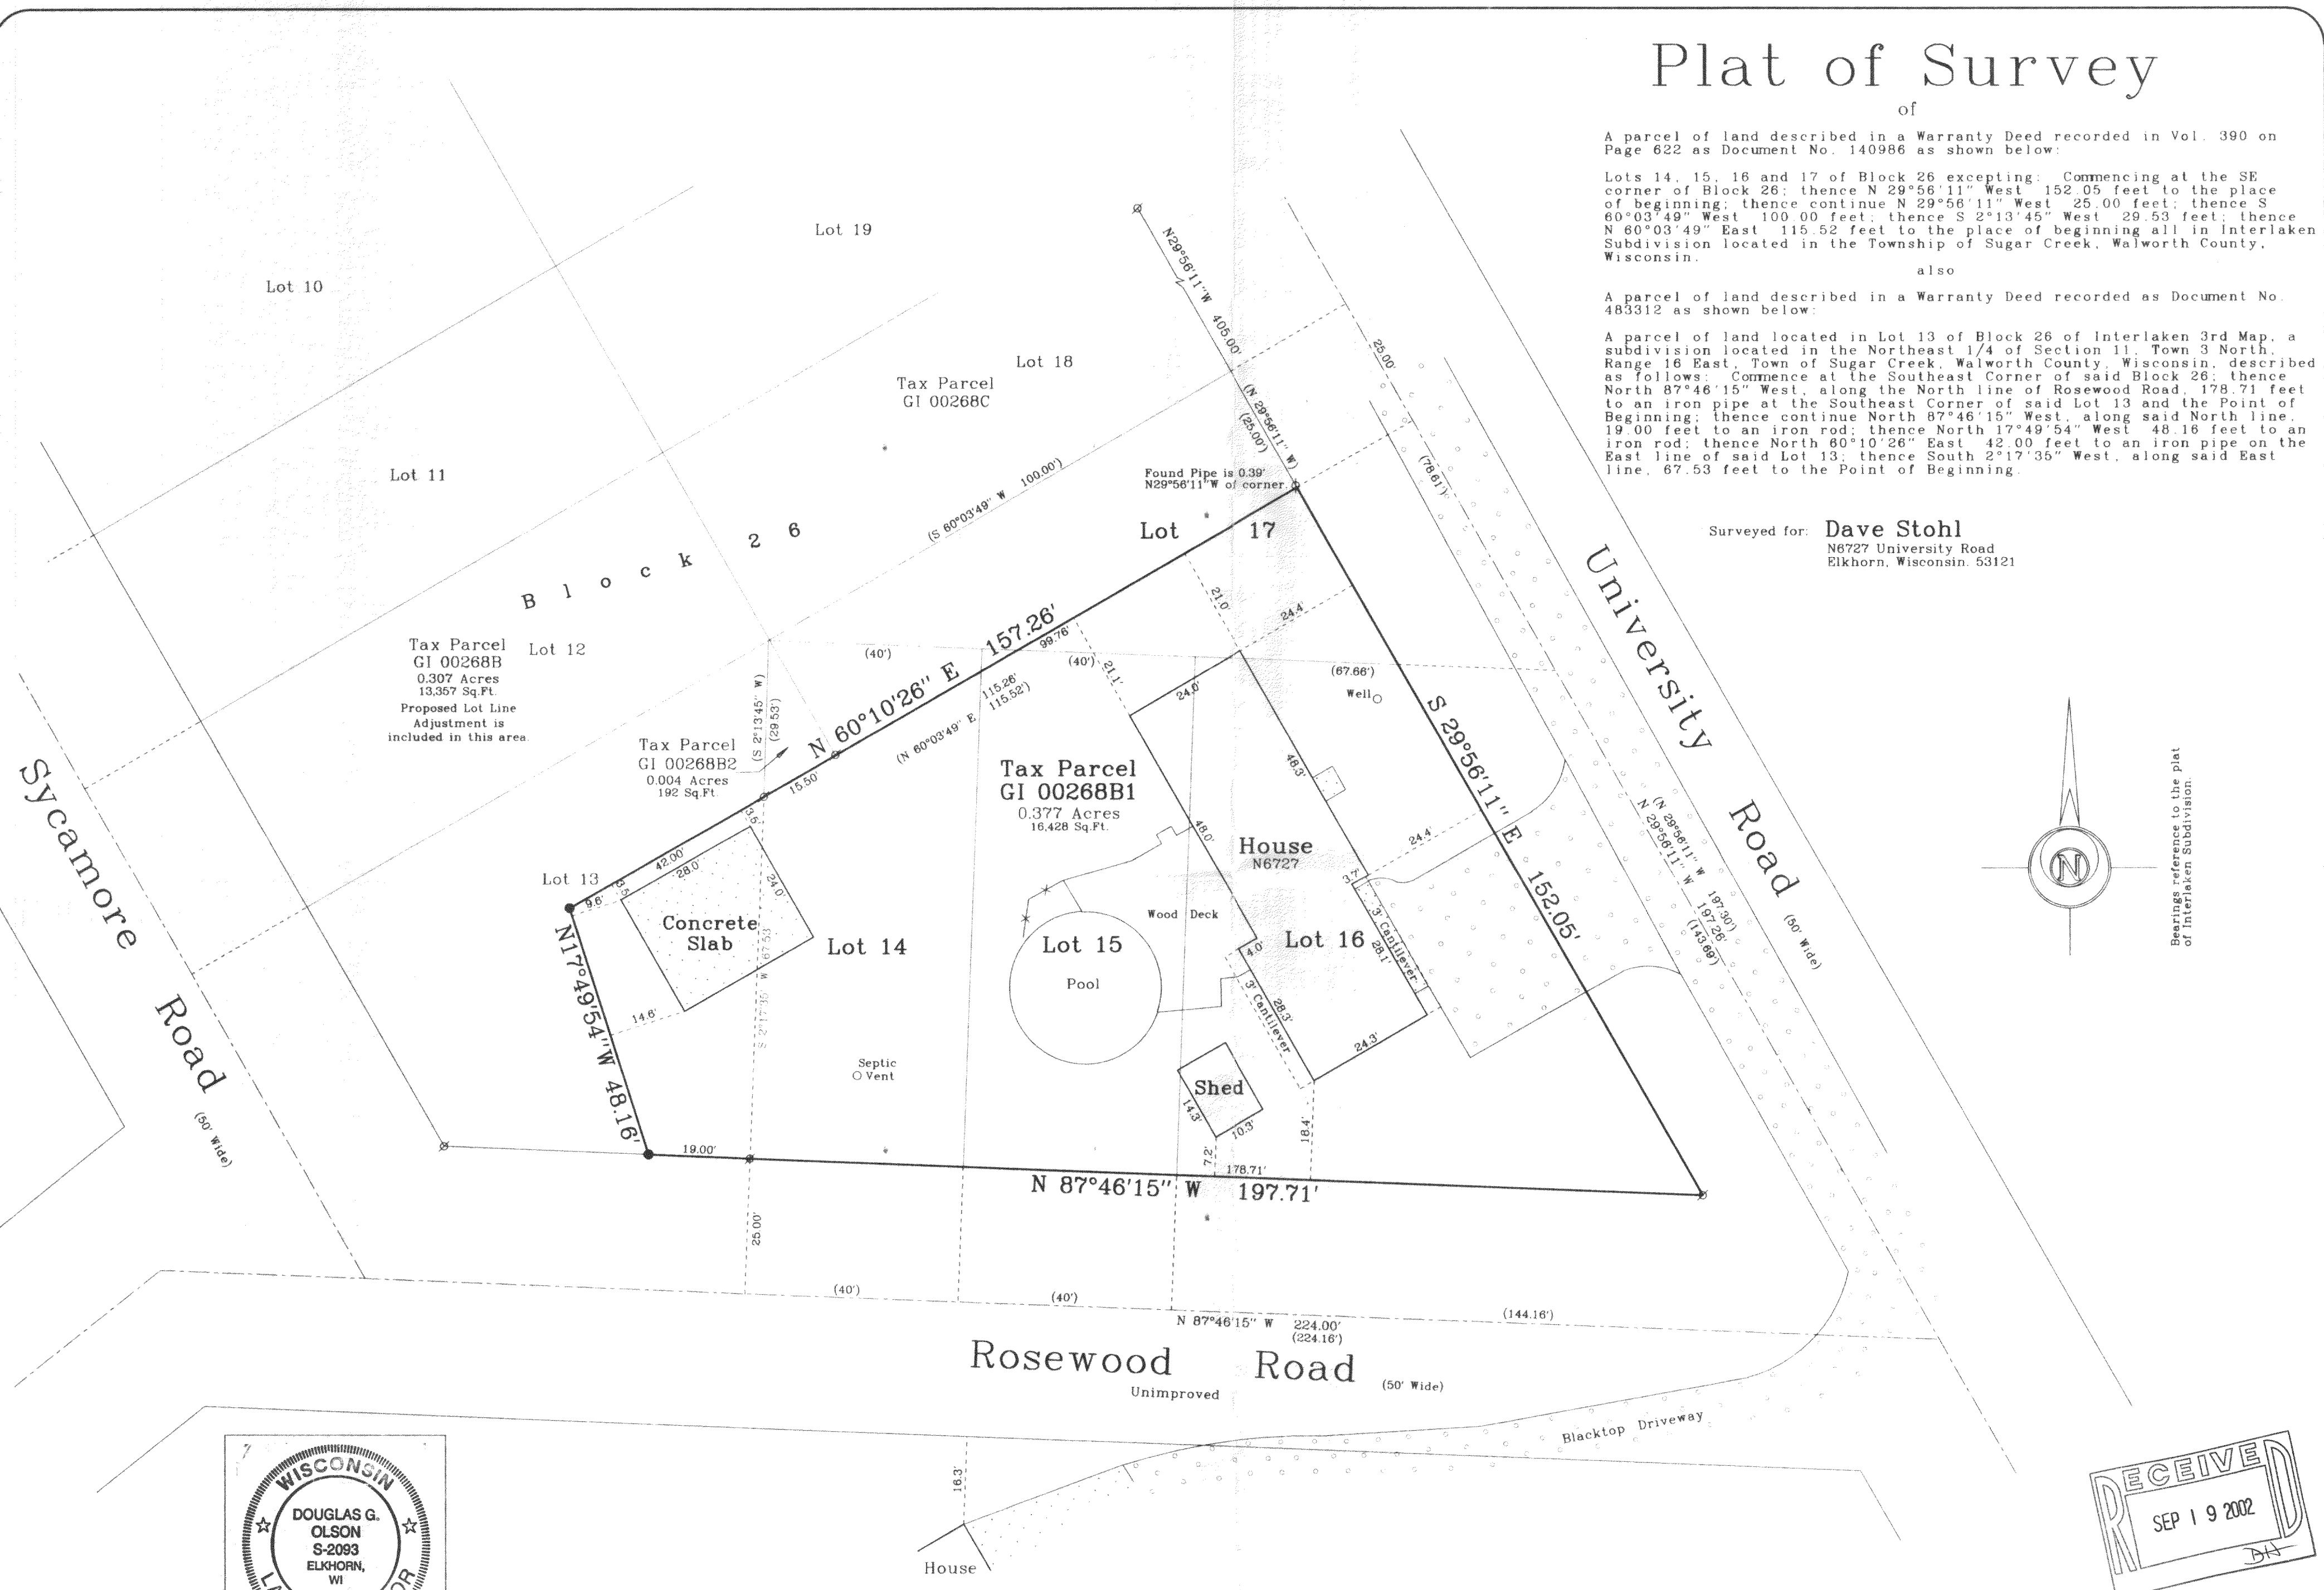

Survey Date: December 11, 2001
Revisions:

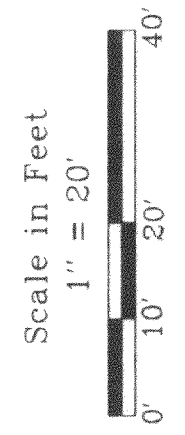

Jensen & Olson Land Surveying, LLC
45 South Wisconsin Street
Elkhorn, Wisconsin, 53121
P.O. Box 322
Telephone (262) 723-3434
Facsimile (262) 723-8044

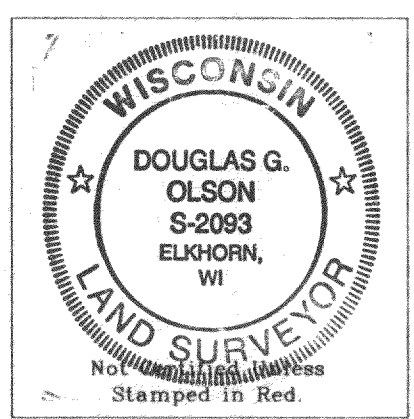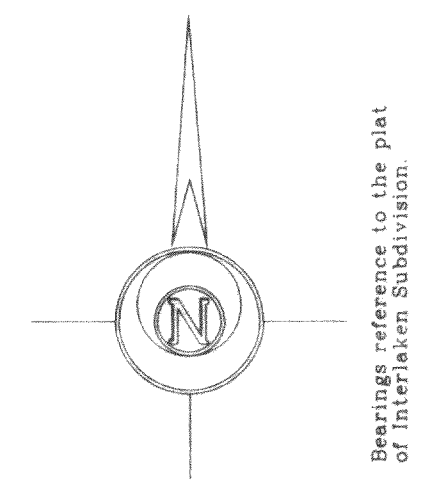

Notes: 1) This survey plat is not certified unless signed and sealed in red ink.
2) This survey is subject to Wisconsin lien laws. This Plat of Survey is the notice of intent to file lien. Lien waiver required.

Copyright © 2001 by Jensen & Olson Land Surveying, LLC.
All rights reserved. No part of this survey plat may be reproduced or transmitted in any form by any means - graphic, electronic, or mechanical, including photocopying, tracing, or information storage and retrieval systems - without permission in writing from Douglas G. Olson, Jensen & Olson Land Surveying, LLC.

I, Douglas G. Olson, Wisconsin Registered Land Surveyor, do hereby certify that this survey was performed by me or under my direction in full compliance with the owner's/agent's instructions and Chapter A-E 7 of the Wisconsin Administrative Code "Minimum Standards for Property Surveys"; and that this map is an accurate representation thereof to the best of my knowledge and belief.

Douglas G. Olson
Wisconsin Registered Land Surveyor - 2093



Legend
⊗ Found Iron Pipe 3/4" dia.
○ Found Iron Rod
● Recorded information
▨ Concrete Surface
▩ Asphalt Surface

Sheet 1 of 1 Sheets
Job Reference Number 2001.177

2001.177

316-1409