


Plat of Survey

of

Lots 1 thru 11 of Block 6,
Lots 1 thru 16 of Block 7,
Lots 1 thru 12 of Block 8, &
Lots 1 thru 12 of Block 9,

all of Blue Wing Estates, a subdivision located in Section 5,
Town 3 North, Range 16 East, Town of Sugar Creek, Walworth
County, Wisconsin.

Surveyed for: **George A. Cutro @
Starck & Company**
300 West Golf Road
Mount Prospect, IL 60056

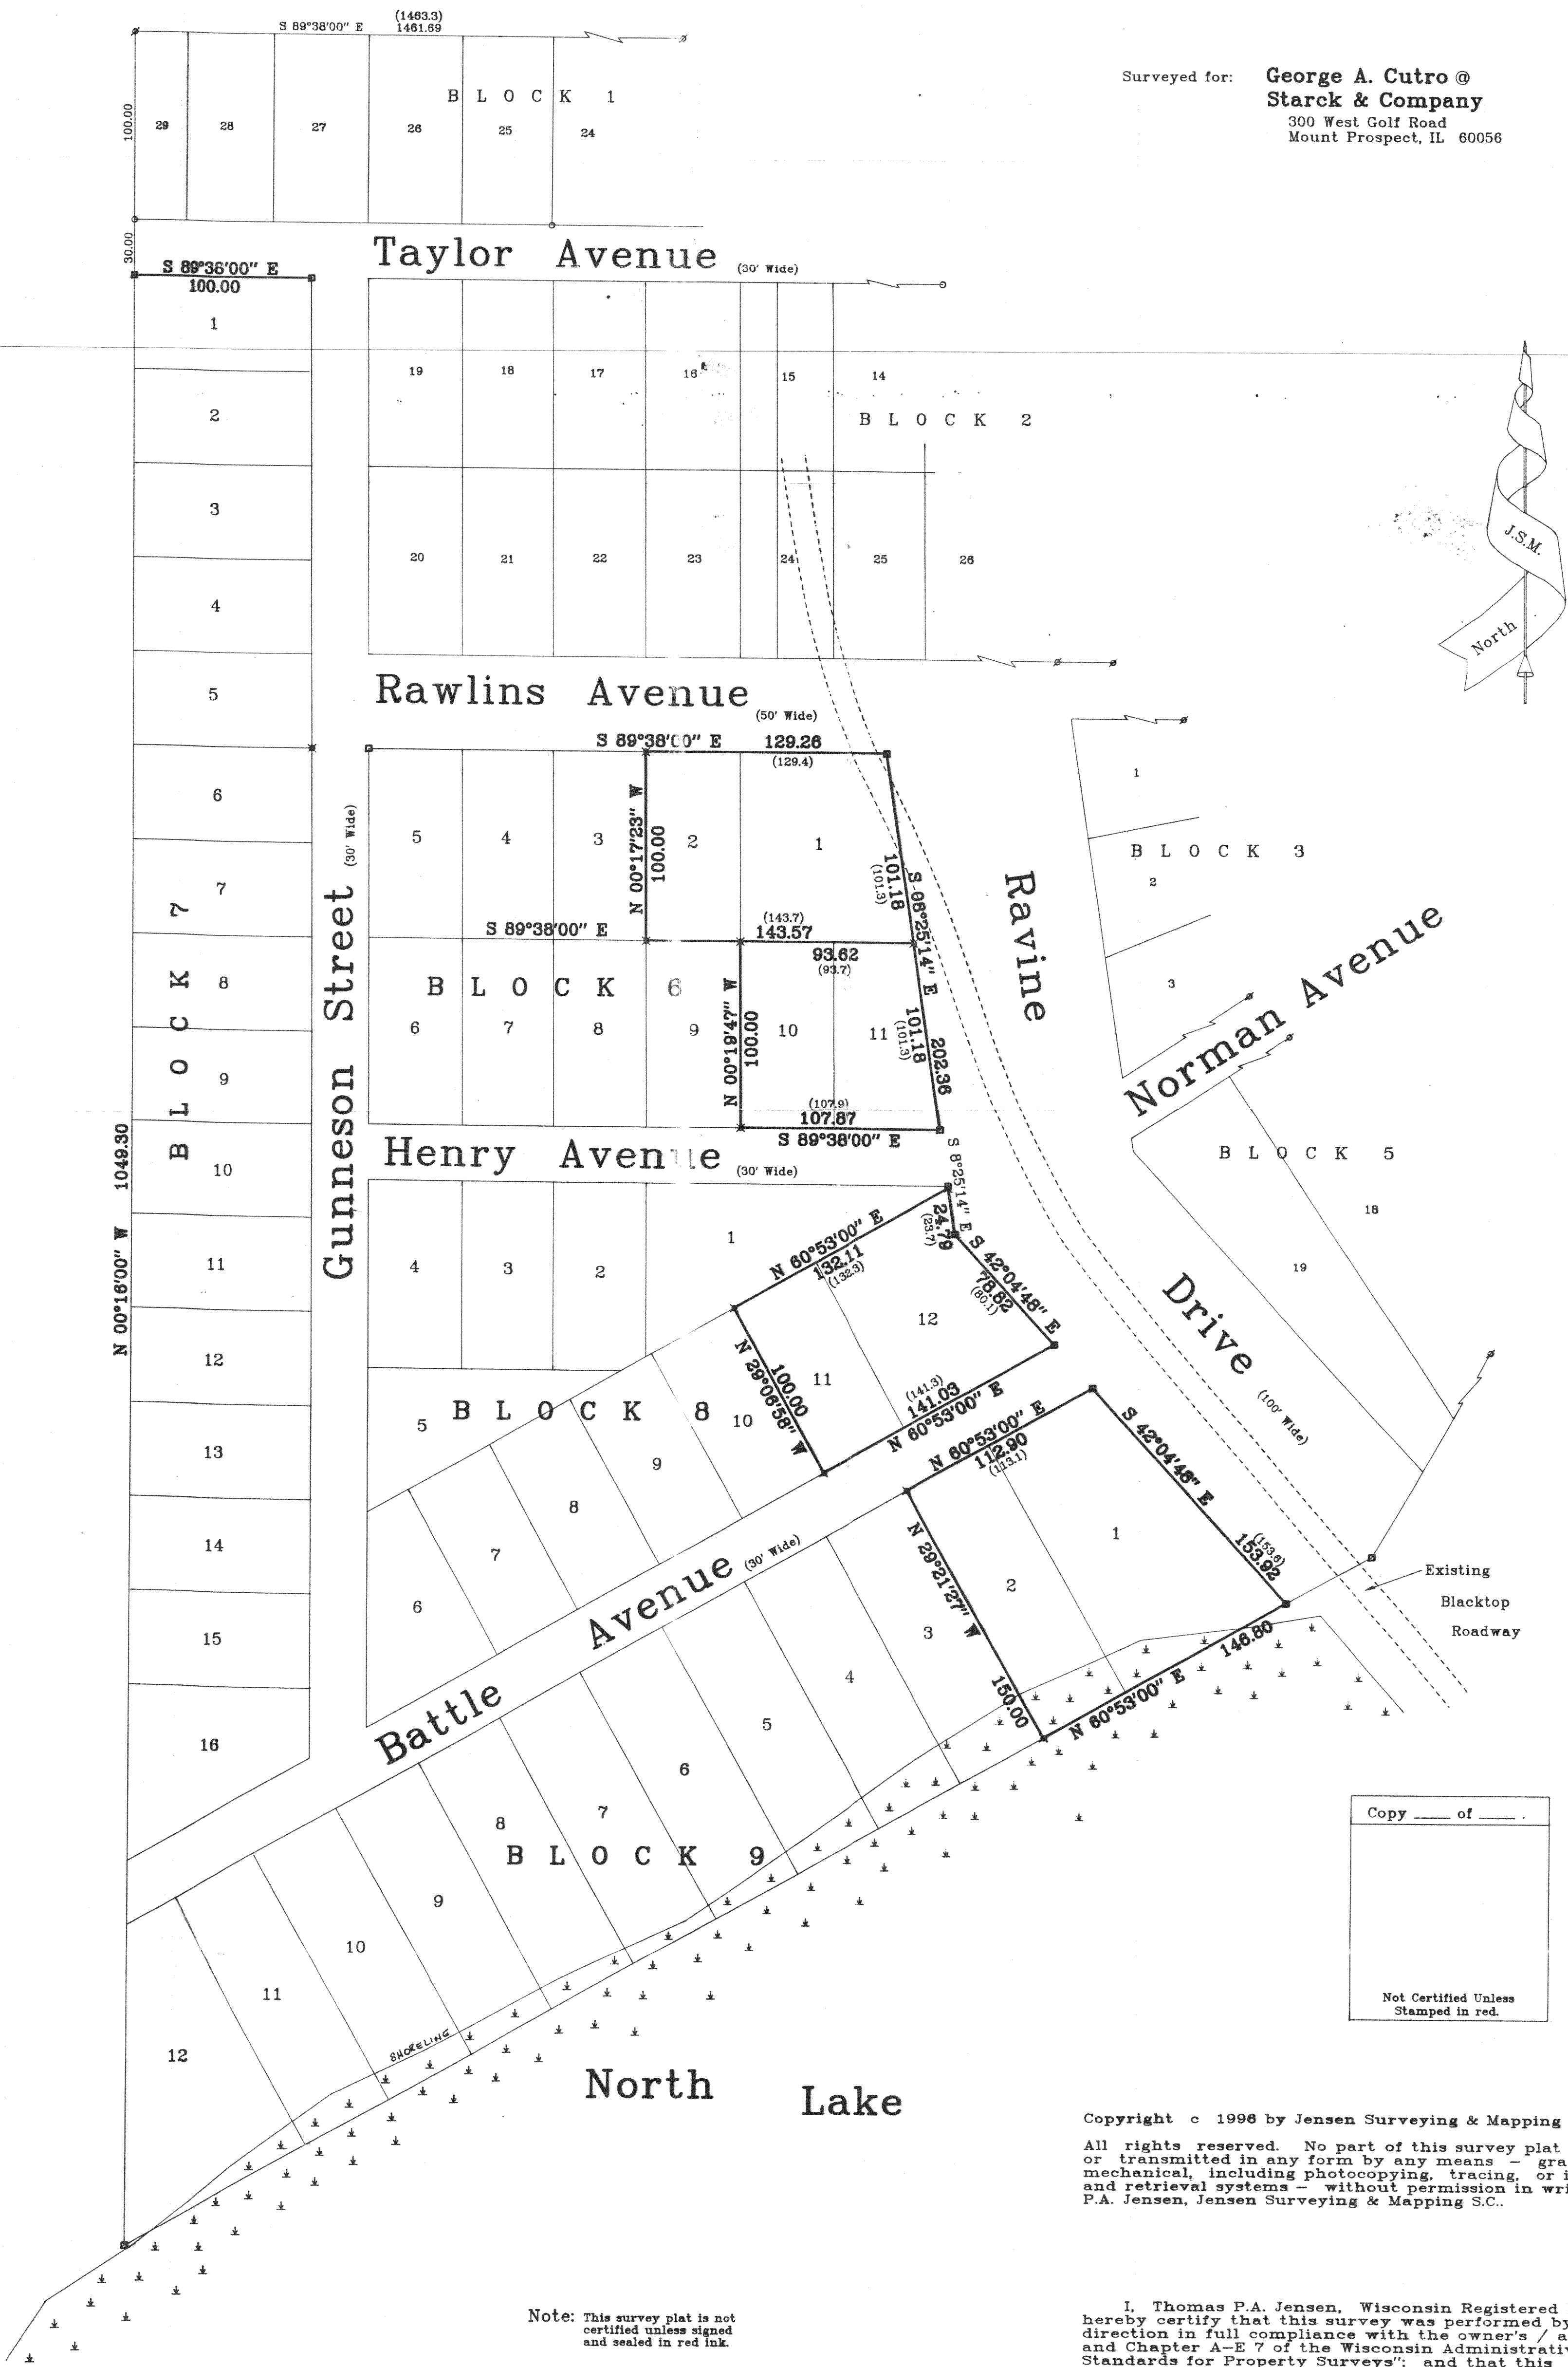

1996.023

Sheet 1 of 1 Sheets.

Job Reference Number
1996.023

Legend

- Found Iron Pipe
- Found Iron Rod
- Set Iron Rod, 1 3/16" dia.
- Set Iron Rod, 3/4" dia.
- Recorded Information
- Blacktop Surface

JENSEN SURVEYING & MAPPING S.C.

45 South Wisconsin Street P.O. Box 322
Elkhorn, Wisconsin. 53121
Telephone & Facsimile: (414) 723-3434

Scale in Feet

1"= 50'



Mapping date: April 9, 1996.

Revisions:

GBW-10
GBW-11
GBW-12
GBW-13

GBW-14
GBW-15
GBW-16
GBW-17

316-1452