ABERNATHY and ASSOCIATES

Kenneth B. Abernathy Jr.

W4056 BRAY RD. ELKHORN, WI. 53121

PHONE: (262) 723-4260 (OFFICE) (262) 723-7209 (FAX)

Wisconsin Registered Land Surveyor


NW CORNER BLK. 16


S-1594 Email: abernathy@elknet.net

SURVEY OF PLAT

THE NORTH 1/2 OF LOT 37 AND ALL OF LOTS 38 AND 39 OF BLOCK 16, INTERLAKEN SUBDIVISION, TOWN OF SUGAR CREEK, WALWORTH COUNTY, WISCONSIN.

NE CORNER BLK. 16

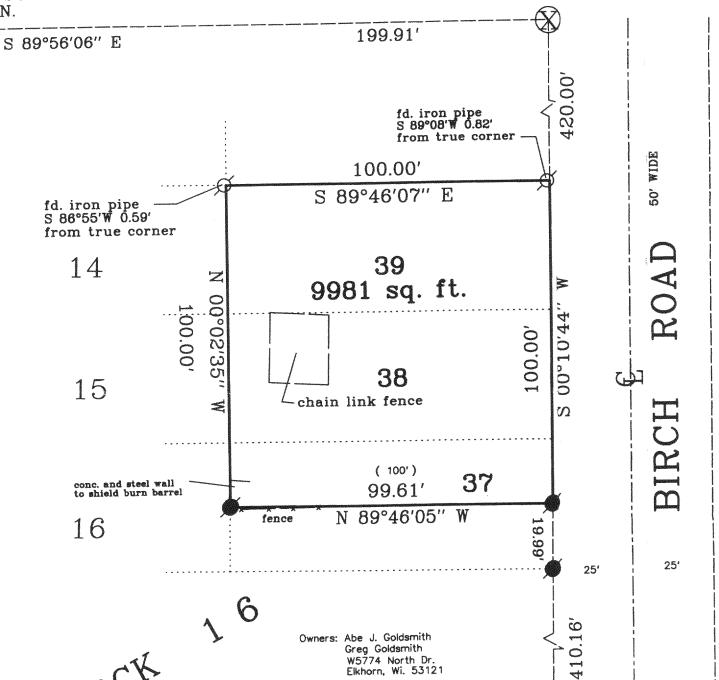

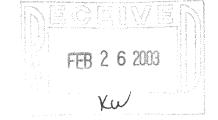

Legend

FOUND IRON PIPE

FOUND IRON ROD

FOUND BRASS CAPPED MONUMENT

FOUND CONCRETE MONUMENT

CHISEL CUT IN CONCRETE

SET IRON ROD, 24" LONG, WEIGHING 1.5 LBS./LINEAL FT., 3/4" DIA.

SET IRON ROD, 30" LONG, WEIGHING 4.5 LBS./LINEAL FT., 1-11/16" DIA.

RECORDED AS DIMENSION

Bearings are based on the west line of Birch Road asssumed to bear N 0°10'44"E

EXISTING FENCE

SCALE: $1'' = \frac{30}{100}$ FEET

"I hereby certify that the above described property has been surveyed by me or under my direction and that the above map is a true representation thereof and shows the size and location of the property, its exterior boundaries, the location of all visible structures and dimensions of all principal buildings thereon boundary fences apparent buildings thereon, boundary fences, apparent easements, roadways and visible encroachments,

"This survey is made for the use of the present owners of the property, and also those who purchase, mortgage, or guarantee the title thereto within one year from the date hereof."

KENNETH B. ABERNATHY, JR. WISCONSIN REGISTERED LAND SURVEYOR,

Date: Oct. 23,2002

